

SUBMITTAL TRANSMITAL

July 23, 2012 Submittal No: 13121-005.A

- PROJECT: Harold Thompson Regional WRF Birdsall Rd. Fountain, CO 80817 Job No. 2908
 - ENGINEER: GMS, Inc. 611 No. Weber St., #300 Colorado Springs, CO 80903 719-475-2935 Roger Sams
 - OWNER: Lower Fountain Metropolitan Sewage Disposal District 901 S. Santa Fe Ave. Fountain, CO 80817 719-382-5303 James Heckman
 - CONTRACTOR: Heath Steel 141 Racquette Dr Fort Collins, CO 80522 970-490-8031 Randy Gates rgates@heathsteel.com

SUBJECT: Revisions to Operations Building Anchor Rod Plans - Made on 7/19/12 - Anchor Bolt Pages A-1 & A-2 Have Been Revised

SPEC SECTION: 13121

PREVIOUS SUBMISSION DATES:

DEVIATIONS FROM SPEC: ____ YES X__ NO

CONTRACTOR'S STAMP: This submittal has been reviewed by Weaver Construction Management and, unless indicated otherwise, has been found to be in conformance with the intent of the contract documents.

| Contractor's Stamp: | Engineer's Stamp: |
|---|-------------------|
| Date: 7/23/12 | |
| Reviewed by: John Jacob | |
| (X) Reviewed Without Comments() Reviewed With Comments | |
| ENGINEER'S COMMENTS: | |



a division of Chief Industries, Inc. P.O. Box 2078 3942 W. Old Highway 30 Grand Island, NE 68802-2078 Phone (308) 389-7200 FAX (308) 389-7370

7/19/2012

Heath Steel 141 Racquette Drive PO Drawer H Fort Collins, CO 80522 Attn: Randy Gates

Re: B3004915 / Weaver Construction Management/Lower Fountain Metro Sewage

For Construction

Drawings or items included are as follows:

| No. of Sets | Revision | Latest Revision Date | Description |
|----------------|----------|-------------------------|-----------------------------------|
| | | | |
| 3 | 1 | 07.19.2012 | Complete Sets of Anchor Rod Plane |

Complete Sets of Anchor Rod Plans

ANCHOR BOLT PAGES A1 & A2 HAVE BEEN REVISED.

For questions concerning this mailing, contact:

Shawn Springer P.O. Box 2078 3942 W. Old Highway 30 Grand Island, NE 68802-2078 Phone: (308) 385-4632 E-mail: shawn.springer@chiefind.com

| | | | | Z | | | |
|--|---|-----------------------------------|--|---------------|--|--|--|
| Transmittal Sheet Information | | | | | | | |
| Date: 7-19-1 | 2 | ESR | <u>`</u> | Rob | ert H | | |
| Job Number | : <u>B3004915</u> | Cust | nber: comer: <u>Ue</u> | aver | - Const. Management | | |
| Builder: | Heath St | eel | ······································ | . | State: <u>CO</u> | | |
| | | n Date: <u>デー/こ</u> Revised | | | | | |
| Anchor Bolt Plan | , | AZ | | No. (Print | sets to go out: Z room add additional sets as required) | | |
| Building Drawings | · | | | | GI/30 RN/31 | | |
| Delivery Address for Drawings (must always be provided) No P.O. Box on UPS or FedEx Addresses please Special Mail Instructions / Comments | | | | | | | |
| 141 Racque Fort Collins | tte Drive | | | | | | |
| | <u>,</u> | | | | | | |
| | ndy Gates must be provided) | | | | · · · · · · · · · · · · · · · · · · · | | |
| | Please | circle | our selections | | | | |
| - · · · · | | J | ob Requirement | ts | Shipping Information | | |
| Project Manager Baldwin | Job Type Construction | | For Construction On Incial Trim | 11y) | Shipping mornation | | |
| Clingenpeel | Permit | ` | cial Plates | | Fed Ex | | |
| Lautenschlager | Approval | | cial Angle | | Fed Ex # to Charge | | |
| (Martinez) | | | de in U.S.A. | | U.S. Mail | | |
| Pikop | Letter of Certification | | Letter 4 | | | | |
| Springer | Design Calculations | LTC | Roof | | UPS | | |
| Tasich | | STO | Roof | | Fax Number | | |
| Zabka | | MS | C Roof | | | | |
| Van Horn | | M١ | F/MVP Roof | | UPS Confirmation e-mail address | | |
| | | No | Frames | | | | |
| Final C | esign Drawings | | Fabs | | | | |
| Colorado Springs Submittal | | | sconsin | | | | |
| | Permit Use Only) | 1 | coln | Qty | | | |
| | Denver Submittal | | pping Papers | L | | | |
| | uctural Plan Review) | | ime Fabs | | | | |
| | City, MO Submittal certificate and (1) AISC certificate) | IAS | i Header Sheet C | nly | | | |

.

ANCHOR ROD PLAN FINISHED FLOOR ELEVATION = 5411.00

BASE OF ALL COLUMNS AT ELEVATION = 5413.00 BASE OF FRAME OPENING JAMBS AT ELEVATION = 5413.00 UNLESS NOTED


REFERENCE NOTES:

- 1. ALL ANCHOR RODS INCLUDING NUTS AND WASHERS FOR SAME ARE NOT FURNISHED BY CHIEF BUILDINGS.
- 2. ANCHOR ROD MATERIAL SHALL CONFORM TO ASTM F1554 HAVING A YIELD OF 36 KSI OR GREATER.
- 3. ROD PROJECTIONS ARE RECOMMENDED MINIMUMS BASED ON THE BASE PLATE BEARING DIRECTLY ON THE CONCRETE PIER. IF THE BASE PLATE IS TO BEAR ON GROUT, THE ROD PROJECTION MUST BE INCREASED ACCORDINGLY.
- 4. CONCRETE SHALL HAVE A MINIMUM STRENGTH OF 3000 PSI.

5. ALL DRAWINGS ARE NOT TO SCALE.

| REVISI | ANCHOR RODS (BY OTHERS) | | |
|----------------------------|----------------------------|-------|------|
| 4 | PROJ | SIZE | QUAN |
| | 11/2" | 0-½"Ø | 20 |
| 3 | 2" | 0-¾"Ø | 20 |
| 2 | | | |
| 1 REVISED PER CHANGE ORDER | | | |



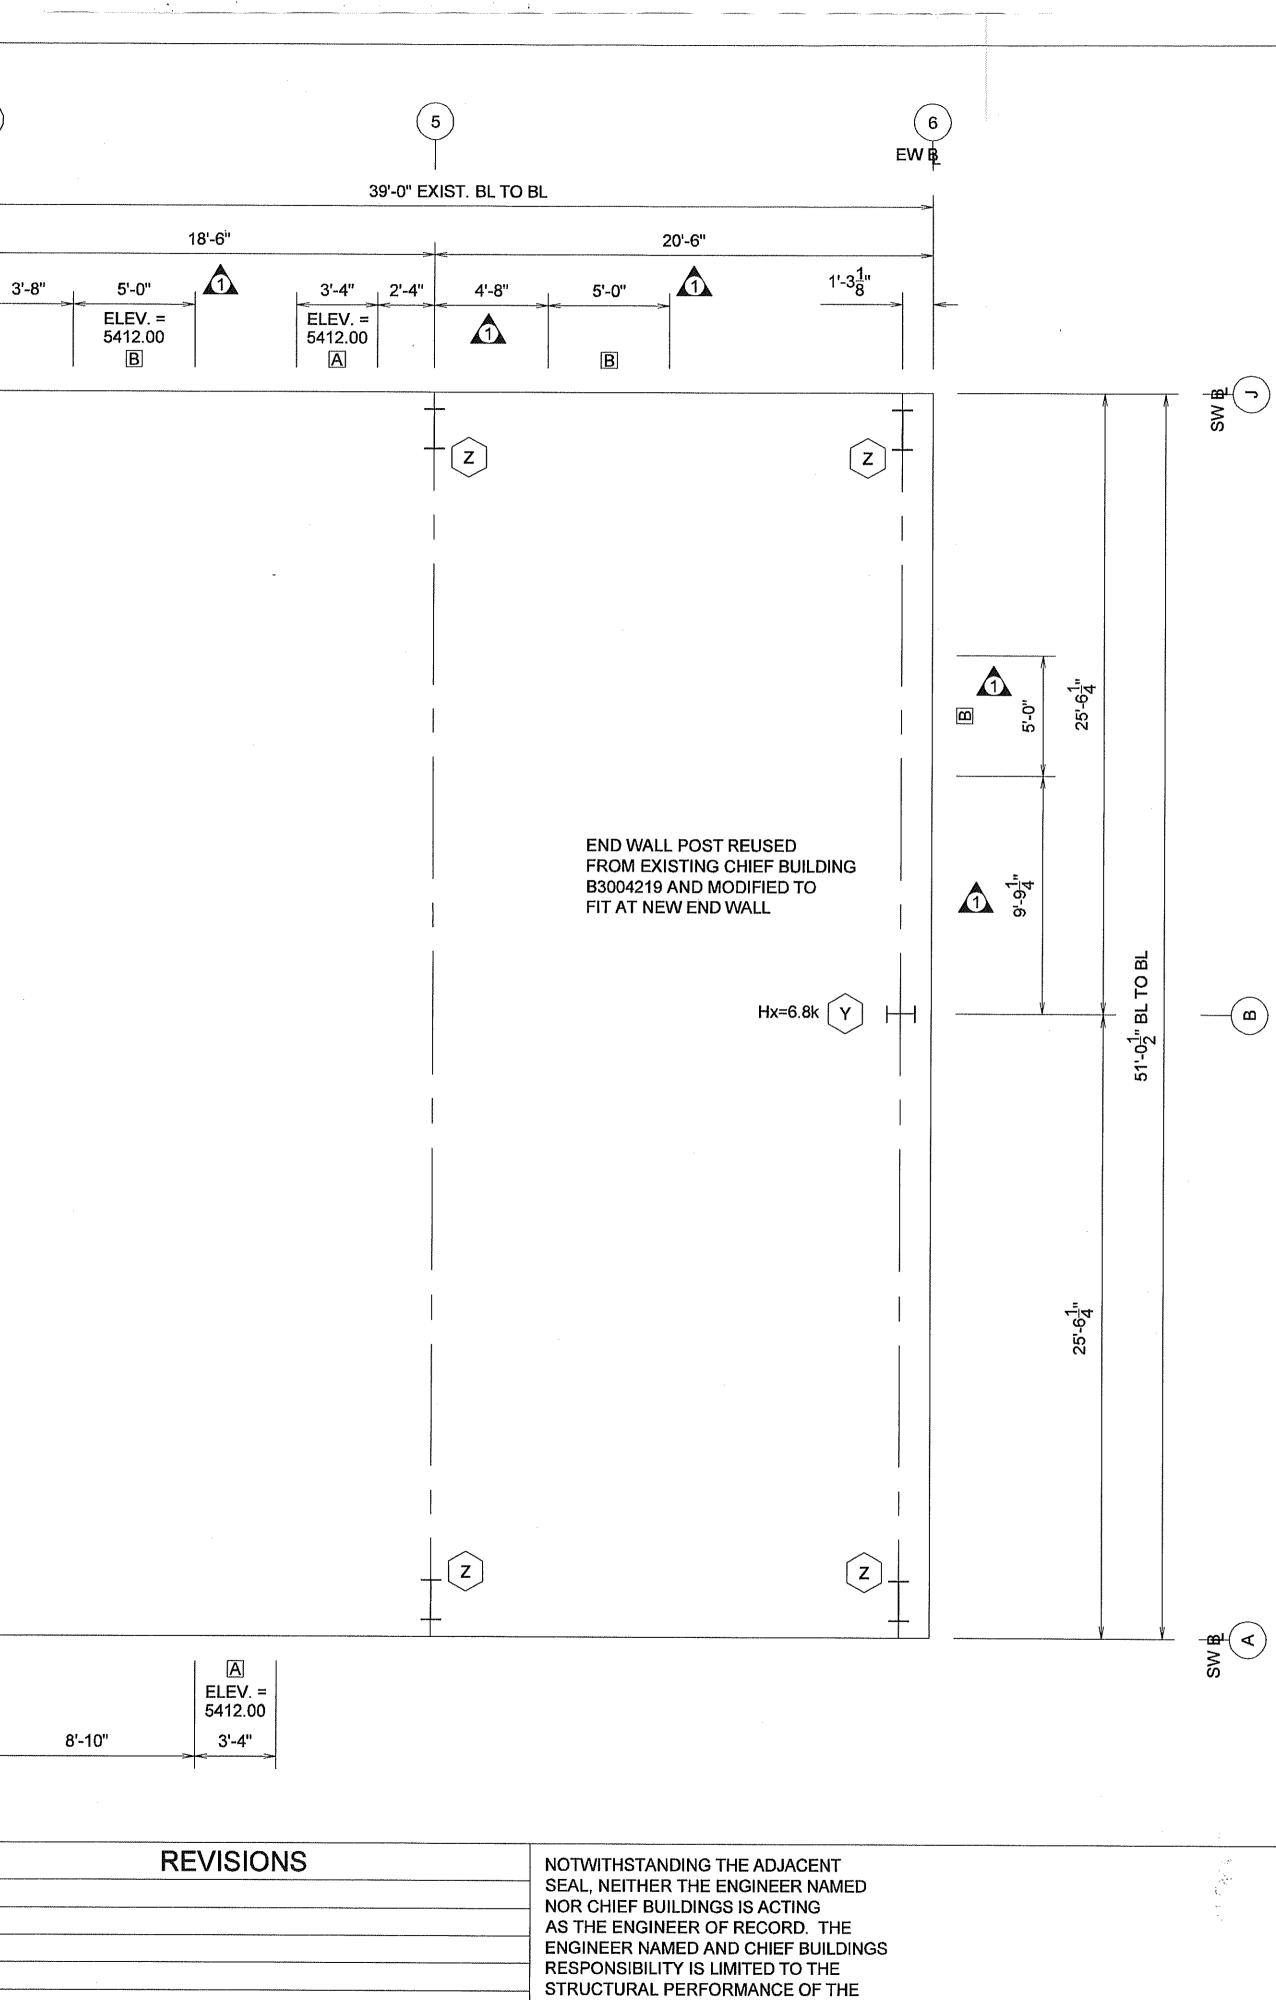


RFH 07-19-12

PRE-ENGINEERED COMPONENTS DESIGNED BY CHIEF BUILDINGS.

| ANCHOR ROD DI | RAWINGS | | | | | | |
|--|--------------|----------|-----------|---|--|--|--|
| HEATH STEEL / \ | WEAVER CC | NST. MA | NAGEMENT | With Marine and a second and a se | | | |
| FOUNTAIN, CO | | | | | | | |
| RF 51'-0 1/2"X39 | 'X19'-4" BAY | S VARY | 3:12 | | | | |
| CHIEF. | DRAWN | CHECK | ORDER NO. | A1 | | | |
| BUILDINGS | RFH | RS | D2004015 | | | | |
| a division of Chief Industries, Inc. GRAND ISLA 68802-2078 | | 06-08-12 | B3004915 | | | | |


ACCESSORY SCHEDULE MARK QUAN DESCRIPTION 3'-4" X 7'-4" WALK DOOR F.O. A 2 5'-0" X 3'-0" WINDOW F.O. 3 В 2 5'-0" X 0'-8" WINDOW F.O. C

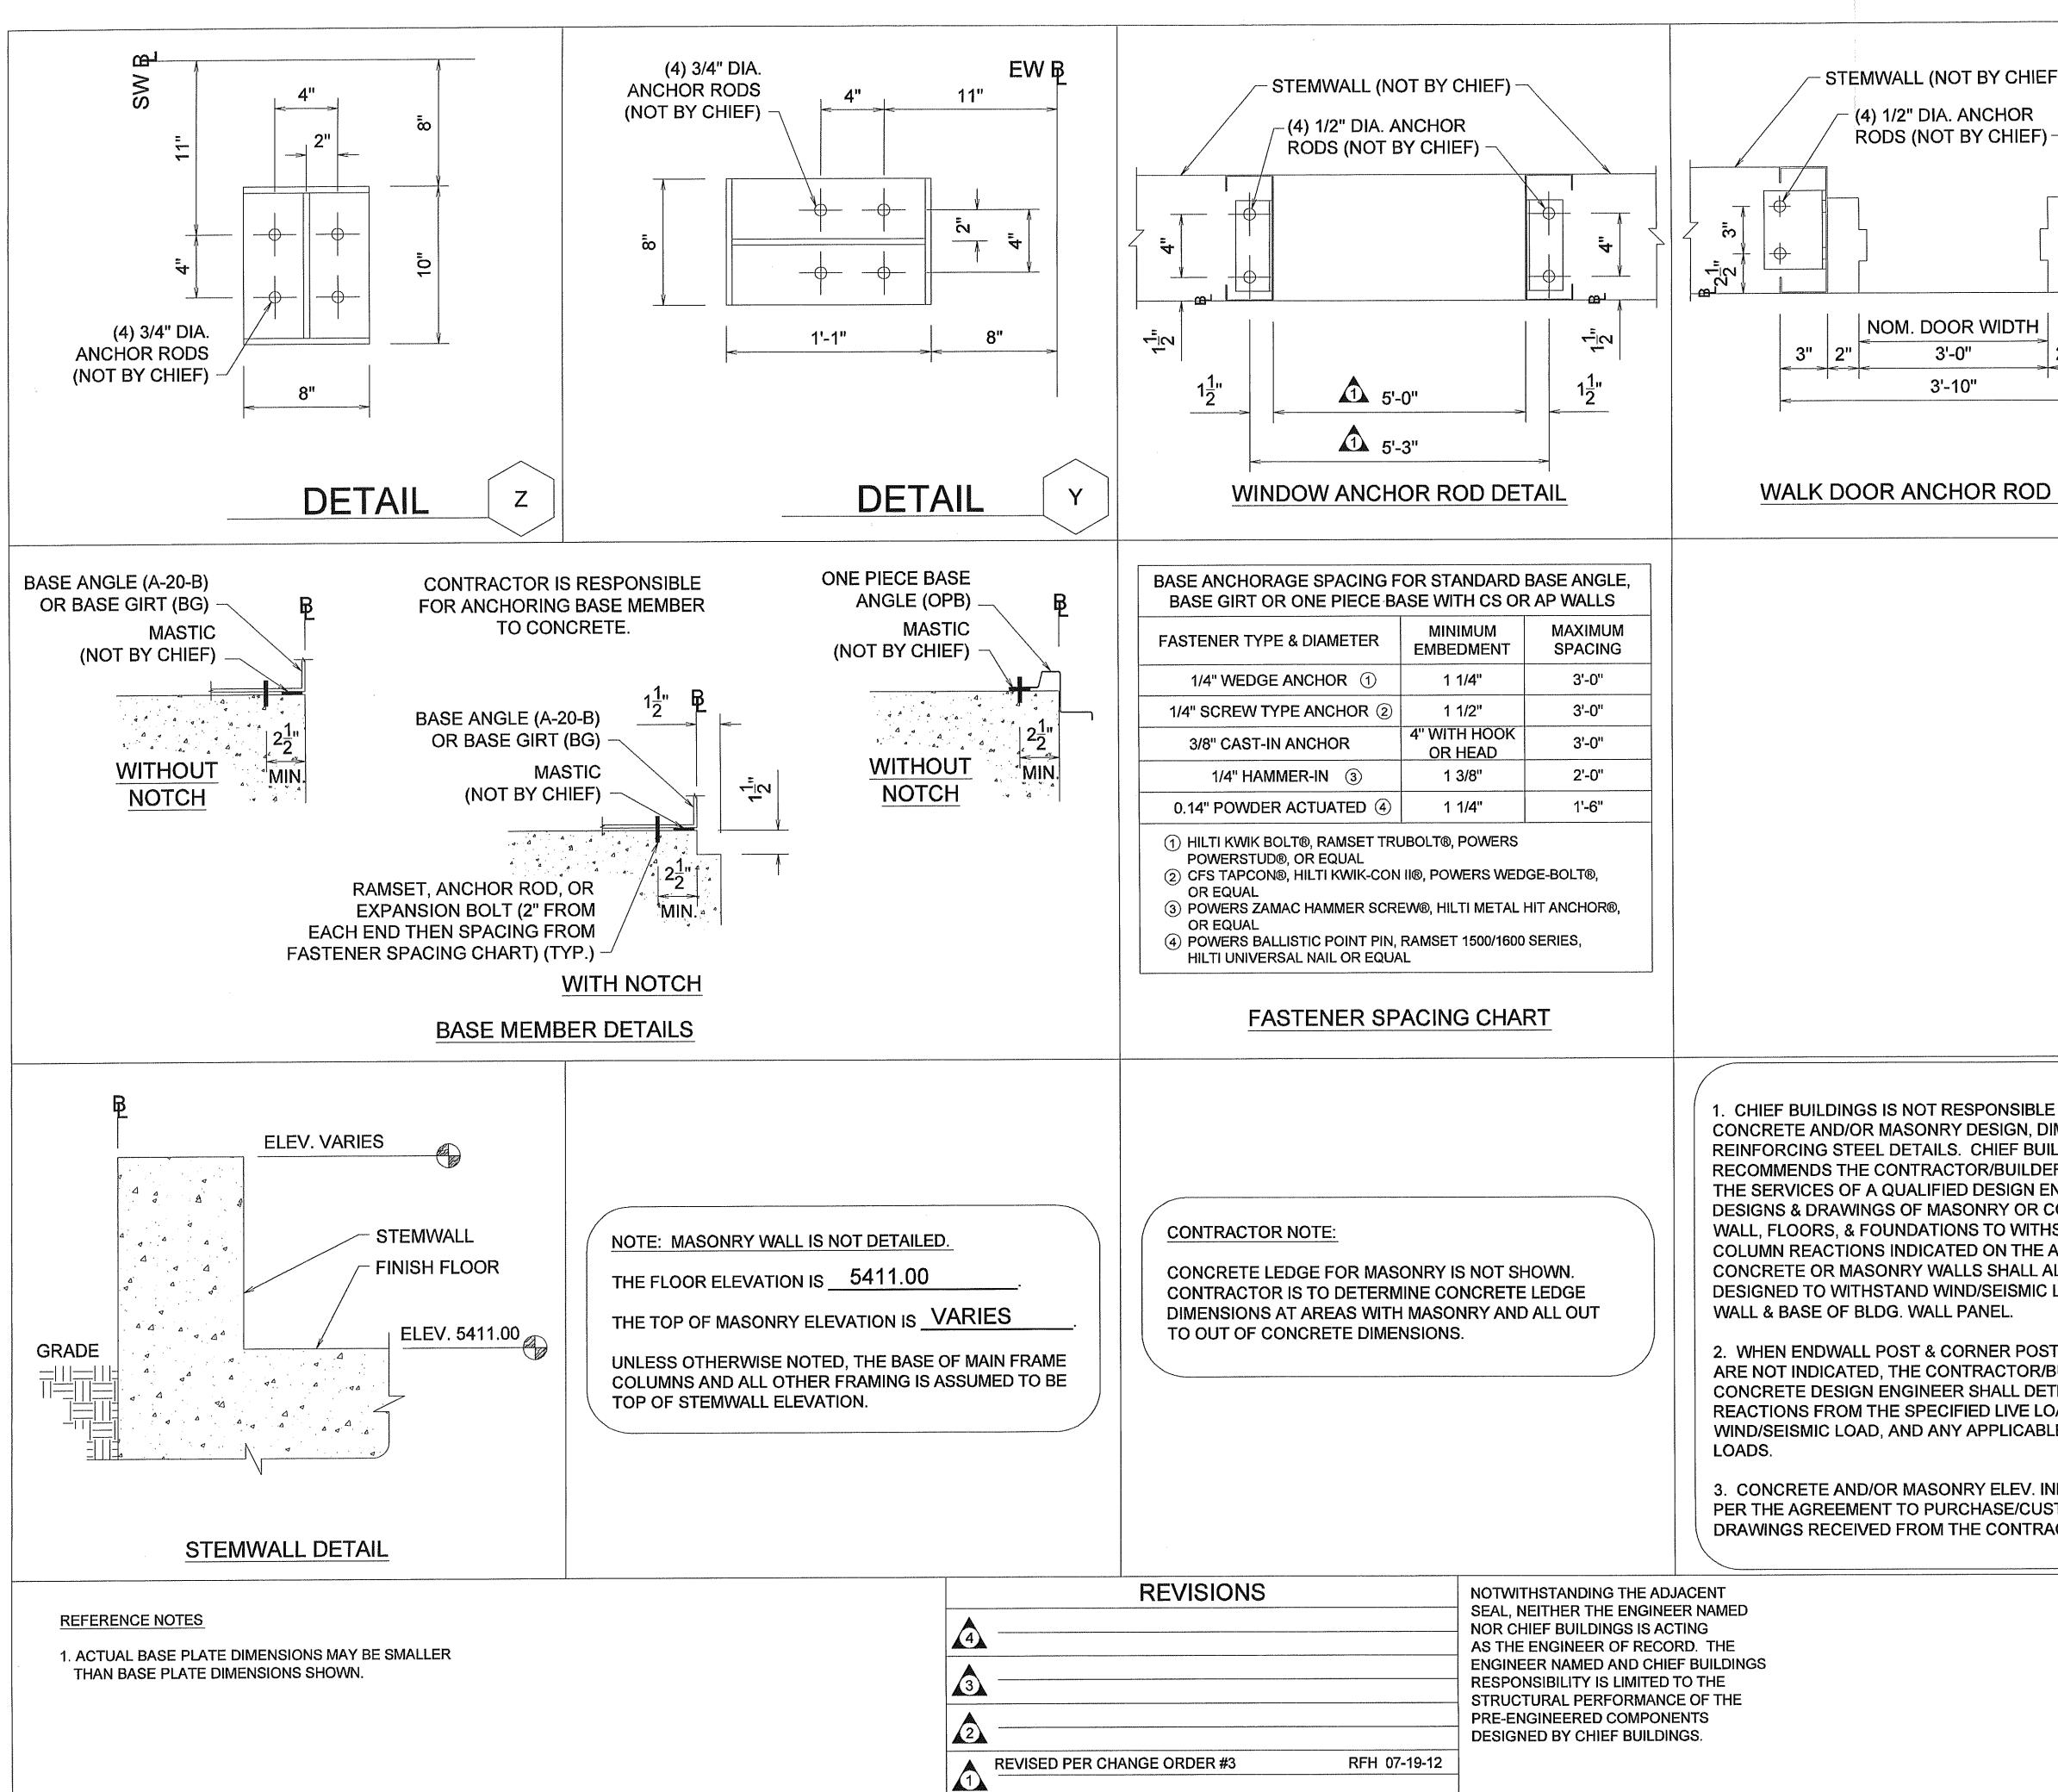

| DETAIL | | | | | |
|---|------------------------------------|----------|----------|-----------|------|
| | | | | | |
| FOR MENSIONS & LDINGS R TO OBTAIN | | | | | |
| NGINEER FOR ONCRETE STAND THE A.B. PLAN. LSO BE LOAD ON THE TREACTIONS BUILDER &/OR TERMINE THE DADS, E AUXILIARY | | ÷ | | | |
| IDICATED ARE TOMER CTOR/BUILDER. | | | | - | |
| ANCHOR I HEATH ST FOUNTAIN RF 51'-0 1 | TEEL / WEA | AVER CO | | NAGEMENT | |
| | | DRAWN | CHECK | ORDER NO. | A2 / |
| BUILDINGS a division of Chief Industries, In | P.O. BOX 2078 | RFH | RS | B3004915 | |
| | nc. GRAND ISLAND, NE 68802-2078 | 06-08-12 | 06-08-12 | | A4 |

This structure has been designed for a collateral load of 3 psf. The total applied loads due to ceiling panels, ducts, sprinkler distribution lines, electrical equipment, conduit, fireproofing, other piping and mechanical loads, etc., cannot exceed this collateral load. In no case shall the total uniform collateral load on an individual roof member exceed the product of 3 psf times the spacing of the supporting member. Nor shall any individual point load or summation of point loads on any one roof member exceed the product of 3 psf times the member spacing times half the member length. In addition, no individual point load on a purlin can exceed 87 lbs. All loads suspended from purlins shall have the load introduced through the web and not the flange of the purlin. Hangers cannot be supported from the edge of flanges or through holes in the flanges of the purlins. Design of hangers and their attachments are not by Chief Buildings. Chief Buildings is NOT responsible for lateral or longitudinal bracing of suspended members subjected to horizontal service, seismic, or wind loading.

Chief Buildings neither assumes nor accepts any responsibility for the design of hangers, bracing of suspended members, transverse support members, nor connections to roof purlins. It is the responsibility of the Buyer/Contractor and/or End Owner to have this design performed by a registered design professional.

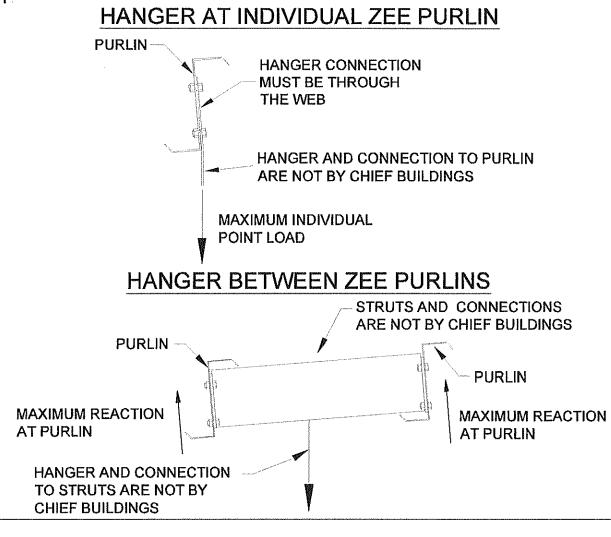

B Building Code 2006 MBMA Occupancy Category Roof Live Load **Collateral Load** Ground Snow Load (Pg) Exposure Factor (Ce) Thermal Factor (Ct) Importance Factor (I) Flat Roof Snow Load (Pf) Minimum Roof Snow Load Building Enclosure Wind Speed Exposure Category Importance Factor (I) Wind Pressure (q) Seismic Spectral Response Short Periods (Spectral Response 1 s Period (S1) Seismic Importance Factor Design Category Site Class Seismic Resisting System Longitudinal Direction Lateral Direction Seismic Response Coefficient (Cs) Spectral Response Parameter Shor Spectral Response Parameter 1 s F Analysis Procedure Base Shear Other Loads:

Mezzanine loading information:

The building provided by Chief Buildings does not incl structural support for the mezzanine, which is furnishe others.


Chief Buildings neither assumes nor accepts any responsibility for the design of the mezzanine. The mezzanine must be designed to resist all vertical and loads without relying on the building provided by Chief Buildings for any support. It is the responsibility of the Buyer/Contractor and/or End Owner to have the mezz design performed by a registered design professional.

REFERENCE NOTES

1. ACTUAL BASE PLATE DIMENSIONS MAY BE SMALLER THAN BASE PLATE DIMENSIONS SHOWN.

4 3 2

| | | | AS THE ENGINEER OF RECO ENGINEER NAMED AND CHIE RESPONSIBILITY IS LIMITED STRUCTURAL PERFORMANC PRE-ENGINEERED COMPON DESIGNED BY CHIEF BUILDIN | ORD. THE EF BUILDINGS TO THE CE OF THE ENTS | F R BU | OUNTAIN, CO RF 51'-0 1/2''X39'X19'-4'' BAYS VARY 3:12 ILDINGS In of Chief Industries, Inc. | |
|--|------------------------|--|--|--|--|--|--|
| | REVISIO | DNS | NOTWITHSTANDING THE AD SEAL, NEITHER THE ENGINE NOR CHIEF BUILDINGS IS AC | ER NAMED | | NCHOR ROD DRAWINGS EATH STEEL / WEAVER CONST. MANAGEMI | |
| frame has centerline Where th sides of t | | has been designed for a future expansion of 23'-0" rline-to-centerline of the future frame. e the frame cross section requires flange braces both of the column or rafter, these flange braces must be ed upon future expansion. | | | base member into the top of loads applied to the wall are | gned to safely transfer the forces shown from the of the wall. The wall must be designed to resist ea and the loads from the base member to the wall nd overstrength detailing requirements as required | |
| nclude shed by | The frame | e at line 6 is an expandabl | e full load frame. The | | CONTRACTOR IS RESPO ANCHORING BASE MEM PARTIAL | | |
| | | | | | LOAD APPLIED TO TOP WALL FROM BASE ME (SEE TABLE BELOW) | | |
| s) 0.08 nort Period (SDS) 0.19 s Period (SD1) 0.09 ELF 211 | | Steel System (R=3.0) 0.082 0.197 0.094 ELF 2112 lbs. None | | | BASE MEMBER (DOES NOT PROVIDE SUPPORT TO TOP OF WALL) | BASE MEMBER MAY BE BASE ANGLE, BASE GIRT, OR ONE PIECE BASE ANGLE. MASTIC (NOT BY CHIEF) | |
| s (Ss) 1) 5.9% 1.25 B D Steel System (R=3.0) | | | | walls to allow for diff the structure provide Lateral deflection and drift I have been held to the limits responsibility of the register | ferential movement of the concrete wall and ed by Chief Buildings. limits for the structure provided by Chief Buildings s ordered in the Agreement to Purchase. It is the red design professional to insure design of the is compatible with these serviceability limits. | | |
| | | 23.10 psf 30.00 psf Enclosed 100 mph (GCpi ± 0.18) C 1.15 23.52 psf | | | and lateral loads (ind member from the wa differential movemer by Chief Buildings. 2.) Attachment of the ba concrete wall. | nd required reinforcing for code prescribed vertical cluding the load imposed through the base all panel above) and sufficient ductility to allow for nt of the concrete wall and the structure provided ase member provided by Chief Buildings to the the wall and at isolation joints at perpendicular | |
| · | | Pikes Peak Regional Bu Substantial Hazard 20 psf (Tributary Area Reduction 3 psf 30 psf 1.0 1.0 1.1 | - | | member at the top of the wasupport to the top of the was responsibility for design of a interface of this wall with the It is the responsibility of the | concrete, which is not by Chief Buildings. The base vall has <u>NOT</u> been designed to provide lateral all. Chief Buildings neither assumes nor accepts <u>any</u> this partial height concrete wall nor attachment or ne structure provided by Chief Buildings. Buyer/Contractor and/or End Owner to retain the sign professional who is responsible for the design | |
| - | Design Crite 004915 | eria | | | The structure provided by (| Chief Buildings has been designed to have a partial | |

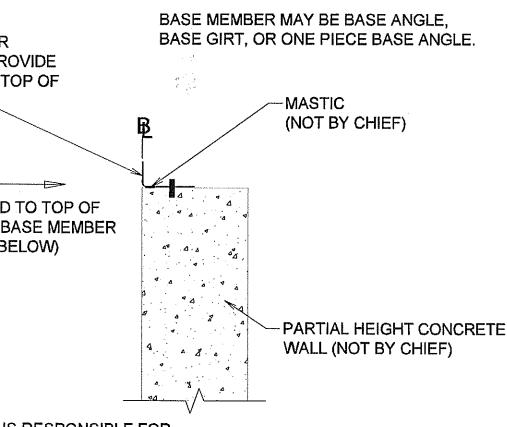

| | | ł . | | | | | |
|--|----------|----------|-----------|------|--|--|--|
| ANCHOR ROD DRAM | WINGS | | | | | | |
| HEATH STEEL / WE | AVER CC | NST. MA | NAGEMENT | | | | |
| FOUNTAIN, CO | | | | | | | |
| RF 51'-0 1/2"X39'X19'-4" BAYS VARY 3:12 | | | | | | | |
| CHIEF | DRAWN | CHECK | ORDER NO. | A3 / | | | |
| BUILDINGS | RFH | RS | B3004915 | | | | |
| a division of Chief Industries, Inc. GRAND ISLAND, NE 68802-2078 | 06-08-12 | 06-08-12 | D3004913 | A4 | | | |

The 16" wide 20 ga Stucco Wall Panels with sealant, not provided by Chief Buildings, must provide structural support to all secondary framing. These panels must have a positive attachment to Chief Buildings' secondary framing capable of resisting roll forces, sag loads, lateral buckling, etc. in accordance with AISI specifications.

The wall panels not provided by Chief Buildings and their anchorage to the secondary framing must be capable of resisting all loads required by the specified building code and listed below.

Wall Panel Pressure (Interior Zone) = 27.8 psf Wall Panel Suction (Interior Zone) = 30.1 psf Wall Panel Suction (Corner Zone) = 37.2 psf (Corner Zone Width =5.1 ft.)

The wall panels must meet the minimum properties and connections given below, which will be considered adequate to provide support to the secondary framing.

Minimum Wall Panel Properties: Ixx = 0.0368 in4/ft Sxx = 0.0447 in3/ft

Minimum Connection Requirements:

(1) #12 structural fastener to secondary at 1'-4" o.c.

Chief Buildings neither assumes nor accepts any responsibility for the design of the wall panels and their anchorage nor coordination of compatibility between products provided by Chief Buildings and the wall panels not provided by Chief Buildings. It is the responsibility of the Buyer/Contractor and/or End Owner to have this design performed by a registered design professional.

The 24 ga Metal Sales Seam-Loc roof panels are not p by Chief Buildings. Chief Buildings will supply secondar framing in the roof capable of resisting roll forces, sag l and lateral buckling.

The roof panels not provided by Chief Buildings and the anchorage to the secondary framing must be capable of resisting all loads required by the specified building code listed below.

Roof Live Load = 20 psf Roof Snow Load = 38.17 psf Roof Panel Suction (Interior Zone) = 25.40 psf Roof Panel Suction (Edge Zone) = 44.22 psf Roof Panel Suction (Corner Zone) = 65.39 psf (Edge/Corner Zone Width = 5.1 ft.)

Chief Buildings neither assumes nor accepts any respon for the design of the roof panels and their anchorage nor coordination of compatibility between products provided Chief Buildings and the roof panels not provided by Chie Buildings. It is the responsibility of the Buyer/Contractor End Owner to have this design performed by a registered design professional.

ORIENTATION OF HORIZONTAL REACTIONS:



Hx IS PARALLEL TO THE COLUMN WEB AND Hy IS PERPENDICULAR TO THE COLUMN WEB, FOR ALL ENDWALL COLUMNS & SOLDIER COLUMNS BY CHIEF BUILDINGS.

1. COLUMN FOOTINGS AND PIERS MUST BE DESIGNED TO WITHSTAND HORIZONTAL AND VERTICAL REACTIONS AS SHOWN ON THE ANCHOR ROD PLAN. CHIEF BUILDINGS IS NOT RESPONSIBLE FOR DESIGN OF CONCRETE FOUNDATION. CHIEF BUILDINGS RECOMMENDS THAT THE SERVICES OF A QUALIFIED ENGINEER IS OBTAINED BY TH CONTRACTOR / BUILDER TO DESIGN THE FOUNDATIONS FOR THE INDICATED REACTIONS.

2. REACTIONS ARE GIVEN IN KIPS. (1 KIP = 1000 LBS.) MOMENTS, IF ANY, ARE GIVEN IN KIP-FT.

3. ANCHOR ROD DESIGN IS BASED ON SHEAR, TENSION, AND COMBINED TENSION AND SHEAR. CHIEF BUILDINGS IS NOT RESPONSIBLE FOR ANCHOR ROD SIZE RECOMMENDATIONS WHEN ANCHOR ROD CONFIGURATION PLACES THE RODS IN A BENDING MODE. WHEN THE COLUMN BASE PLATE BEARS ON GROUT, THE **CONTRACTOR / BUILDER OR FOUNDATION ENGINEER SHAL** INVESTIGATE BENDING IN THE ANCHOR RODS AND PROVIDE A SHEAR KEY FOR THE COLUMN BASE TO THE PIER WHEN THE ANCHOR RODS ARE NOT ADEQUATE IN BENDING ABOUT THE PIER.

REFERENCE NOTES

1. ACTUAL BASE PLATE DIMENSIONS MAY BE SMALLER THAN BASE PLATE DIMENSIONS SHOWN.

(4) (3)(2) (1)

| provided | | |
|-------------|--|---|
| ry loads | | |
| | | |
| eir | | |
| of | | |
| le and | | |
| | | |
| | | |
| | | |
| | | |
| | <u></u> | |
| | Y1 | X1X2 |
| nsibility | | Z1 Y1 Z2 Y2 |
| or Lbv | DL - DEAD LOAD 0.9 2.5 - -0.9 2.5 - | LOAD TYPE X1 Y1 Z1 X2 Y2 Z2 DL - DEAD LOAD 0.9 2.4 - -0.9 2.4 |
| l by ef | LL - LIVE LOAD 5.3 12.05.3 12.0 - | COL- COLLATERAL 0.7 1.7 - -0.7 1.7 - UL - LIVE LOAD 1.2 1.4 1.7 - |
| and/or | WLL- WIND FROM LEFT -7.1 -12.2 - 1.3 -9.0 - | SL - SNOW LOAD 7.3 16.7 - -7.3 16.7 - WI - WIND FROM LEFT 7.2 10.7 - -7.3 16.7 - |
| ed | WL2- WIND LT CASE 2 -6.4 -7.1 - 0.6 -3.9 - | WLR- WIND FROM RIGHT -0.3 -8.0 - WI 2: WIND FROM RIGHT -0.3 -8.0 - 7.2 -11.5 - |
| | WR2- WIND RT CASE 2 -0.6 -3.9 - 6.4 -7.1 - WLE- WIND ON ENDWALL -2.7 -14.0 - 3.3 -12.8 - | WR2- WIND RT CASE 23.3 - 6.9 -6.8 - |
| | WE2- EW WIND CASE 2 -3.3 -12.8 - 2.7 -14.0 - SL4- SNOW LOAD 5.0 7.8 - -5.0 13.4 - | WE2- EW WIND CASE 2 -2.4 -11.8 - 1.9 -12.9 - SI 4 SNOWLOAD - 1.9 -12.9 - - - - |
| | SL3- SNOW LOAD 5.0 13.4 - -5.0 7.8 - SEI- SEISMIC LOAD -0.4 -0.3 - -0.4 0.3 - | SL3- SNOW LOAD 4.6 12.3 - -4.6 7.2 - |
| | SB1- SEISMIC BRACING - -0.7 ±0.8 - -0.7 ±0.8 SB2- SEISMIC BRACING - 0.7 - 0.7 ±0.8 | SEI- SEISMIC LOAD -0.4 -0.3 - -0.4 0.3 - SB1- SEISMIC BRACING - -0.7 ±0.8 - -0.7 ±0.8 |
| | BR1- WIND BRACING 1 - -4.6 ±5.1 - -4.6 ±5.1 BR2- WIND BRACING 2 0.1 4.6 - -0.1 4.6 | SB2- SEISMIC BRACING - 0.7 - - 0.7 - BR1- WIND BRACING 1 - -4.6 ±5.1 - -4.6 ±5.1 |
| | MAXIMUM POSITIVE 9.9 22.5 ±5.1 6.6 22.5 ±5.1 MAXIMUM NEGATIVE -6.6 -17.1 ±5.1 -9.9 -17.1 ±5.1 | BR2- WIND BRACING 2 0.1 4.6 - -0.1 4.6 - MAXIMUM POSITIVE 9.1 20.8 ±5.1 6.7 20.8 ±5.1 |
| | B3004915A01 REACTIONS USED AT LINE(S): 5 | MAXIMUM NEGATIVE -6.7 -16.1 ±5.1 -9.1 -16.1 ±5.1 |
| | | B3004915A02 REACTIONS USED AT LINE(S): 6 |
| | | |
| | | |
| o | | |
| | | |
| 5 | STEEL MATERIAL PROPERTIES AND SPECIFICATIONS: | |
| E 1F | WELDED WF BEAMS/PLATE 1/4" THICK: (ASTM A529, A572) (GR. 55) | |
| | VVELDED VVF BEAMS/PLATE > $1/8"$ & < $1/4"$ THICK: | |
| | ASTM (A1011-SS, A1011-HSLAS, A572) (GR 55) LIGHT GAGE (16, 14, 12 GA. BLACK): ASTM (A1011-SS, A1011-HLAS) (GR. 55) ROUND BOD: (ASTM A20) | |
| | ROUND ROD. (ASTM A36) | |
| | ROUND PIPE (BLACK): $FY = 35$ KSI (ASTM A53 GR. B, A500 GR. B) SQUARE/RECTANCULAR TURING: ACTM A502 (OR B) | |
| e | SQUARE/RECTANGULAR TUBING: ASTM A500 (GR. B) HOT ROLLED WF BEAMS: ASTM A36; ASTM (A572, A992) (Gr. 50) | |
| 3 | TOT ROLLED CHANNEL: AS IM A36: ASTM A572 (GR 50) | |
| DN | BRACING CABLE: EXTRA HIGH STRENGTH (ASTM A475) | |
| | CS & LTC ROOF PANEL (26 & 24 GA. GALVALUME): ASTM A792 (GR. 80) MSC & STC ROOF PANEL (24 & 22 GA. GALVALUME): ASTM A 792 (GR. 50) | |
| | US & AF WALL PANEL (26 & 24 GA, GALVALUME) ASTM 792 (CP 90) | |
| | MVP/MVP ROOF PANEL (24 & 22 GA. GALVALUME): ASTM A 792 (GR. 50) CFW WALL PANEL (24 GA. GALVALUME): ASTM A 792 (GR. 50) | |
| | GR. 50) | |
| | | |
| REVI | SIONS NOTWITHSTANDING THE ADJACENT | |
| | SEAL, NEITHER THE ENGINEER NAMED NOR CHIEF BUILDINGS IS ACTING | ANCHOR ROD DRAWINGS |
| | AS THE ENGINEER OF RECORD. THE | HEATH STEEL / WEAVER CONST. MANAGEMENT |
| | ENGINEER NAMED AND CHIEF BUILDINGS RESPONSIBILITY IS LIMITED TO THE | FOUNTAIN, CO |
| | STRUCTURAL PERFORMANCE OF THE PRE-ENGINEERED COMPONENTS | RF 51'-0 1/2"X39'X19'-4" BAYS VARY 3:12 |
| | DESIGNED BY CHIEF BUILDINGS. | CHIEFE DRAWN CHECK ORDER NO. A4 |
| | | BUILDINGS REH RS |
| | | a division of Chief Industries, Inc. P.O. BOX 2078 GRAND ISLAND, NE 06-08-12 06-08-12 B3004915 |

| A | | | | | | L |
|--|------|-------|---------|------|--------|---------|
| Y1 | | | | | X | 2 Y2 |
| D TYPE | X1 | Y1 | Z1 | X2 | Y2 | Z2 |
| DEAD LOAD | 0.9 | 2.4 | - | -0.9 | ·· | |
| - COLLATERAL | 0.7 | 1.7 | _ | -0.7 | 1.7 | - |
| LIVE LOAD | 4.9 | 11.1 | - | -4.9 | 11.1 | |
| SNOW LOAD | 7.3 | 16.7 | - | -7.3 | 16.7 | |
| - WIND FROM LEFT | -7.2 | -11.5 | - | 0.3 | -8.0 | |
| - WIND FROM RIGHT | -0.3 | -8.0 | | 7.2 | -11.5 | |
| - WIND LT CASE 2 | -6.9 | -6.8 | - | | -3.3 | |
| - WIND RT CASE 2 | - | -3.3 | _ | 6.9 | -6.8 | |
| - WIND ON ENDWALL | -1.9 | -12.9 | | 2.4 | -11.8 | |
| - EW WIND CASE 2 | -2.4 | -11.8 | | 1.9 | -12.9 | |
| SNOW LOAD | 4.6 | 7.2 | | -4.6 | 12.3 | |
| SNOW LOAD | 4.6 | 12.3 | | -4.6 | 7.2 | |
| SEISMIC LOAD | -0.4 | -0.3 | ···· | -0.4 | 0.3 | |
| SEISMIC BRACING | - | -0.7 | ±0.8 | | -0.7 | ±0.8 |
| SEISMIC BRACING | - | 0.7 | | _ | 0.7 | ±0.8 |
| WIND BRACING 1 | - | -4.6 | ±5.1 | | -4.6 | ±5.1 |
| WIND BRACING 2 | 0.1 | 4.6 | | -0.1 | 4.6 | ±0.1 |
| MUM POSITIVE | 9.1 | 20.8 | ±5.1 | 6.7 | 20.8 | |
| MUM NEGATIVE | -6.7 | -16.1 | ±5.1 | -9.1 | -16.1 | ±5.1 |
| ······································ | | | <u></u> | -3.1 | - 10,1 | ±5.1 |