



WEAVER CONSTRUCTION MANAGEMENT, INC.
 3679 S. Huron St., Suite 404
 Englewood, CO 80110
 Phone: (303) 789-4111 FAX: (303) 789-4310

SUBMITTAL TRANSMITTAL

November 28, 2011
WCM Submittal No: 05500-005.A

PROJECT: Harold Thompson Regional WRF
 Birdsall Rd.
 Fountain, CO 80817
 Job No. 2908

ENGINEER: GMS, Inc.
 611 No. Weber St., #300
 Colorado Springs, CO 80903
 719-475-2935 Roger Sams

OWNER: Lower Fountain Metropolitan
 Sewage Disposal District
 901 S. Santa Fe Ave.
 Fountain, CO 80817
 719-382-5303 James Heckman

CONTRACTOR: Rocky Mountain Railings
 11839 E. 51st Ave.
 Denver, CO 80239

SUBJECT: Resubmitting with Calculation Corrections - Handrail for the Aeration Basin/Digester Structure, Clarifiers and Pumping and Disinfection Building.

SPEC SECTION: 05500 - Metal Fabrications

PREVIOUS SUBMISSION DATES: 11/17/11

DEVIATIONS FROM SPEC: ___ YES X NO

CONTRACTOR'S STAMP: This submittal has been reviewed by WCM and approved with respect to the means, methods, techniques, & safety precautions & programs incidental thereto. Weaver General Construction also warrants that this submittal complies with contracted documents and comprises on deviations thereto.

<p>Contractor's Stamp:</p> <p>Date: 11/28/11 Reviewed by: H.C. Myers <input checked="" type="checkbox"/> Reviewed Without Comments <input type="checkbox"/> Reviewed With Comments</p> <p>ENGINEER'S COMMENTS:</p>	<p>Engineer's Stamp:</p>
---	--------------------------



Attached are page(s) from the 2008 Hilti North American Product Technical Guide. For complete details on this product, including data development, product specifications, general suitability, installation, corrosion, and spacing & edge distance guidelines, please refer to the Technical Guide, or contact Hilti.




**PROFIS:
The World's Most Powerful
Anchor Design Software**

- Easy to Learn – Start working in just minutes
- Fast and Powerful – Produce detailed designs quickly
- Specify with Confidence – The largest number of approvals and latest design codes

No charge.

Download now at www.us.hilti.com or www.hilti.ca

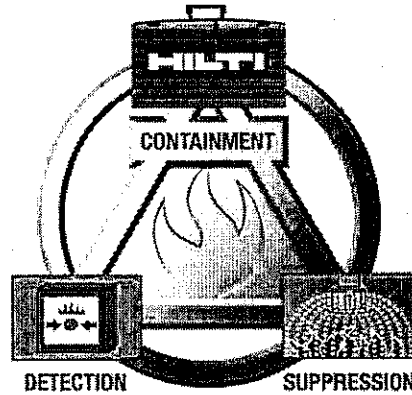

Firestop Systems

When it comes to Life Safety and building code compliance, Hilti provides complete solutions with a wide range of products and unmatched technical support.


- Firestop Systems Guides
 - Through Penetrations
 - Joint Penetrations
- FACT Program
- FS 411
- BASIC Training
- Engineering Judgements
- Firestop Design Center online at www.us.hilti.com or www.hilti.ca



Hilti Diaphragm Deck Design

The Hilti Diaphragm Deck Design Program allows designers to quickly and accurately design roof deck and composite floor deck diaphragms.

- Ability to design with innovative Hilti fasteners for frame and sidelap connection
- Creates easy to use load tables with span ranges based on user input
- Allows for different safety factors depending on load type, building code and field quality control
- Direct link to Hilti website

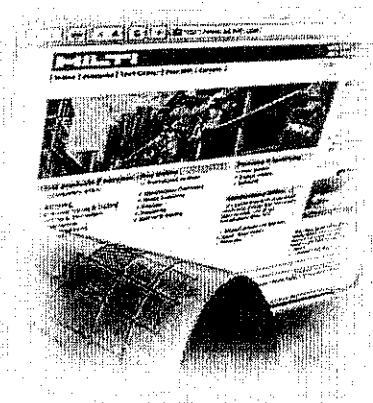

Hilti Online

- Technical Library
- Design Centers
- Interactive Product Advisors
- Full-line Product Catalog
- Online Ordering
- Maps to Hilti locations
- "Contact Us" program to answer your questions



MI - Industrial Pipe Support Technical Guide


A guide to specifying the Hilti modular pipe support system for medium to heavy loads without welding.

- MI System is the ideal solution for pipes up to 24 in. diameter
- Reliable fastenings without welds
- Easily installed

HIT-RE 500 Epoxy Adhesive Anchoring System 4.2.7

4.2.7.1 Product Description

Fastener Components

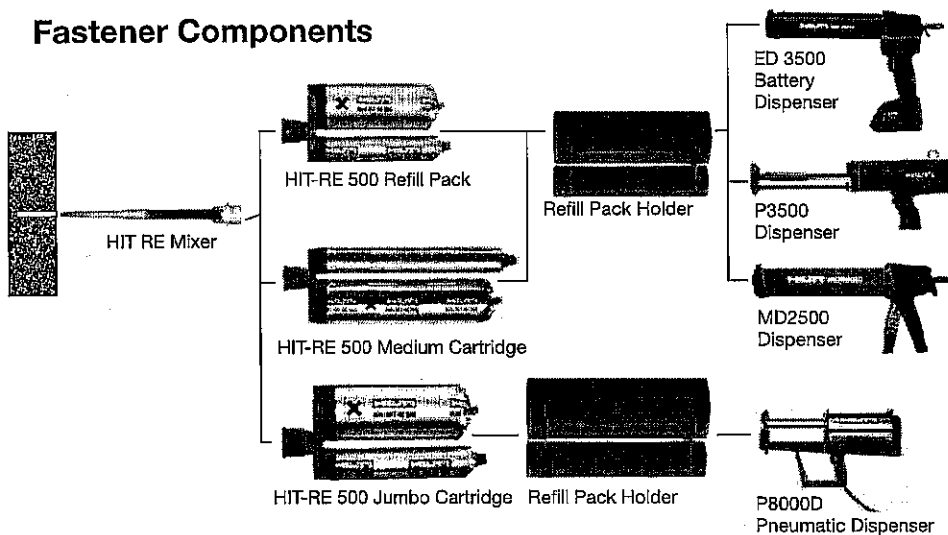

4.2.7.1 Product Description

4.2.7.2 Material Specifications

4.2.7.3 Technical Data

4.2.7.4 Installation Instructions

4.2.7.5 Ordering Information

Listings/Approvals

City of Los Angeles
Research Report #25514

NSF/ANSI Std 61

certification for use in potable water

European Technical Approval

ETA-04/0027

ETA-04/0028

ETA-04/0029



Code Compliance

IBC®/IRC® 2003 (ICC-ES AC58)

IBC®/IRC® 2000 (ICC-ES AC58)

UBC® 1997 (ICC-ES AC58)

LEED®: Credit 4.1-Low Emitting

Materials




The Leadership in Energy and Environmental Design (LEED®) Green Building Rating system™ is the nationally accepted benchmark for the design, construction and operation of high performance green buildings.

The Hilti HIT-RE 500 System is a high strength, two part epoxy adhesive. The system consists of a side-by-side adhesive refill pack, a mixing nozzle, a HIT dispenser with refill pack holder, and either a threaded rod, rebar, HIS internally threaded insert or smooth epoxy coated bar. HIT-RE 500 is specifically designed for fastening into solid base materials such as concrete, grout, stone or solid masonry. HIT-RE 500 may be used in underwater fastenings and for oversized holes up to 2 times the rod diameter (2-1/2" rod and 3" max. hole diameter) and for diamond-cored holes.

Product Features

- Superior bond performance
- Use in diamond cored or pneumatic drilled holes and under water up to 165 feet (50 m)
- Meets DOT requirements for most states; contact the Hilti Technical Staff
- Meets requirements of ASTM C 881-90, Type IV, Grade 2 and 3, Class A, B, C except gel times
- Meets requirements of AASHTO specification M235, Type IV, Grade 3, Class A, B, C except gel times
- Mixing tube provides proper mixing, eliminates measuring errors and minimizes waste
- Contains no styrene; virtually odorless
- Extended temperature range from 23°F to 104°F (-5°C to 40°C)
- Excellent weathering resistance; Resistance against elevated temperatures
- Suitable for oversized holes
- Seismic qualified per IBC®/IRC® 2003, IBC®/IRC® 2000 and UBC® 1997 (ICC-ES AC58). Please refer to ESR-1682.

Components

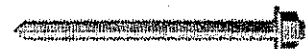

HAS Threaded Rods



HIS Internally Threaded Inserts



Rebar (supplied by contractor)



Smooth, epoxy coated bar (supplied by contractor)

4.2.7 HIT-RE 500 Epoxy Adhesive Anchoring System

Guide Specifications

Master Format Section:

03250 (Concrete accessories)

Related Sections:

03200 (Concrete Reinforcing-Reinforcing Accessories)

05050 (Metal Fabrication)

05120 (Structural Steel; Masonry Accessories)

Injectable adhesive shall be used for installation of all reinforcing steel dowels or threaded anchor rods and inserts into new or existing concrete. Adhesive shall be furnished in side-by-side refill packs which keep component A and component B separate. Side-by-side packs shall be designed to compress during use to minimize waste volume. Side-by-side packs shall also be designed to accept static mixing nozzle

which thoroughly blends component A and component B and allows injection directly into drilled hole. Only injection tools and static mixing nozzles as supplied by manufacturer shall be used. Manufacturer's instructions shall be followed. Injection adhesive shall be formulated to include resin and hardener to provide optimal curing speed as well as high strength and stiffness. Typical curing time at 68°F (20°C) shall be approximately 12 hours.

Injection adhesive shall be HIT-RE 500, as furnished by Hilti.


Anchor Rods Shall be furnished with chamfered ends so that either end will accept a nut and washer. Alternatively, anchor rods shall be furnished with a 45 degree chisel point on one end to allow for easy insertion into the adhesive-filled hole. Anchor rods shall be manufactured to meet the following requirements:

1. ISO 898 Class 5.8
2. ASTM A 193, Grade B7 (high strength carbon steel anchor);
3. AISI 304 or AISI 316 stainless steel, meeting the requirements of ASTM F 593 (condition CW).

Special order length HAS Rods may vary from standard product.

Nuts and Washers Shall be furnished to meet the requirements of the above anchor rod specifications.

Fastener Components

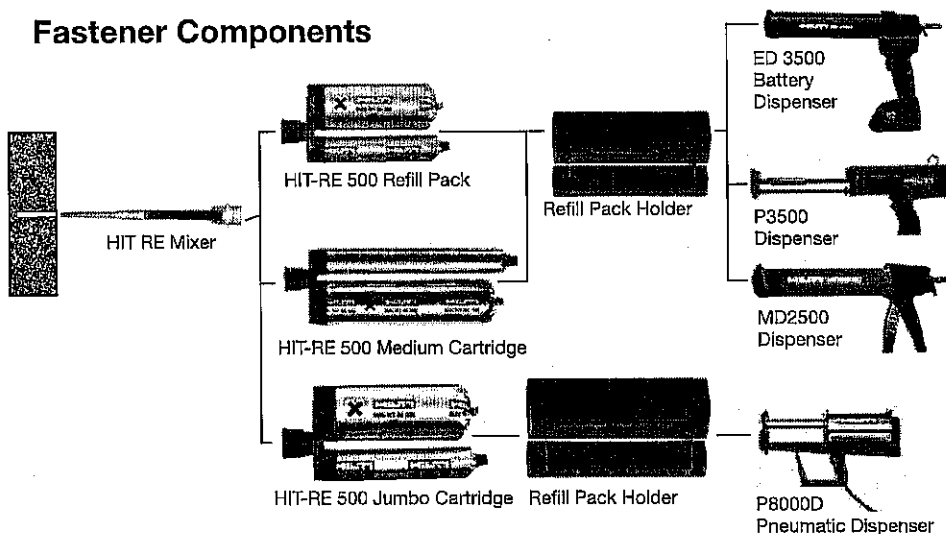

HIT-RE 500 Epoxy Adhesive Anchoring System 4.2.7

4.2.7.2 Material Specifications

Material Properties for HIT-RE 500 – Cured Adhesive

Bond Strength ASTM C882-91 ¹ 2 day cure 7 day cure	12.4 MPa 12.4 MPa	1800 psi 1800 psi
Compressive Strength ASTM D-695-96 ¹	82.7 MPa	12,000 psi
Compressive Modulus ASTM D-695-96 ¹	1493 MPa	0.22 x 10 ⁶ psi
Tensile Strength 7 day ASTM D-638-97	43.5 MPa	6310 psi
Elongation at break ASTM D-638-97	2.0%	2.0%
Heat Deflection Temperature ASTM D-648-95	63°C	146°F
Absorption ASTM D-570-95	0.06%	0.06%
Linear Coefficient of Shrinkage on Cure ASTM D-2566-86	0.004	0.004
Electrical resistance DIN IEC 93 (12.93)	6.6 x 10 ¹³ Ω/m	1.7 x 10 ¹² Ω/in.

¹ Minimum values obtained as the result of tests at three cure temperatures (23, 40, 60°F).

Material Specifications

Standard HAS-E rod material meets the requirements of ISO 898 Class 5.8

High Strength or 'Super HAS' rod material meets the requirements of ASTM A 193, Grade B7

Stainless HAS rod material meets the requirements of ASTM F 593 (304/316) Condition CW 3/8" - 5/8"

Stainless HAS rod material meets the requirements of ASTM F 593 (304/316) Condition CW 3/4" - 1 1/4"

HIS Insert 11MnPB30+C Carbon Steel conforming to DIN 10277-3

HIS-R Insert X5CrNiMo17122 K700 Stainless Steel conforming to DIN EN 10088-3

HAS Super & HAS-E Standard Nut material meets the requirements of ASTM A 563, Grade DH

HAS Stainless Steel Nut material meets the requirements of ASTM F 594

HAS-E Carbon Steel and Stainless Steel Washers meet dimensional requirements of ANSI B18.22.1 Type A Plain

HAS Super & HAS-E Standard Washers meet the requirements of ASTM F 436

All HAS-E & HAS Super Rods (except 7/8") & HAS-E Standard, HIS inserts, nuts & washers are zinc plated to ASTM B 633 SC 1


7/8" Standard HAS-E & HAS Super rods hot-dip galvanized in accordance with ASTM A 153

Note: Special Order steel rod material may vary from standard steel rod materials.

4.2.7.3 Technical Data

HIT-RE 500 Installation Specification Table for HAS Threaded Rods

HAS Rod Size		in.	3/8	1/2	5/8	3/4	7/8	1	1-1/4
Details		(mm)	(9.5)	(12.7)	(15.9)	(19.1)	(22.2)	(25.4)	(31.8)
d_{bit}	bit diameter ¹	in.	7/16	9/16	3/4	7/8	1	1-1/8	1-3/8
h_{nom}	std. depth of embed.	in.	3-3/8	4-1/2	5-5/8	6-3/4	7-7/8	9	11-1/4
		(mm)	(90)	(110)	(143)	(171)	(200)	(229)	(286)
T_{max}	HAS-E Rods	Embed.	ft lb	18	30	75	150	175	235
max.		$\geq h_{nom}$	(N·m)	(24)	(41)	(102)	(203)	(237)	(319)
tightening torque	HAS SS	Embed.	ft lb	15	20	50	105	125	165
	HAS-Super	$< h_{nom}$	(N·m)	(20)	(27)	(68)	(142)	(169)	(224)
h	min. base material thickness	(in.)	1.5 h_{ef}						
Approx. number of fastenings per cartridge at standard embedment ²									
Small Cartridge			52	28	11	7	5	4	2
Medium Cartridge			84	45	18	11	8	6	3
Jumbo Cartridge			255	137	56	37	27	19	12

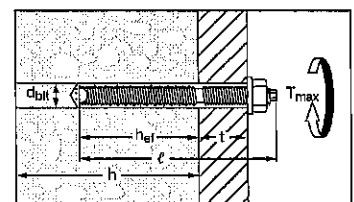


1 Use matched tolerance carbide tipped bits or Hilti matched tolerance DD-B or DD-C diamond core bits.

2 Assumes no waste.

4.2.7 HIT-RE 500 Epoxy Adhesive Anchoring System

HIT-RE 500 Installation Specification Table for HIS Inserts

HIS Insert		in.	3/8	1/2	5/8	3/4
Details		(mm)	(9.5)	(12.7)	(15.9)	(19.1)
d_{bit} bit diameter ^{1,2}	in.		11/16	7/8	1-1/8	1-1/4
h_{nom} std. embed. depth	in.		4-1/4	5	6-5/8	8-1/4
	(mm)		(110)	(125)	(170)	(210)
l_{th} useable thread length	in.		1	1-3/16	1-1/2	2
	(mm)		(25)	(30)	(40)	(50)
T_{max} Max. tightening torque	ft lb		18	35	80	160
	(N-m)		(24)	(47)	(108)	(217)
h min. base material thickness	in.		6-3/8	7-1/2	10	12-3/8
	(mm)		(162)	(191)	(254)	(314)
Approx. number of fastenings per cartridge at standard embedment ²						
Small Cartridge			27	16	6	4
Medium Cartridge			49	30	11	8
Jumbo Cartridge			168	105	38	27

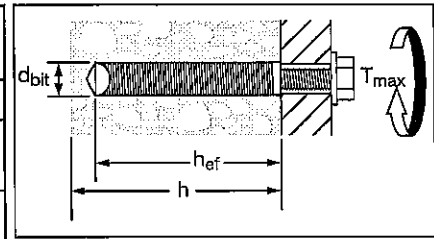

- 1 Use matched tolerance carbide tipped bits or Hilti matched tolerance DD-B or DD-C diamond core bits.
- 2 Assumes no waste.

HIT-RE 500 Installation Specification Table for Rebar in Concrete

Rebar Size:		No. 3	No. 4	No. 5	No. 6	No. 7	No. 8	No. 9	No. 10	No. 11
Details										
Bit diameter ^{1,2,3}	in.	1/2	5/8	3/4	7/8	1	1-1/8	1-3/8	1-1/2	1-3/4
h_{nom} std. embed. depth	in.	3-3/8	4-1/2	5-5/8	6-3/4	7-7/8	9	10-1/8	11-1/4	12-3/8
	(mm)	(86)	(114)	(143)	(171)	(200)	(229)	(257)	(286)	(314)
Approx. number of fastenings per cartridge at standard embedment ³										
Small Cartridge		44	25	16	11	8	6	3	2	1
Medium Cartridge		72	41	27	18	13	10	5	3	2
Jumbo Cartridge		221	125	83	56	41	31	14	11	7

- 1 Rebar diameters may vary. Use smallest drill bit which will accommodate rebar.
- 2 Use matched tolerance carbide tipped bits or Hilti matched tolerance DD-B or DD-C diamond core bits.
- 3 Assumes no waste.

HIT-RE 500 Installation Specification Table for Metric Rebar in Concrete (Canada Only)

Rebar Size:		10M	15M	20M	25M	30M	35M
Details							
Bit diameter ^{1,2}	in.	5/8	3/4	1	1-1/8	1-3/8	1-3/4
h_{nom} std. embed. depth	(mm)	115	145	200	230	260	315
Approx. number of fastenings per cartridge at standard embedment ²							
Small Cartridge		20	17	5	6	3	1
Medium Cartridge		32	28	9	10	5	2
Jumbo Cartridge		98	84	27	31	16	7

- 1 Rebar diameters may vary. Use smallest bit which will accommodate rebar.
- 2 Assumes no waste.

Combined Shear and Tension Loading

$$\left(\frac{N_d}{N_{rec}}\right)^{5/3} + \left(\frac{V_d}{V_{rec}}\right)^{5/3} \leq 1.0 \text{ (Ref. Section 4.1.8.3)}$$

HIT-RE 500 Epoxy Adhesive Anchoring System 4.2.7

HIT-RE 500 Allowable and Ultimate Bond/Concrete Capacity for HAS Rods in Normal Weight Concrete^{1,2,3,4}

Anchor Diameter in (mm)	Embedment Depth in (mm)	HIT-RE 500 Allowable Bond/Concrete Capacity				HIT-RE 500 Ultimate Bond/Concrete Capacity			
		Tensile		Shear		Tensile		Shear	
		$f'_c = 2000$ psi (13.8 MPa) lb (kN)	$f'_c = 4000$ psi (27.6 MPa) lb (kN)	$f'_c = 2000$ psi (13.8 MPa) lb (kN)	$f'_c = 4000$ psi (27.6 MPa) lb (kN)	$f'_c = 2000$ psi (13.8 MPa) lb (kN)	$f'_c = 4000$ psi (27.6 MPa) lb (kN)	$f'_c = 2000$ psi (13.8 MPa) lb (kN)	$f'_c = 4000$ psi (27.6 MPa) lb (kN)
3/8 (9.5)	1-3/4 (44)	645 (2.9)	1095 (4.9)	1510 (6.7)	2135 (9.5)	2580 (11.5)	4370 (19.4)	4530 (20.2)	6405 (28.4)
	3-3/8 (86)	2190 (9.7)	2585 (11.5)	3155 (14.0)	4460 (19.8)	8760 (39.0)	10345 (46.0)	9460 (42.1)	13380 (59.5)
	4-1/2 (114)	2420 (10.8)	2585 (11.5)	4855 (21.6)	6860 (30.5)	9685 (43.1)	10335 (46.0)	14560 (64.8)	20580 (91.5)
1/2 (12.7)	2-1/4 (57)	1130 (5.0)	1965 (8.7)	2510 (11.2)	3550 (15.8)	4530 (20.2)	7860 (35.0)	7525 (33.5)	10640 (47.3)
	4-1/2 (114)	4045 (18.0)	5275 (23.5)	5610 (25.0)	7935 (35.3)	16185 (72.0)	21095 (93.8)	16820 (74.8)	23800 (105.9)
	6 (152)	4775 (21.2)	5380 (23.9)	8635 (38.4)	12210 (54.3)	19095 (84.9)	21520 (95.7)	25900 (115.2)	36620 (162.9)
5/8 (15.9)	2-7/8 (73)	1690 (7.5)	3045 (13.5)	5245 (23.3)	7420 (33.0)	6770 (30.1)	12175 (54.2)	15735 (70.0)	22250 (99.0)
	5-5/8 (143)	6560 (29.2)	7355 (32.7)	8760 (39.0)	12395 (55.1)	26240 (116.7)	29420 (130.9)	26280 (116.9)	37180 (165.4)
	7-1/2 (190)	7320 (32.6)	7515 (33.4)	13615 (60.6)	19080 (84.9)	29290 (130.3)	30060 (133.7)	40480 (180.1)	57240 (254.6)
3/4 (19.1)	3-3/8 (86)	2310 (10.3)	4515 (20.1)	7335 (32.6)	10370 (46.1)	9250 (41.1)	18065 (80.4)	22000 (97.9)	31108 (138.4)
	6-3/4 (172)	8670 (38.6)	10755 (47.8)	12615 (56.1)	17840 (79.4)	34685 (154.3)	43020 (191.4)	37840 (168.3)	53520 (238.1)
	9 (229)	10385 (46.2)	12995 (57.8)	19430 (86.4)	27470 (122.2)	41535 (184.8)	51985 (231.2)	58280 (259.2)	82400 (366.5)
7/8 (22.2)	4 (101)	3005 (13.4)	5665 (25.2)	7795 (34.7)	11020 (49.0)	12030 (53.5)	22670 (100.8)	23375 (104.0)	33050 (147.0)
	7-7/8 (200)	12495 (55.6)	15875 (70.6)	17175 (76.4)	24290 (108.0)	49975 (222.3)	63495 (282.4)	51520 (229.2)	72860 (324.1)
	10-1/2 (267)	14705 (65.4)	16185 (72.0)	26440 (117.6)	37390 (166.3)	58820 (261.6)	64730 (287.9)	79320 (352.8)	112160 (498.9)
1 (25.4)	4-1/2 (114)	3945 (17.5)	8440 (37.5)	10035 (44.6)	14190 (63.1)	15790 (70.2)	33765 (150.2)	30104 (133.9)	42565 (189.3)
	9 (229)	13845 (61.6)	17365 (77.2)	22435 (99.8)	31720 (141.1)	55380 (246.3)	69465 (309.0)	67300 (299.4)	95160 (423.3)
	12 (305)	17935 (79.8)	17935 (79.8)	34535 (153.6)	48830 (217.2)	71740 (319.1)	71740 (319.1)	103600 (460.8)	146480 (651.6)
1-1/4 (31.8)	5-5/8 (143)	5760 (25.6)	12815 (57.0)	14760 (65.7)	20870 (92.8)	23045 (102.5)	51270 (228.1)	44280 (197.0)	62610 (278.5)
	11-1/4 (286)	24610 (109.5)	31620 (140.7)	35050 (155.9)	49570 (220.5)	98430 (437.8)	126480 (562.6)	105140 (467.7)	148710 (661.5)
	15 (381)	34130 (151.8)	35270 (156.9)	53960 (240.0)	76300 (339.4)	136525 (607.3)	141090 (627.6)	161880 (720.1)	228900 (1018.2)

- 1 Influence factors for spacing and/or edge distance are applied to concrete/bond values above, and then compared to the steel value. The lesser of the values is to be used for the design.
- 2 Average ultimate concrete shear capacity based on Concrete Capacity Design (CCD) method for standard and deep embedment and based on testing for shallow embedment.
- 3 All values based on holes drilled with carbide bit and cleaned with brush per manufacturer's instructions. Ultimate tensile concrete/bond loads represent the average values obtained in testing.
- 4 For underwater applications up to 165 feet/50m depth reduce the tabulated concrete/bond values 30% to account for reduced mechanical properties of saturated concrete.

4.2.7 HIT-RE 500 Epoxy Adhesive Anchoring System

Allowable Steel Strength for Carbon Steel & Stainless Steel HAS Rods¹

Rod Diameter in. (mm)	HAS-E Standard ISO 898 Class 5.8		HAS Super ASTM A 193 B7		HAS SS AISI 304/316 SS	
	Tensile lb (kN)	Shear lb (kN)	Tensile lb (kN)	Shear lb (kN)	Tensile lb (kN)	Shear lb (kN)
3/8 (9.5)	2640 (11.7)	1360 (6.0)	4555 (20.3)	2345 (10.4)	3645 (16.2)	1875 (8.3)
1/2 (12.7)	4700 (20.9)	2420 (10.8)	8100 (36.0)	4170 (18.5)	6480 (28.8)	3335 (14.8)
5/8 (15.9)	7340 (32.7)	3780 (16.8)	12655 (56.3)	6520 (29.0)	10125 (45.0)	5215 (23.2)
3/4 (19.1)	10570 (47.0)	5445 (24.2)	18225 (81.1)	9390 (41.8)	12390 (55.1)	6385 (28.4)
7/8 (22.2)	14385 (64.0)	7410 (33.0)	24805 (110.3)	12780 (56.9)	16865 (75.0)	8690 (38.6)
1 (25.4)	18790 (83.6)	9680 (43.0)	32400 (144.1)	16690 (74.2)	22030 (98.0)	11350 (50.5)
1-1/4 (31.8)	29360 (130.6)	15125 (67.3)	50620 (225.2)	26080 (116.0)	34425 (153.1)	17735 (78.9)

¹ Steel strength as defined in AISC Manual of Steel Construction (ASD):

$$\text{Tensile} = 0.33 \times F_u \times \text{Nominal Area}$$

$$\text{Shear} = 0.17 \times F_u \times \text{Nominal Area}$$

Ultimate Steel Strength for Carbon Steel & Stainless Steel HAS Rods¹

Rod Diameter in. (mm)	HAS-E Standard ISO 898 Class 5.8			HAS Super ASTM A 193 B7			HAS SS AISI 304/316 SS		
	Yield lb (kN)	Tensile lb (kN)	Shear lb (kN)	Yield lb (kN)	Tensile lb (kN)	Shear lb (kN)	Yield lb (kN)	Tensile lb (kN)	Shear lb (kN)
3/8 (9.5)	4495 (20.0)	6005 (26.7)	3605 (16.0)	8135 (36.2)	10350 (43.4)	6210 (27.6)	5035 (22.4)	8280 (36.8)	4970 (22.1)
1/2 (12.7)	8230 (36.6)	10675 (47.5)	6405 (28.5)	14900 (66.3)	18405 (79.0)	11040 (49.1)	9225 (41.0)	14720 (65.5)	8835 (39.3)
5/8 (15.9)	13110 (58.3)	16680 (74.2)	10010 (44.5)	23730 (105.6)	28760 (125.7)	17260 (76.8)	14690 (65.3)	23010 (102.4)	13805 (61.4)
3/4 (19.1)	19400 (86.3)	24020 (106.9)	14415 (64.1)	35120 (156.2)	41420 (185.7)	24850 (110.5)	15050 (66.9)	28165 (125.3)	16800 (75.2)
7/8 (22.2)	26780 (119.1)	32695 (145.4)	19620 (87.3)	48480 (215.7)	56370 (256.9)	33825 (150.5)	20775 (92.4)	38335 (170.5)	23000 (102.3)
1 (25.4)	35130 (156.3)	42705 (190.0)	25625 (114.0)	63600 (282.9)	73630 (337.0)	44180 (196.5)	27255 (121.2)	50070 (222.7)	30040 (133.6)
1-1/4 (31.8)	56210 (250.0)	66730 (296.8)	40035 (178.1)	101755 (452.6)	115050 (511.8)	69030 (307.1)	43610 (194.0)	78235 (348.0)	46940 (208.8)

¹ Steel strength as defined in AISC Manual of Steel Construction 2nd Ed. (LRFD):

$$\text{Yield} = F_y \times \text{Tensile Stress Area}$$

$$\text{Tensile} = 0.75 \times F_u \times \text{Nominal Area}$$

$$\text{Shear} = 0.45 \times F_u \times \text{Nominal Area}$$

HIT-RE 500 Epoxy Adhesive Anchoring System 4.2.7

HIT-RE 500 Allowable Bond/Concrete Capacity and Steel Strength for HIS Carbon Steel and HIS-R Stainless Steel Internally Threaded Inserts

Anchor Diameter in. (mm)	Embedment Depth in. (mm)	HIT-RE 500 Allowable Bond/Concrete Capacity ²		Steel Bolt Strength ^{1,2}			
		Tensile $f'_c \geq 2000$ psi (13.8 MPa) lb (kN)	Shear $f'_c \geq 2000$ psi (13.8 MPa) lb (kN)	ASTM A 325 Carbon Steel		ASTM F 593 Stainless Steel	
				Tensile ¹ lb (kN)	Shear ¹ lb (kN)	Tensile ¹ lb (kN)	Shear ¹ lb (kN)
3/8 (9.5)	4-1/4 (108)	2870 (12.8)	1565 (7.0)	4370 (19.4)	2250 (10.0)	3645 (16.2)	1875 (8.3)
1/2 (12.7)	5 (127)	4530 (20.1)	2890 (12.9)	7775 (34.6)	4005 (17.8)	6480 (28.8)	3335 (14.8)
5/8 (15.9)	6-5/8 (168)	8255 (36.7)	4635 (20.6)	12150 (54.0)	6260 (27.8)	10125 (45.0)	5215 (23.2)
3/4 (19.1)	8-1/4 (210)	9030 (40.1)	6695 (29.8)	17945 (77.8)	9010 (40.1)	12395 (55.1)	6385 (28.4)

HIT-RE 500 Ultimate Bond/Concrete Capacity and Steel Strength for HIS Carbon Steel and HIS-R Stainless Steel Internally Threaded Inserts

Anchor Diameter in. (mm)	Embedment Depth in. (mm)	HIT-RE 500 Ultimate Bond/Concrete Capacity ²		Ultimate Bolt Strength ^{1,2}			
		Tensile $f'_c \geq 2000$ psi (13.8 MPa) lb (kN)	Shear $f'_c \geq 2000$ psi (13.8 MPa) lb (kN)	ASTM A 325 Carbon Steel		ASTM F 593 Stainless Steel	
				Tensile ¹ lb (kN)	Shear ¹ lb (kN)	Tensile ¹ lb (kN)	Shear ¹ lb (kN)
3/8 (9.5)	4-1/4 (108)	11480 (51.0)	6260 (27.8)	9935 (44.2)	5960 (26.5)	8280 (36.8)	4970 (22.1)
1/2 (12.7)	5 (127)	18115 (80.5)	11565 (51.4)	17665 (78.6)	10600 (47.2)	14720 (65.5)	8835 (39.3)
5/8 (15.9)	6-5/8 (168)	33025 (146.9)	18550 (82.5)	27610 (122.8)	16565 (73.7)	23010 (102.4)	13805 (61.4)
3/4 (19.1)	8-1/4 (210)	36125 (160.6)	26775 (119.1)	39760 (176.9)	23855 (106.1)	28165 (125.3)	16900 (75.1)

¹ Steel values in accordance with AISC

ASTM A 325 bolts: $F_y = 92$ ksi, $F_u = 120$ ksi
 ASTM F 593 (AISI 304/316): $F_y = 65$ ksi, $F_u = 100$ ksi for 3/8" thru 5/8"
 $F_y = 45$ ksi, $F_u = 85$ ksi for 3/4"

Allowable Load Values

Tension = $0.33 \times F_u \times A_{nom}$

Shear = $0.17 \times F_u \times A_{nom}$

Ultimate Load Values

Tension = $0.75 \times F_u \times A_{nom}$

Shear = $0.45 \times F_u \times A_{nom}$

² Use lower value of either bond/concrete capacity or steel strength.

4.2.7 HIT-RE 500 Epoxy Adhesive Anchoring System

HIT-RE 500 Ultimate Bond Strength and Steel Strength for Rebar in Concrete¹

Nominal Rebar Size	Embed. Depth in. (mm)	Concrete Compressive Strength						Grade 60 Rebar	
		$f'_c = 2000$ psi (13.8 MPa)			$f'_c = 4000$ psi (27.6 MPa)			Yield Strength lb (kN)	Tensile Strength lb (kN)
		Ultimate Bond Strength lb (kN)	Embed. to Develop Yield Strength ¹ in. (mm)	Embed. to Develop Tensile Strength ¹ in. (mm)	Ultimate Bond Strength lb (kN)	Embed. to Develop Yield Strength ¹ in. (mm)	Embed. to Develop Tensile Strength ¹ in. (mm)		
#3	3-3/8 (86)	10105 (45.0)	2-1/4 (57)	3-3/8 (86)	10810 (48.1)	2-1/8 (54)	3-1/4 (84)	6600 (29.4)	9900 (44.0)
	4-1/2 (114)	10920 (48.6)			10810 (48.1)				
#4	4-1/2 (114)	15980 (71.1)	3-3/8 (86)	5-5/8 (143)	18540 (82.5)	3 (76)	4-3/8 (111)	12000 (53.4)	18000 (80.1)
	6 (152)	18830 (83.8)			18655 (83.0)				
#5	5-5/8 (143)	20630 (91.8)	5-1/8 (130)	8-7/8 (225)	27790 (123.6)	3-7/8 (98)	5-3/4 (146)	18600 (82.7)	27900 (124.1)
	7-1/2 (191)	24870 (110.6)			27790 (128.6)				
#6	6-3/4 (171)	33695 (149.9)	5-3/8 (136)	9-3/8 (238)	44675 (198.7)	4 (102)	6 (152)	26400 (117.4)	39600 (176.2)
	9 (229)	38960 (173.3)			44870 (200.0)				
#7	7-7/8 (200)	40525 (180.3)	7 (178)	12-3/8 (314)	59340 (264.0)	4-7/8 (124)	7-1/4 (184)	36000 (160.1)	54000 (240.2)
	10-1/2 (267)	48460 (215.6)			61720 (274.6)				
#8	9 (229)	63940 (284.4)	8-1/4 (210)	12-7/8 (327)	72820 (323.9)	5-7/8 (149)	8-7/8 (225)	47400 (210.9)	71100 (316.3)
	12 (305)	69610 (309.7)			72950 (324.5)				
#9	10-1/8 (257)	72245 (321.4)	8-1/2 (216)	13 (330)	81235 (361.4)	7-1/2 (191)	12 (305)	60000 (266.9)	90000 (400.4)
	13-1/2 (343)	94205 (419.1)			84015 (373.7)				
#10	11-1/4 (286)	92000 (409.3)	9-3/8 (238)	17-7/8 (454)	96725 (430.3)	8-7/8 (225)	14 (356)	76200 (339.0)	114300 (508.5)
	15 (381)	95850 (426.4)			97070 (431.8)				
#11	12-3/8 (314)	118615 (527.6)	9-7/8 (251)	18-3/4 (476)	123120 (547.7)	9-1/2 (241)	16-1/2 (419)	93600 (416.4)	140400 (624.6)
	16-1/2 (419)	123570 (549.7)			123790 (550.7)				

¹ Based on comparison of average ultimate adhesive bond test values versus minimum yield and ultimate tensile strength of rebar. For more information, contact Hilti.

HIT-RE 500 Epoxy Adhesive Anchoring System 4.2.7

HIT-RE 500 Bond Strength and Steel Strength for Metric Rebar in Concrete (Canada Only) 1, 2, 3, 4, 5, 6, 7

Rebar Size	HIT-RE 500 Tensile Bond Strength					Strength Properties of Metric Rebar	
	Embedment Depth mm (in)	$f'_c = 14 \text{ MPa}$		$f'_c = 28 \text{ MPa}$		$f_y = 400 \text{ MPa}$	$f_u = 600 \text{ MPa}$
		Ultimate Bond kN (lb)	Allowable Bond kN (lb)	Ultimate Bond kN (lb)	Allowable Bond kN (lb)	Yield Strength kN (lb)	Tensile Strength kN (lb)
10M	115 (4-1/2)	71.1 (15980)	17.8 (3995)	82.5 (18540)	20.6 (4635)	40 (8990)	60 (13490)
	150 (6)	83.8 (18830)	20.9 (4705)	83.0 (18655)	20.7 (4665)		
15M	145 (5-5/8)	91.8 (20630)	22.9 (5155)	123.7 (27810)	30.9 (6950)	80 (17985)	120 (26975)
	190 (7-1/2)	110.6 (24870)	27.6 (6215)	123.6 (27790)	30.9 (6945)		
20M	200 (7-7/8)	180.3 (40525)	45.1 (10130)	264 (59340)	66 (14835)	120 (26975)	180 (40465)
	265 (10-1/2)	215.6 (48460)	53.9 (12115)	274.6 (61720)	68.6 (15430)		
25M	230 (9)	284.4 (63940)	71.0 (15985)	323.9 (72820)	81.0 (18205)	200 (44960)	300 (67440)
	305 (12)	309.7 (69610)	77.4 (17400)	324.5 (72950)	81.1 (18235)		
30M	260 (10-1/8)	321.4 (72245)	80.3 (18060)	361.4 (81235)	90.3 (20305)	280 (62945)	420 (94415)
	345 (13-1/2)	419.1 (94205)	104.8 (23550)	373.7 (84015)	93.4 (21000)		
35M	315 (12-3/8)	527.6 (118615)	131.9 (29650)	547.7 (123120)	136.9 (30780)	400 (89920)	600 (134880)
	420 (16-1/2)	549.7 (123570)	137.4 (30890)	550.7 (123790)	137.6 (30945)		

1 Based on minimum steel strength and nominal cross-sectional area of rebar.

2 Use lesser value of bond strength or steel strength.

3 Minimum concrete thickness must be equal to 1.5 times the anchor embedment.

4 Testing done with imperial rebar in same size holes.

5 Allowable tension for adhesive bond based on a safety factor of 4.0.

6 For anchor spacing and edge distance guidelines, please refer to the following pages.


7 Ultimate tensile concrete/bond loads represent the average values obtained in testing.

HIT-RE 500 Ultimate Tensile Strength for Smooth Epoxy Coated Dowel Bars in Concrete $\geq 2410 \text{ psi}$ (15.9 MPa)

Anchor Diameter in. (mm)	Drill Bit Diameter in. (mm)	Embedment Depth in. (mm)	Ultimate Tensile Load lb (kN)
1 (25.4)	1-1/8 (29)	9 (229)	40385 (179.7)
1-1/4 (31.8)	1-3/8 (34.9)		
1-1/2 (38.1)	1-5/8 (41)		

4.2.7 HIT-RE 500 Epoxy Adhesive Anchoring System

Anchor Spacing and Edge Distance Guidelines in Concrete

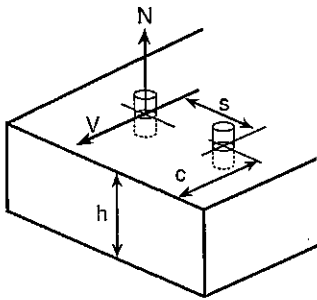

Anchor Spacing Adjustment Factors

s = Actual spacing
 h_{ef} = Actual embedment
 $s_{min} = 0.5 h_{ef}$
 $s_{cr} = 1.5 h_{ef}$

Edge Distance Adjustment Factors

c = Actual edge distance
 h_{ef} = Actual embedment
 $c_{min} = 0.5 h_{ef}$ Tension and shear
 $c_{cr} = 1.5 h_{ef}$ Tension
 $= 2.0 h_{ef}$ Shear
 \perp = Perpendicular to edge
 \parallel = Parallel to edge

Note: Tables apply for listed embedment depths. Reduction factors for other embedment depths must be calculated using equations below.

Spacing Tension/Shear

$s_{min} = 0.5 h_{ef}$, $s_{cr} = 1.5 h_{ef}$
 $f_A = 0.3(s/h_{ef}) + 0.55$
 for $s_{cr} > s > s_{min}$

Edge Distance Tension



$c_{min} = 0.5 h_{ef}$, $c_{cr} = 1.5 h_{ef}$
 $f_{RN} = 0.3(c/h_{ef}) + 0.55$
 for $c_{cr} > c > c_{min}$

Edge Distance Shear (\perp toward edge)

$c_{min} = 0.5 h_{ef}$, $c_{cr} = 2.0 h_{ef}$
 $f_{RV1} = 0.54(c/h_{ef}) - 0.09$
 for $c_{cr} > c > c_{min}$

Edge Distance Shear (\parallel to or away from edge)

$c_{min} = 0.5 h_{ef}$, $c_{cr} = 2.0 h_{ef}$
 $f_{RV2} = 0.36(c/h_{ef}) + 0.28$
 for $c_{cr} > c > c_{min}$

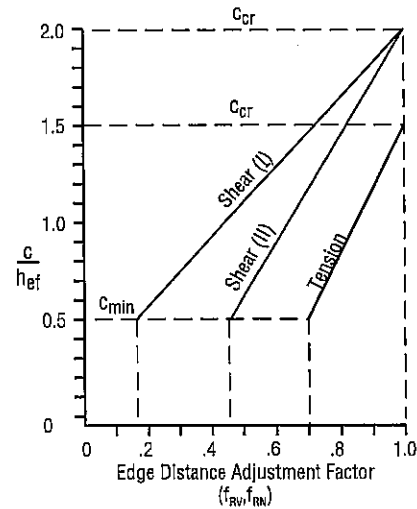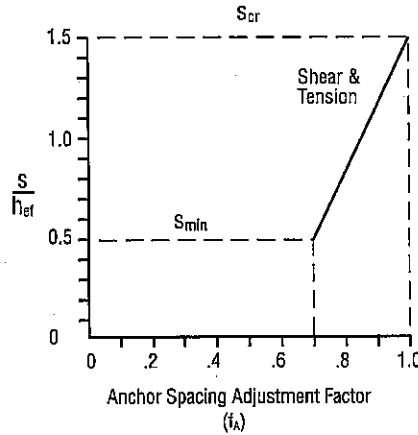

Load Adjustment Factors for 3/8" Diameter Anchor

Anchor Diameter:		3/8" diameter											
Adjustment Factor	Spacing Tension/Shear, f_A			Edge Distance Tension, f_{RN}			Edge Distance Shear, f_{RV1} (\perp toward edge)			Edge Distance Shear, f_{RV2} (\parallel to or away from edge)			
	Embed. Depth (in.)	1-3/4	3-3/8	4-1/2	1-3/4	3-3/8	4-1/2	1-3/4	3-3/8	4-1/2	1-3/4	3-3/8	4-1/2
Spacing (s)/Edge Distance (c), in.	7/8	0.70			0.70			0.18			0.46		
	1	0.72			0.72			0.22			0.49		
	1 11/16	0.84	0.70		0.84	0.70		0.43	0.18		0.63	0.46	
	2	0.89	0.73		0.89	0.73		0.53	0.23		0.69	0.49	
	2 1/4	0.94	0.75	0.70	0.94	0.75	0.70	0.60	0.27	0.18	0.74	0.52	0.46
	2 5/8	1.00	0.78	0.73	1.00	0.78	0.73	0.72	0.33	0.23	0.82	0.56	0.49
	3		0.82	0.75		0.82	0.75	0.84	0.39	0.27	0.90	0.60	0.52
	3 1/2		0.86	0.78		0.86	0.78	1.00	0.47	0.33	1.00	0.65	0.56
	4		0.91	0.82		0.91	0.82		0.55	0.39		0.71	0.60
	5 1/16		1.00	0.89		1.00	0.89		0.72	0.52		0.82	0.69
	5 1/2			0.92			0.92		0.79	0.57		0.87	0.72
	6			0.95			0.95		0.87	0.63		0.92	0.76
6 3/4			1.00			1.00		1.00	0.72		1.00	0.82	
8									0.87			0.92	
9									1.00			1.00	

HIT-RE 500 Epoxy Adhesive Anchoring System 4.2.7

Anchor Spacing and Edge Distance Guidelines in Concrete

Note: Tables apply for listed embedment depths. Reduction factors for other embedment depths must be calculated using equations below.

Load Adjustment Factors for 1/2" Diameter Anchor												
Anchor Diameter: 1/2" diameter												
Adjustment Factor	Spacing Tension/Shear, f_A			Edge Distance Tension, f_{RN}			Edge Distance Shear, f_{RV1} (⊥ toward edge)			Edge Distance Shear, f_{RV2} (∥ to or away from edge)		
Embed. Depth (in.)	2-1/4	4-1/2	6	2-1/4	4-1/2	6	2-1/4	4-1/2	6	2-1/4	4-1/2	6
1												
1-1/8	0.70			0.70			0.18			0.46		
1-1/2	0.75			0.75			0.27			0.52		
1-3/4	0.78			0.78			0.33			0.56		
2	0.82			0.82			0.39			0.60		
2-1/4	0.85	0.70		0.85	0.70		0.45	0.18		0.64	0.46	
2-1/2	0.88	0.72		0.88	0.72		0.51	0.21		0.68	0.48	
3	0.95	0.75	0.70	0.95	0.75	0.70	0.63	0.27	0.18	0.76	0.52	0.46
3-3/8	1.00	0.78	0.72	1.00	0.78	0.72	0.72	0.32	0.21	0.82	0.55	0.48
4		0.82	0.75		0.82	0.75	0.87	0.39	0.27	0.92	0.60	0.52
4-1/2		0.85	0.78		0.85	0.78	1.00	0.45	0.32	1.00	0.64	0.55
5		0.88	0.80		0.88	0.80		0.51	0.36		0.68	0.58
6		0.95	0.85		0.95	0.85		0.63	0.45		0.76	0.64
6-3/4		1.00	0.89		1.00	0.89		0.72	0.52		0.82	0.69
7			0.90			0.90		0.75	0.54		0.84	0.70
8			0.95			0.95		0.87	0.63		0.92	0.76
9			1.00			1.00		1.00	0.72		1.00	0.82
10									0.81			0.88
11									0.90			0.94
12									1.00			1.00

Spacing Tension/Shear

$$s_{min} = 0.5 h_{ef}, s_{cr} = 1.5 h_{ef}$$

$$f_A = 0.3(s/h_{ef}) + 0.55$$

for $s_{cr} > s > s_{min}$

Edge Distance Tension

$$c_{min} = 0.5 h_{ef}, c_{cr} = 1.5 h_{ef}$$

$$f_{RN} = 0.3(c/h_{ef}) + 0.55$$

for $c_{cr} > c > c_{min}$

Edge Distance Shear (⊥ toward edge)

$$c_{min} = 0.5 h_{ef}, c_{cr} = 2.0 h_{ef}$$

$$f_{RV1} = 0.54(c/h_{ef}) - 0.09$$

for $c_{cr} > c > c_{min}$

Edge Distance Shear (∥ to or away from edge)

$$c_{min} = 0.5 h_{ef}, c_{cr} = 2.0 h_{ef}$$

$$f_{RV2} = 0.36(c/h_{ef}) + 0.28$$

for $c_{cr} > c > c_{min}$

Load Adjustment Factors for 5/8" and 3/4" Diameter Anchors																									
Anchor Diameter																									
5/8" diameter										3/4" diameter															
Adjustment Factor	Spacing Tension/Shear, f_A			Edge Distance Tension, f_{RN}			Edge Distance Shear, f_{RV1} (⊥ toward edge)			Edge Distance Shear, f_{RV2} (∥ to or away from edge)			Spacing Tension/Shear, f_A			Edge Distance Tension, f_{RN}			Edge Distance Shear, f_{RV1} (⊥ toward edge)			Edge Distance Shear, f_{RV2} (∥ to or away from edge)			
Embed. Depth (in.)	2-7/8	5-5/8	7-1/2	2-7/8	5-5/8	7-1/2	2-7/8	5-5/8	7-1/2	2-7/8	5-5/8	7-1/2	3-3/8	6-3/4	9	3-3/8	6-3/4	9	3-3/8	6-3/4	9	3-3/8	6-3/4	9	
1-7/16	0.70			0.70			0.18			0.46						0.70			0.70			0.18			0.46
1-11/16	0.73			0.73			0.23			0.49			0.70			0.73			0.73			0.23			0.49
2	0.76			0.76			0.29			0.53			0.73			0.73			0.73			0.29			0.53
2-13/16	0.84	0.70		0.84	0.70		0.44	0.18		0.63	0.46		0.80			0.80			0.80	0.70		0.36			0.58
3-3/8	0.90	0.73		0.90	0.73		0.54	0.23		0.70	0.50		0.85	0.70		0.85	0.70		0.85	0.70		0.45	0.18		0.64
3-3/4	0.94	0.75	0.70	0.94	0.75	0.70	0.61	0.27	0.18	0.75	0.52	0.46	0.88	0.72		0.88	0.72		0.88	0.72		0.51	0.21		0.68
4-5/16	1.00	0.78	0.72	1.00	0.78	0.72	0.72	0.32	0.22	0.82	0.56	0.49	0.93	0.74		0.93	0.74		0.93	0.74		0.60	0.26		0.74
4-1/2		0.79	0.73		0.79	0.73	0.76	0.34	0.23	0.84	0.57	0.50	0.95	0.75	0.70	0.95	0.75	0.70	0.95	0.75	0.70	0.63	0.27	0.18	0.76
5-1/16		0.82	0.75		0.82	0.75	0.86	0.40	0.27	0.91	0.60	0.52	1.00	0.78	0.72	1.00	0.78	0.72	1.00	0.78	0.72	0.72	0.32	0.21	0.82
5-5/8		0.85	0.78		0.85	0.78	0.97	0.45	0.32	0.98	0.64	0.55	1.00	0.74		1.00	0.74		1.00	0.74		0.81	0.36	0.25	0.88
5-3/4		0.86	0.78		0.86	0.78	1.00	0.46	0.32	1.00	0.65	0.56	1.00	0.74		1.00	0.74		1.00	0.74		0.83	0.37	0.26	0.89
6-3/4		0.91	0.82		0.91	0.82		0.56	0.40		0.71	0.60	0.85	0.78		0.85	0.78		0.85	0.78		1.00	0.45	0.32	1.00
8-7/16		1.00	0.89		1.00	0.89		0.72	0.52		0.82	0.69	0.93	0.83		0.93	0.83		0.93	0.83		0.59	0.42		0.73
10-1/8			0.96			0.96		0.88	0.64		0.93	0.77	1.00	0.89		1.00	0.89		1.00	0.89		0.72	0.52		0.82
11-1/4			1.00			1.00		1.00	0.72		1.00	0.82		0.93			0.93			0.93		0.81	0.59		0.88
12									0.77			0.86		0.95			0.95			0.95		0.87	0.63		0.92
13-1/2									0.88			0.93		1.00			1.00			1.00		1.00	0.72		1.00
15									1.00			1.00										0.81			0.88
16																						0.87			0.92
18																						1.00			1.00

4.2.7 HIT-RE 500 Epoxy Adhesive Anchoring System

Anchor Spacing and Edge Distance Guidelines in Concrete

Note: Tables apply for listed embedment depths. Reduction factors for other embedment depths must be calculated using equations below.

Load Adjustment Factors for 7/8" Diameter Anchor													
Anchor Diameter:		7/8" diameter											
Adjustment Factor	Spacing Tension/Shear, f_A			Edge Distance Tension, f_{RN}			Edge Distance Shear, f_{RV1} (⊥ toward edge)			Edge Distance Shear, f_{RV2} (to or away from edge)			
	Embed. Depth (in.)	4	7-7/8	10-1/2	4	7-7/8	10-1/2	4	7-7/8	10-1/2	4	7-7/8	10-1/2
Spacing (s)/Edge Distance (c), in.	2	0.70			0.70			0.18			0.46		
	2-1/2	0.74			0.74			0.25			0.51		
	3	0.78			0.78			0.32			0.55		
	3-1/2	0.81			0.81			0.38			0.60		
	3-15/16	0.85	0.70		0.85	0.70		0.44	0.18		0.63	0.46	
	4-1/2	0.89	0.72		0.89	0.72		0.52	0.22		0.69	0.49	
	5	0.93	0.74		0.93	0.74		0.59	0.25		0.73	0.51	
	5-1/4	0.94	0.75	0.70	0.94	0.75	0.70	0.62	0.27	0.18	0.75	0.52	0.46
	6	1.00	0.78	0.72	1.00	0.78	0.72	0.72	0.32	0.22	0.82	0.55	0.49
	6-1/2		0.80	0.74		0.80	0.74	0.79	0.36	0.24	0.87	0.58	0.50
	7		0.82	0.75		0.82	0.75	0.86	0.39	0.27	0.91	0.60	0.52
	8		0.85	0.78		0.85	0.78	1.00	0.46	0.32	1.00	0.65	0.55
	10		0.93	0.84		0.93	0.84		0.60	0.42		0.74	0.62
	11-13/16		1.00	0.89		1.00	0.89		0.72	0.52		0.82	0.69
	12			0.89			0.89		0.73	0.53		0.83	0.69
	14			0.95			0.95		0.87	0.63		0.92	0.76
	15-3/4			1.00			1.00		1.00	0.72		1.00	0.82
	18									0.84			0.90
	20									0.94			0.97
	21									1.00			1.00

Spacing Tension/Shear

$$s_{min} = 0.5 h_{ef}, s_{cr} = 1.5 h_{ef}$$

$$f_A = 0.3 (s/h_{ef}) + 0.55$$

for $s_{cr} > s > s_{min}$

Edge Distance Tension

$$c_{min} = 0.5 h_{ef}, c_{cr} = 1.5 h_{ef}$$

$$f_{RN} = 0.3 (c/h_{ef}) + 0.55$$

for $c_{cr} > c > c_{min}$

Edge Distance Shear (⊥ toward edge)

$$c_{min} = 0.5 h_{ef}, c_{cr} = 2.0 h_{ef}$$

$$f_{RV1} = 0.54 (c/h_{ef}) - 0.09$$

for $c_{cr} > c > c_{min}$

Edge Distance Shear (|| to or away from edge)

$$c_{min} = 0.5 h_{ef}, c_{cr} = 2.0 h_{ef}$$

$$f_{RV2} = 0.36 (c/h_{ef}) + 0.28$$

for $c_{cr} > c > c_{min}$

Load Adjustment Factors for 1" and 1-1/4" Diameter Anchors																									
Anchor Diameter:		1" diameter											1-1/4" diameter												
Adjustment Factor	Spacing Tension/Shear, f_A			Edge Distance Tension, f_{RN}			Edge Distance Shear, f_{RV1} (⊥ toward edge)			Edge Distance Shear, f_{RV2} (to or away from edge)			Spacing Tension/Shear, f_A			Edge Distance Tension, f_{RN}			Edge Distance Shear, f_{RV1} (⊥ toward edge)			Edge Distance Shear, f_{RV2} (to or away from edge)			
	Embed. Depth (in.)	4-1/2	9	12	4-1/2	9	12	4-1/2	9	12	4-1/2	9	12	5-5/8	11-1/4	15	5-5/8	11-1/4	15	5-5/8	11-1/4	15	5-5/8	11-1/4	15
Spacing (s)/Edge Distance (c), in.	2-1/4	0.70			0.70			0.18			0.46														
	2-3/4	0.73			0.73			0.24			0.50			0.70			0.70			0.18			0.46		
	3	0.75			0.75			0.27			0.52			0.71			0.71			0.20			0.47		
	4	0.82			0.82			0.39			0.60			0.76			0.76			0.29			0.54		
	4-1/2	0.85	0.70		0.85	0.70		0.45	0.18		0.64	0.46		0.79			0.79			0.34			0.57		
	5	0.88	0.72		0.88	0.72		0.51	0.21		0.68	0.48		0.82			0.82			0.39			0.60		
	5-5/8	0.93	0.74		0.93	0.74		0.59	0.25		0.73	0.51		0.85	0.70		0.85	0.70		0.45	0.18		0.64	0.46	
	6	0.95	0.75	0.70	0.95	0.75	0.70	0.63	0.27	0.18	0.76	0.52	0.46	0.87	0.71		0.87	0.71		0.49	0.20		0.66	0.47	
	6-3/4	1.00	0.78	0.72	1.00	0.78	0.72	0.72	0.32	0.21	0.82	0.55	0.48	0.91	0.73		0.91	0.73		0.56	0.23		0.71	0.50	
	7-1/2		0.80	0.74		0.80	0.74	0.81	0.36	0.25	0.88	0.58	0.51	0.95	0.75	0.70	0.95	0.75	0.70	0.63	0.27	0.18	0.76	0.52	0.46
	8-1/4		0.83	0.76		0.83	0.76	0.90	0.41	0.28	0.94	0.61	0.53	0.99	0.77	0.72	0.99	0.77	0.72	0.70	0.31	0.21	0.81	0.54	0.48
	9		0.85	0.78		0.85	0.78	1.00	0.45	0.32	1.00	0.64	0.55	0.79	0.73		0.79	0.73	0.77	0.34	0.23	0.86	0.57	0.50	
	10		0.88	0.80		0.88	0.80		0.51	0.36		0.68	0.58	0.82	0.75		0.82	0.75	0.87	0.39	0.27	0.92	0.60	0.52	
	11		0.92	0.83		0.92	0.83		0.57	0.41		0.72	0.61	0.84	0.77		0.84	0.77	1.00	0.44	0.31	0.98	0.63	0.54	
	12		0.95	0.85		0.95	0.85		0.63	0.45		0.76	0.64	0.87	0.79		0.87	0.79		0.49	0.34		0.66	0.57	
	13-1/2			1.00	0.89		1.00	0.89		0.72	0.52		0.82	0.69		0.91	0.82		0.91	0.82		0.56	0.40	0.71	0.60
	14				0.90			0.90		0.75	0.54		0.84	0.70		0.92	0.83		0.92	0.83		0.58	0.41	0.73	0.62
	16-7/8				0.97			0.97		0.92	0.67		0.96	0.79		1.00	0.89		1.00	0.89		0.72	0.52	0.82	0.69
	18				1.00			1.00		1.00	0.72		1.00	0.82		0.91			0.91			0.77	0.56	0.86	0.71
	20									0.81			0.88			0.95			0.95			0.87	0.63	0.92	0.76
	22-1/2									0.92			0.96			1.00			1.00			1.00	0.72	1.00	0.82
24									1.00			1.00			1.00			1.00			0.77			0.86	
27																					0.88			0.93	
30																					1.00			1.00	

HIT-RE 500 Epoxy Adhesive Anchoring System 4.2.7

Resistance of HIT-RE 500 to Chemicals

Chemical	Chemicals Tested	Resistant	Not Resistant
Alkalinize (Base material concrete)	Concrete drilling mud (10%) pH=12.6	+	
	Concrete drilling mud (10%) pH=13.2	+	
	Concrete potash solution (10%) pH=14.0	+	
Acids	Acetic acid (10%)	concrete was dissolved by acid	-
	Nitric acid (10%)		-
	Hydrochloric acid (10%) 3 month -		-
	Sulfuric acid (10%)		-
Solvents	Benzyl alcohol		-
	Ethanol		-
	Ethyl acetate		-
	Methyl ethyl ketone (MEK)		-
	Trichlorethylene		-
	Xylene (mixture)	+	
Chemicals used on job sites	Concrete plasticizer	+	
	Diesel oil	+	
	Oil	+	
	Petrol	+	
	Oil for form work (forming oil)	+	
Environmental Chemicals	Salt water	+	
	de-mineralized water	+	
	salt spraying test	+	
	SO ₂	+	
	Environment / Weather	+	

Samples of the HIT-RE 500 resin were immersed in the various chemical compounds for up to one year. At the end of the test period, the samples were analyzed. Any samples showing no visible damage and having less than a 25% reduction in bending (flexural) strength were classified as "Resistant." Samples that were heavily damaged or destroyed were classified as "Not Resistant."

Note: In actual use, the majority of the resin is encased in the base material, leaving very little surface area exposed.

Full Cure Time Table1 (100% of working load)

Base Material Temperature		Approx. Full Curing Time
°F	°C	
23	-5	72 hours
32	0	50 hours
50	10	24 hours
68	20	12 hours
86	30	8 hours
104	40	4 hours

Initial Cure Time Table1 (25% of working load)


Base Material Temperature		Approx. Initial Cure Time
°F	°C	
23	-5	36 hours
32	0	25 hours
50	10	12 hours
68	20	6 hours
86	30	4 hours
104	40	2 hours

Gel Time Table1 (Approximate)

Base Material Temperature		Approx. Gel Time
°F	°C	
23	-5	4 hours
32	0	3 hours
50	10	2 hours
68	20	30 minutes
86	30	20 minutes
104	40	12 minutes

1 Minimum product temperature must be maintained above 41°F (5°C) prior/during installation.

Influence of Temperature on Bond Strength

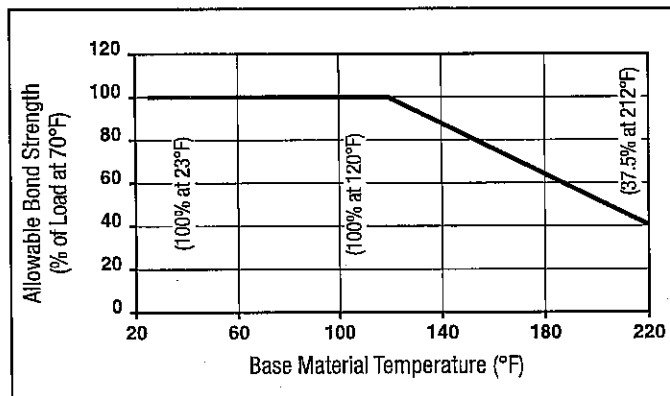


Note: Test procedure involves the concrete being held at the elevated temperature for 24 hours then removing it from the controlled environment and testing to failure.


Long term creep test in accordance with AC58 is available; please contact Hilti Technical Services.

4.2.7 HIT-RE 500 Epoxy Adhesive Anchoring System

4.2.7.4 Installation Instructions

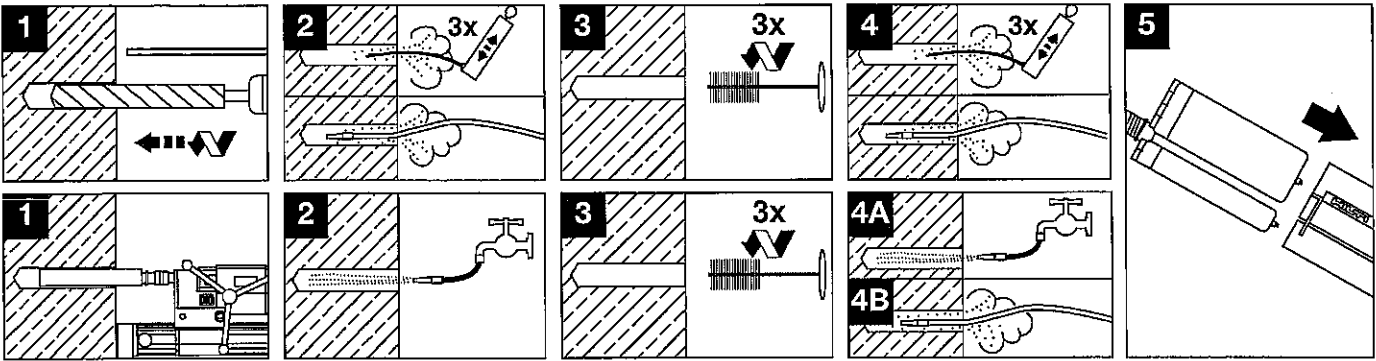


1. Drill anchor hole using carbide or diamond core bits.
2. Insert air nozzle to bottom of hole and blow out hole using a pump, or compressed air. For underwater applications and diamond coring, flush until water runs clear from hole.
3. Clean hole with a nylon or wire brush. Proper hole cleaning is essential.
4. Insert air nozzle to bottom of hole and blow out hole using a pump, or compressed air. For underwater applications and diamond coring, flush until water runs clear from hole. Remove water (e.g. vacuum or comp. air).
5. Insert refill pack into holder. Remove cap covering threaded projection.

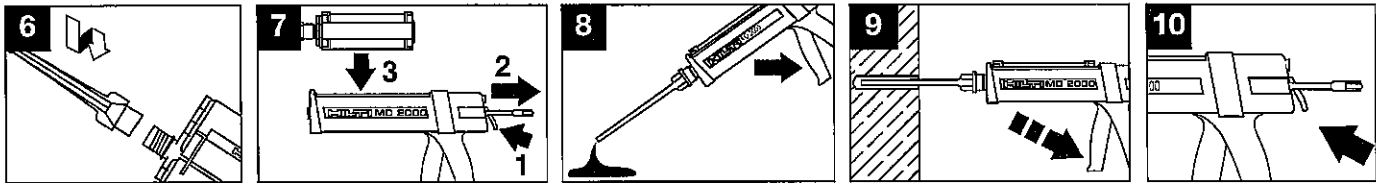


6. Screw on static mixer.
7. Put holder into dispenser.
8. Discard first three trigger pulls of adhesive from each refill pack or cartridge.
9. Inject adhesive into hole starting at the bottom until 1/2 to 2/3 full. Use mixer filler tube extensions when needed to reach the hole bottom.
10. Unlock dispenser


Rod

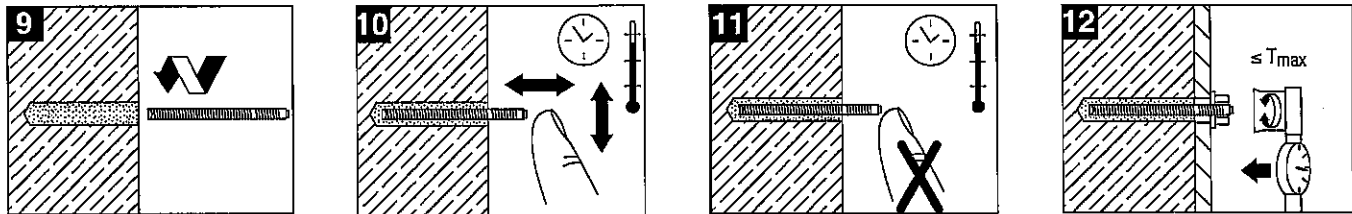

Insert

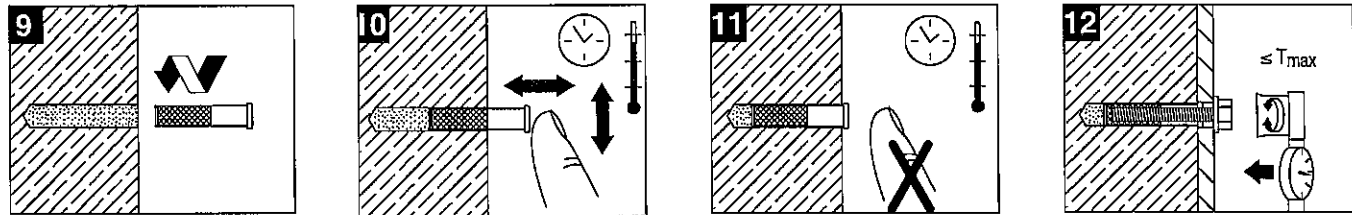

Rebar

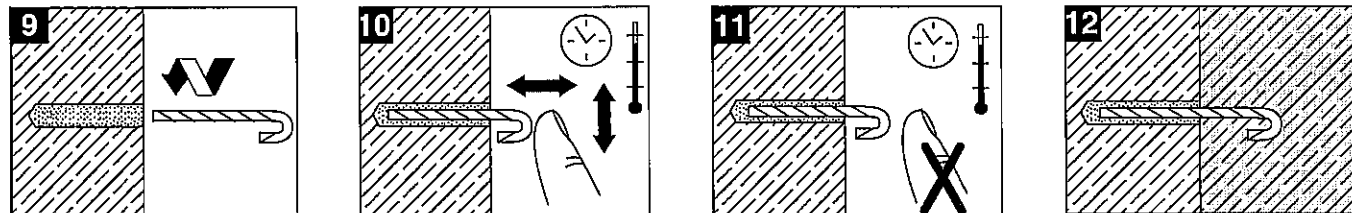

9. Insert rod, threaded insert or rebar. Twist during installation.
10. Fastener may be adjusted during specified gel time.
11. Do not disturb anchor between specified gel time and initial cure time. At the initial cure time the fastener has 25% of full working load. Work may proceed (e.g. tying rebar, setting steel) which will not exceed 25% of the full working load. Do not torque anchor.
12. After full cure time, apply specified torque as required to secure items to be fastened. Do not exceed maximum torque specified.

HIT-RE 500 Epoxy Adhesive Anchoring System 4.2.7

HIT HIT-RE 500 Volume Charts

Threaded Rod Installation

Rod Diameter (in.)	Drill Bit ¹ Diameter (in.)	Adhesive Volume Required per Inch of embedment (in ³)
1/4	5/16	0.055
3/8	7/16	0.095
1/2	9/16	0.133
5/8	3/4	0.261
3/4	7/8	0.326
7/8	1	0.391
1	1-1/8	0.478
1-1/4	1-3/8	0.626

EXAMPLE:

Determine approximate fastenings for 5/8" rod embedded 10" deep.

$$10 \times 0.261 = 2.61 \text{ in}^3 \text{ of adhesive per anchor}$$

$$16.5 \div 2.61 = 6 \text{ fastenings per small cartridge}$$

$$81.8 \div 2.61 = 31 \text{ fastenings per jumbo cartridge}$$

Rebar Installation

Rod Diameter (in.)	Drill Bit ¹ Diameter (in.)	Adhesive Volume Required per Inch of embedment (in ³)
#3 or 3/8	1/2	0.110
#4 or 1/2	5/8	0.146
#5 or 5/8	3/4	0.176
#6 or 3/4	7/8	0.218
#7 or 7/8	1	0.252
#8 or 1	1-1/8	0.299
#9 or 1-1/8	1-3/8	0.601
#10 or 1-1/4	1-1/2	0.659
#11 or 1-3/8	1-3/4	1.037


NOTE: Useable volume of HIT-RE 500 refill cartridge is 16.5 in³ (270 ml).
Useable volume of HIT-RE 500 medium refill cartridge is 26.9 in³ (440 ml).
Useable volume of HIT-RE 500 jumbo refill cartridge is 81.8 in³ (1340 ml).

Metric Rebar Installation (Canada Only)

Bar Diameter	Drill Bit ¹ Diameter (in.)	Adhesive Volume Required per Inch of embedment (in ³)
10M	5/8	0.186
15M	3/4	0.170
20M	1	0.388
25M	1-1/8	0.289
30M	1-3/8	0.481
35M	1-3/4	0.996

¹ Rebar diameter may vary. Use smallest drill bit which will accommodate rebar.

4.2.7.5 Ordering Information

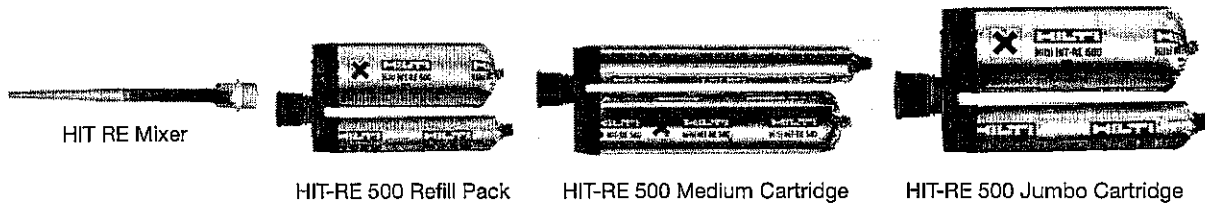

HIT Adhesives

Item No.	Description
340225	HIT-RE 500 11.1 oz (330 ml) Includes (1) Refill Pack and (1) Mixer with filler tube
369251	HIT-RE 500 MC 11.1 oz (330 ml) Includes (25) Refill Packs and (25) Mixers with filler tube
369110	HIT-RE 500 Medium 16.9 oz (500 ml) Includes (20) Refill Packs and (20) Mixers with filler tube
373958	HIT-RE 500 Jumbo 47.3 oz (1400 ml) Includes (4) Jumbo Refill Packs and (4) Mixers

4.2.7 HIT-RE 500 Epoxy Adhesive Anchoring System

Dispensers

Battery Powered

Item No.	Ordering designation	
3245363	ED3500 2.0 Ah kit	①

Manual


Item No.	Ordering designation	
371291	MD 1000 Manual Dispenser for HIT-ICE	②
229154	MD 2000 dispenser — includes foil pack holder	③
338853	MD 2500 Manual Dispenser	④
229170	Refill Holder Replacement for MD2000, ED 3500 or P-3000HY dispensers	⑤

Pneumatic Dispenser with 1/4" internally threaded compressed air coupling

Item No.	Ordering designation	
354180	P-3500 dispenser (for foil packs)	⑥
373959	HIT-P8000D pneumatic dispenser (for jumbo cartridges)	⑦
373960	Jumbo pack holder replacement for P8000D	

Mixers and Filler Tubes

Item No.	Ordering designation	Qty/pkg
337111	HIT-RE-M static mixer (suitable for foil pack and jumbo cartridges)	1

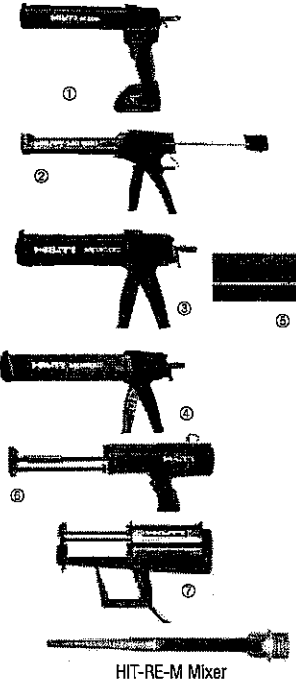

HIT-RE 500 Epoxy Adhesive Anchoring System 4.2.7



Threaded Rods

HAS Rods 5.8				HAS Super A193, B7 High Strength Rods			HAS-R Rods 304 Stainless Steel			HAS-R Rods 316 Stainless Steel		
Item No. (Box)	Master Carton (MC)	Description (in.)	Qty Box/MC	Item No.	Description	Qty Box	Item No.	Description	Qty Box	Item No.	Description	Qty Box
385417	3432178	3/8 x 3	10/360									
385418	3432179	3/8 x 4-3/8	10/240									
385419	3432180	3/8 x 5-1/8	20/240	68657	3/8x5-1/8	10	385462	3/8x5-1/8	10	3024335	3/8x5-1/8	1
385420	3432181	3/8-8	10/160				385463	3/8 x 8	10			
385421	3432182	3/8 x 12	10/90									
385422	3432183	1/2 x 3-1/8	10/240									
385423	3432184	1/2 x 4-1/2	10/160									
385424	3432185	1/2 x 6-1/2	20/160	68658	1/2x6-1/2	10	385464	1/2x6-1/2	10	3024336	1/2x6-1/2	1
385425	3432239	1/2 x 8	10/120				385465	1/2x8	1			
385426	3432186	1/2 x 10	10/120				385466	1/2x10	1			
										3024337	1/2x11	1
385427	3432187	1/2 x 12	10/80									
385428	3432188	5/8 x 8	20/80	333783	5/8x7-5/8	10	385467	5/8x7-5/8	10	333781	5/8x7-5/8	10
							385468	5/8x10	1			
385429	3432189	5/8 x 9	10/60							3024338	5/8x9	1
385430	3432190	5/8 x 12	10/60							3024339	5/8x12	1
385431	3432191	5/8 x 17	10/40									
385432	3432052	3/4 x 10	10/40	68660	3/4x9-5/8	5	385469	3/4x9-5/8	5	3024340	3/4x9-5/8	1
385433	3432163	3/4 x 11	10/30									
385434	3432164	3/4 x 12	10/30				385470	3/4x12	1			
385435	3432165	3/4 x 14	10/30	3006083	3/4 x 14	5	385471	3/4x14	1			
							385472	3/4x16	1			
385436	3432166	3/4 x 17	10/20									
385437	3432167	3/4 x 19	10/20									
385438	3432168	3/4 x 21	10/20									
385439	3432169	3/4 x 25	10/20									
385440	3432170	7/8 x 10	10/20	68661	7/8x10 (HDG) ¹	5	385473	7/8x10	1			
				3006077	7/8x12 (HDG) ¹	5						
385441	3432171	7/8 x 13	10/20	45259	7/8x16 (HDG) ¹	5						
385442	3432172	1 x 12	4/16	68662	1x12	5	385474	1x12	1	3024341	1x12	4/16
385443	3432173	1 x 14	2/16	3006079	1x14	5						
385444	3432174	1 x 16	2/12	3006080	1x16	5						
385445	3432175	1 x 20	2/12	3006081	1x21	5						
385446	3432176	1-1/4 x 16	4/8	333779	1-1/4x16	4						
385447	3432177	1-1/4 x 22	4/8									
				3006082	1-1/4x23	5						

1 Hot dipped galvanized (7/8" rod only). Coating thickness 2 mils (50.8 µm).



HIS Internally Threaded Inserts

HIS Item No.	HIS-R Item No.	Description	Useable Thread Length (in.)	Qty Box
258020	258029	3/8x4-1/4	1	10
258021	258030	1/2x5	1-3/16	5
258022	258031	5/8x6-5/8	1-1/2	5
258023	258032	3/4x8-1/4	2	5

In The United States

PAYMENT TERMS:	Net 30 days from date of invoice. Customer agrees to pay all costs incurred by Hilti in collecting any delinquent amounts, including attorney's fees.
FREIGHT:	All sales are F.O.B. Destination with transportation allowed via Hilti designated mode. Delivery dates are estimates only. Additional charges for expedited shipments, special handling requirements, and orders below certain dollar amounts shall be the responsibility of Customer. Fuel surcharges may apply depending on market conditions.
CREDIT:	All orders sold on credit are subject to Credit Department approval.
RETURN POLICY:	Products must be in saleable condition to qualify for return. Saleable condition is defined as unused items in original undamaged packaging and unbroken quantities and in as-new condition. All returns are subject to Hilti inspection and acceptance, and a \$125 restocking charge if returned more than 90 days after invoice date. Proof of purchase is required for all returned materials. Special orders products and discontinued items are not eligible for return credit. Dated materials are only returnable in case quantity, and within 30 days after invoice date.
WARRANTY:	<p>Hilti warrants that for a period of 12 months from the date it sells a product it will, at its sole option and discretion, refund the purchase price, repair, or replace such product if it contains a defect in material or workmanship. Absence of Hilti's receipt of notification of any such defect within this 12-month period shall constitute a waiver of all claims with regard to such product.</p> <p>THE FOREGOING WARRANTY IS IN LIEU OF ALL OTHER WARRANTIES, EXPRESS OR IMPLIED, INCLUDING BUT NOT LIMITED TO THE IMPLIED WARRANTIES OF MERCHANTABILITY AND FITNESS FOR A PARTICULAR PURPOSE. Hilti shall in no event be liable for, and Customer hereby agrees to indemnify Hilti against all claims related to special, direct, indirect, incidental, consequential, or any other damages arising out of or related to the sale, use, or inability to use the product.</p>
ACCEPTANCE OF ORDER:	Acceptance is limited to the express terms contained herein, and terms are subject to change by Hilti without notice. Additional or different terms proposed by Customer are deemed material and are objected to and rejected, but such rejection shall not operate as a rejection of the offer unless it contains variances in the terms of the description, quantity, price or delivery schedule of the goods. Orders are not deemed "accepted" by Hilti unless and until it ships the associated items.
DOMESTIC ORIGIN:	Any non-domestic Hilti product will be so identified on shipping documents and invoices for customers who properly identify themselves as a federal government entity. All other customers may obtain such information by written request to Hilti, Inc., Contract Compliance, P.O. Box 21148, Tulsa, Oklahoma 74121. Hilti's Quality Department personnel are the only individuals authorized to warrant the country of origin of Hilti products.
BUSINESS SIZE:	Hilti is a large business.
PRICES:	Prices are those stated on the order, and unless otherwise noted are based on purchasing all items on the order — pricing for individual products may vary for purchases of different quantities or item combinations. Hilti does not maintain most favored customer records, makes no representation with respect to same, and rejects any price warranty terms proposed by Customer. Hilti's published net price list is subject to change without notice.
CONSENT TO JURISDICTION:	All transactions made pursuant hereto shall be deemed to have been made and entered into in Tulsa, Oklahoma. Any and all disputes arising directly or indirectly from such transactions shall be resolved in the courts of the County of Tulsa, State of Oklahoma, to the exclusion of any other court, and any resulting judgment may be enforced by any court having jurisdiction of such an action. All transactions shall be governed by and construed in accordance with the laws of the State of Oklahoma.
INDEMNIFICATION:	Customer hereby agrees to indemnify Hilti for any costs, including attorney's fees, incurred by Hilti as a result, in whole or in part, of any violation by Customer of any Federal, State or Local statute or regulation, or of any nationally accepted standard. It shall be Customer's sole responsibility to comply with all applicable laws and regulations regarding the handling, use, transportation, or disposal of products upon taking possession of same.
AUTHORIZATION:	HILTI LEGAL DEPARTMENT PERSONNEL ARE THE ONLY INDIVIDUALS AUTHORIZED TO MODIFY THESE TERMS AND CONDITIONS, WARRANT PRODUCT SUITABILITY FOR SPECIFIC APPLICATIONS, OR EXECUTE CUSTOMER DOCUMENTS, AND ANY SUCH ACTION IS NULL AND VOID UNLESS IN WRITTEN FORM SIGNED BY SUCH INDIVIDUAL.

In Canada

PAYMENT TERMS:	Net 30 days from date of invoice. Customer agrees to pay all costs incurred by Hilti in collecting delinquent amounts, if any, including reasonable attorney's fees.
FREIGHT:	Sales are F.O.B. Destination Point with transportation allowed via Hilti designated mode. Additional charges may apply for expedited delivery, special handling requirements, and order under certain limits. A fuel surcharge may apply depending on market conditions.
CREDIT:	All orders sold on credit are subject to Credit Department approval.
RETURN POLICY:	Product may be returned prepaid (unless otherwise authorized) to Hilti provided: <ul style="list-style-type: none"> i) it is returned by the original purchaser ii) it is not dated product returned more than 30 days after the original delivery date iii) it is not discontinued, clearance or special order product iv) it is unused, in original packaging and in unbroken quantities. <p>Hilti will inspect product and, if the above requirements are satisfied, will credit to customer the original purchase price. A 15% restocking fee may apply.</p>
WARRANTY:	Other than the manufacturer's published warranty, no warranties or conditions, express or implied, written or oral, statutory or otherwise are implied. Any and all conditions and warranties implied by law or by the Sale of Goods Act or any similar statutes of any Province are hereby expressly waived.
TITLE TO PRODUCT:	Title to product remains with Hilti until the total purchase price of product is paid.
PRICES:	Customer agrees to pay Hilti prices set out on invoice. Customer agrees to pay taxes as indicated on invoice unless Hilti receives acceptable exemption certificates.
INDEMNIFICATION:	Customer agrees to use product at own risk and to indemnify Hilti against all liabilities, including legal fees, to third parties arising out of the use or possession thereof. Hilti shall in no event be liable for special, incidental or consequential damages.
CHANGES:	Hilti sales personnel are not authorized to modify these Terms and Conditions or modify Customer's credit terms. Terms are subject to change by Hilti with reasonable notice to Customer.
CASH SALES:	Payment in full is due prior to goods being released.
QUOTATIONS:	All terms and conditions apply once customer agrees to purchase product. Quotations on special promotion products are only valid until end of promotion period.

ATEC Associates, Inc.



5150 East 65th Street
Indianapolis, Indiana 46220-4871
317-849-4990
Telex 232 0055 ASAS

Corporate Office:
Indianapolis, IN

Offices:
Atlanta, GA
Baltimore, MD
Birmingham, AL
Calumet City, IL
Chicago, IL
Cincinnati, OH
Dallas, TX
Dayton, OH
Denver, CO
Des Moines, IA
Gary, IN
Gaithersburg, MD
Harrisburg, PA
Huntsville, AL
Lexington, KY
Louisville, KY
Newport, NC
Raleigh, NC
Sarasota, MD
Savannah, GA
Washington, DC

February 10, 1986

Tuttle Aluminum and Bronze Company
120 Shadow Lawn Drive
Noblesville, Indiana 46060

ATTN: Mr. Doug Waugh

RE: Load Testing of Aluminum Hand
Rail Structure - TABCO 2500
Tuttle Aluminum and Bronze Company
Noblesville, Indiana
ATEC Job No. 21-62016

Affiliates:
Alexandria, VA
Norfolk, VA

Gentlemen:

Submitted herewith are results of load testing of an aluminum hand rail structure at the referenced site. This testing was performed on February 7, 1986 on the railing configuration noted below.

Three independent loads were applied to the rail structure. (See attached sketch of the rail structure) The loads were applied horizontally at a midspan, horizontally at a post and vertically at a midspan. The load was applied by a hydraulic jack attached to a fork lift. A calibrated proving ring was attached to the rail at loading locations for measurement of load. The loads were then applied by jacking the pump against the proving ring until the desired load was reached.

Deflection readings were made at maximum loading (200#) and then again after release of load to determine any permanent deflection. This was measured as deflection of the top rail horizontally (for horizontal loading) and the top rail vertically (for vertical loading).

The following is the construction description of the TABCO 2500 - Mechanical Connections railing system:

February 10, 1986
Tuttle Aluminum & Bronze
Page 2


TABCO 2500 CONSTRUCTION

Aluminum rail was constructed of 1-1/2" (Sch 40) aluminum pipe, top, intermediate, and post. All pipe to pipe connections were mechanically attached with fittings and rivets. The posts were welded to 3/8" X 2-1/2" x 6" aluminum base plates and mounted to a concrete floor with two (2) 3/8" x 2-3/4" stainless steel TRUBOLTS.

We appreciate the opportunity to be of service to you on this project. If you have any questions, please give me a call at this office.

Very truly yours;

A TEC ASSOCIATES, INC.


Thomas J. Struewing
Project Engineer


TJS/cas

Load Test of Aluminum Railing
Tuttle Aluminum and Bronze Company
Noblesville, Indiana
ATEC Job No. 21-62016

TABCO 2500 - Mechanical Connections
Deflection Permanent Set *

Horizontal load at Midspan = 200# (Fh)	1-9/16"	1/16"
Vertical Load at Midspan = 200# (Fv)	0.127"	0.00"
Horizontal Load at Post = 200# (P)	1-5/16"	0"

* Deflection after release of load

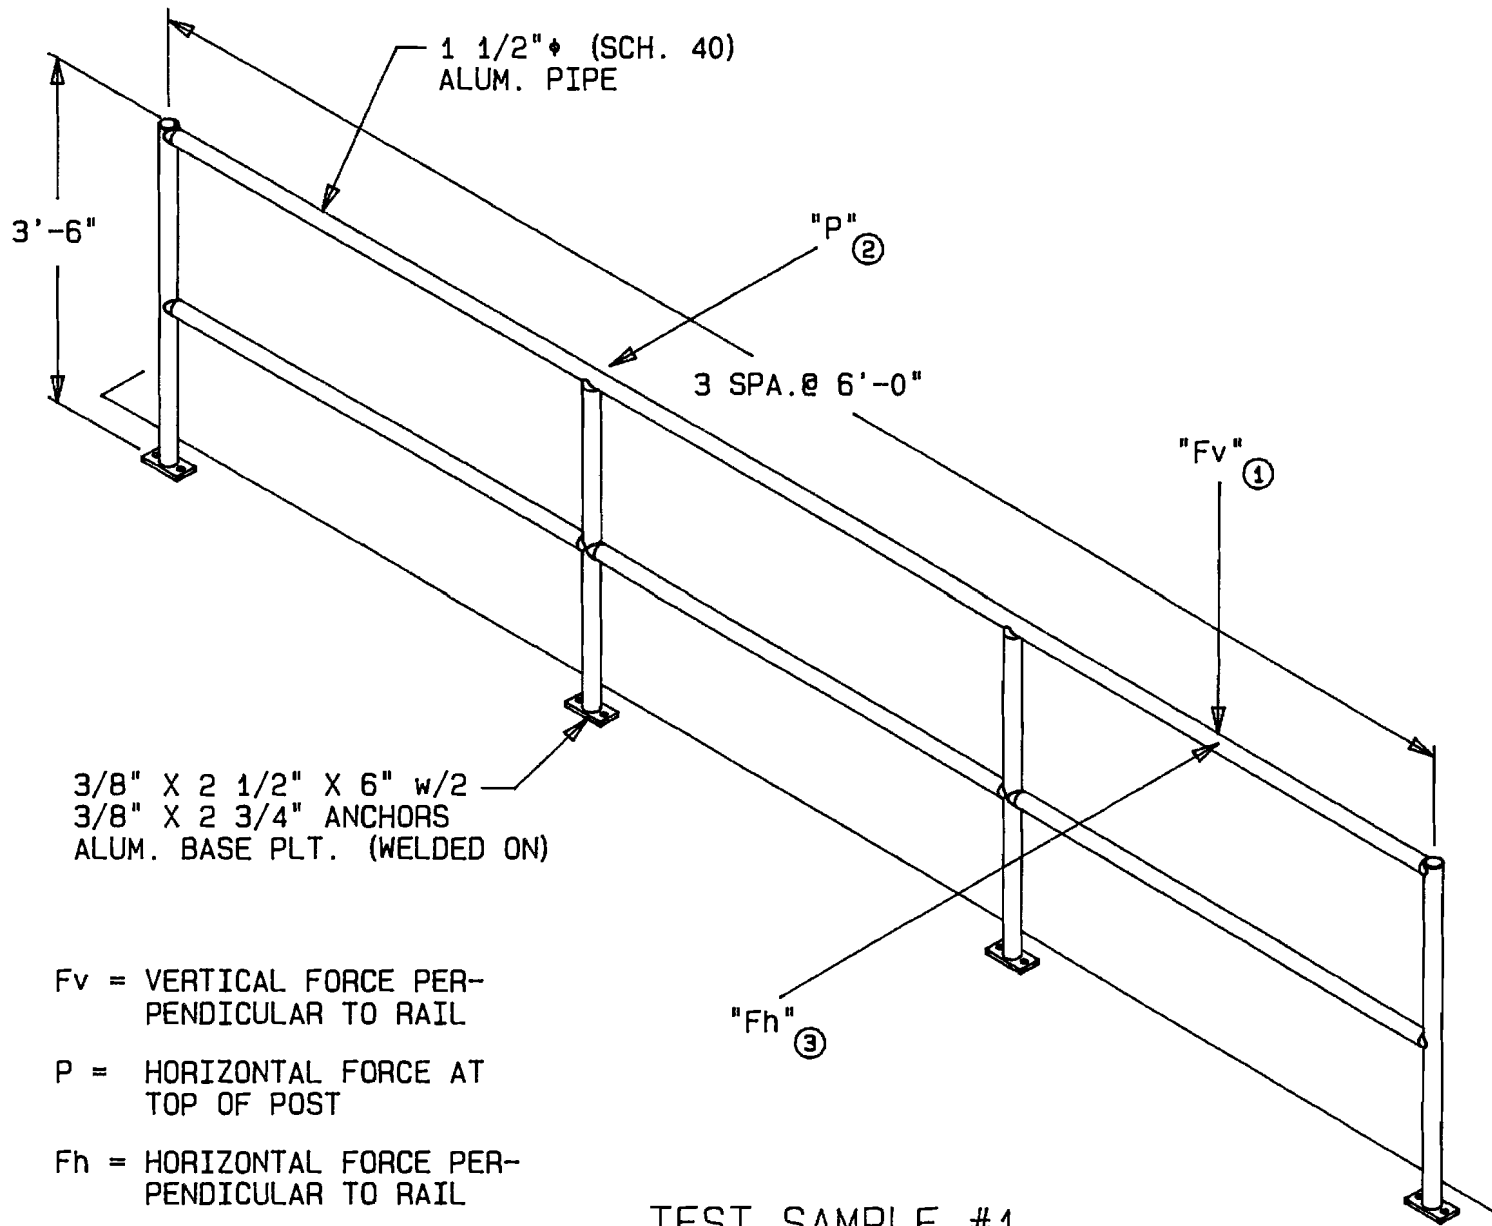



ROCKY MOUNTAIN RAILINGS

Re: Alloy Temper for Rocky Mountain Railings, Inc. Aluminum Pipe

Subject: Increased Yield Strength and Anodizing

As of 01/01/2007, Rocky Mountain Railings, Inc. has changed the use of alloy 6063-T6, 1-1/2" Sch. 40 pipe to the use of Aluminum Alloy 6105-T5, The reasons for the change is as follows:

- 1). 6105-T5 has an ultimate minimum tensile strength of 38 KSI, and 6063-T6 has 22 KSI (See Alcoa Conformance Chart) This alloy meets or exceeds OSHA and UBC loading requirements.**
- 2). Alloy 6105-T5 is also equivalent to alloy 6061-T6 in terms of tensile and yield strength. Alloy 6061-T6 is also a commonly specified alloy due to its superior strength. However the anodizing finish of 6061-T6 does not match Rocky Mountain Railings, Inc. standard clear anodize of our fittings 6105-T5 is a near perfect match in finish, Therefore a more aesthetic appearance.**

Although Rocky Mountain Railings, Inc. has endured cost impact for the use of alloy 6105-T5, We have not passed this cost to our customers. We feel that the increased strength of alloy and the appearance of the finish have helped in the submittal process and a feeling of satisfaction, knowing that we are supplying a quality product to our customer.

If you have any questions, Please call at (303)-432-0003



ALCOA

Alcoa Engineered Products

ALLOY 6005/6105

Understanding Extruded Aluminum Alloys

Among Alcoa Engineered Products' structural 6XXX series alloys, 6005 and 6105 are medium strength alloys that are very similar to alloy 6061 except they contain higher amounts of silicon. These alloys are used in designs that require moderate strength, but are generally not recommended for applications where the structure may be susceptible to impact or overloading.

When bending is required, the naturally aged -T1 temper is preferred. However, due to the excess silicon content, properties may increase more rapidly with room temperature aging than typically experienced with 6063 and 6061 alloys. In comparison to 6061, alloys 6005 and 6105 are easier to extrude and are less quench sensitive, allowing them to be used for more complex shapes. Alloys 6005 and 6105, when produced to a -T5 temper, have the same minimum tensile and yield strength as 6061-T6. In comparison to 6063, alloys 6005 and 6105 in -T5 tempers have better machinability and strength properties than 6063-T6.

Alloys 6005 and 6105 can also be welded or brazed using various commercial methods (caution: direct contact with dissimilar materials can cause galvanic corrosion). The heat from welding or brazing can reduce strength in the weld region. Consult the Material Safety Data Sheet (MSDS) for proper safety and handling precautions when using 6005 and 6105 alloys.

These alloys also offer good finishing characteristics and respond well to common anodizing methods such as clear, clear and color dye and hardcoat.

Typical applications for alloys 6005 and 6105 include:

- Automotive connector stock
- Structural members
- Hand rail tubing
- Seamless tubing
- Ladder structures

6005/6105 Temper Designations and Definitions	
Standard Tempers	Standard Temper Definitions
F	As fabricated. There is no special control over thermal conditions and there are no mechanical property limits.
T1	Cooled from an elevated temperature shaping process and naturally aged. (See Note A.)
T5	Cooled from an elevated temperature shaping process & artificially aged. (See Note A.)
Alcoa Special Tempers**	Alcoa Special Temper Definitions
(For 6005 Alloy only)	
T1S14	A maximum formability special temper for product that will be formed within 1 to 2 weeks after shipment. Samples are aged and tested in the -T5 condition to verify heat treat capability.
T5S3	An underaged temper to increase formability at a sacrifice of mechanical properties.
T5511	Same mechanical property limits as -T5. Stretched 1-3% for stress relief.

*For further details of definitions, see Aluminum Association's Aluminum Standards and Data manual and Tempers for Aluminum and Aluminum Alloy Products.
Note A: Applies to products that are not cold worked after cooling from an elevated temperature shaping process, or in which the effect of cold work in flattening or straightening may not be recognized in mechanical properties.
 **Alcoa Special Temper designations are unregistered tempers for reference only and provided for customer use to identify unique processing, material, or end use application characteristics.

Alloy 6005 Chemical Analysis		Liquidus Temperature: 1210°F		Solidus Temperature: 1125°F		Density: 0.097 lb./in. ³					
Percent Weight	Elements								Others Each	Others Total	Aluminum
	Si	Fe	Cu	Mn	Mg	Cr	Zn	Ti			
Minimum	.6	—	—	—	.40	—	—	—	—	—	Aluminum
Maximum	.9	.35	.10	.10	.6	.10	.10	.10	.05	.15	Remainder

Alloy 6105 Chemical Analysis		Liquidus Temperature: 1200°F		Solidus Temperature: 1110°F		Density: 0.097 lb./in. ³					
Percent Weight	Elements								Others Each	Others Total	Aluminum
	Si	Fe	Cu	Mn	Mg	Cr	Zn	Ti			
Minimum	.6	—	—	—	.45	—	—	—	—	—	Aluminum
Maximum	1.0	.35	.10	.15	.8	.10	.10	.10	.05	.15	Remainder

Alloy	Average Coefficient of Thermal Expansion (68° to 212°F)
	6005
6105	13.0 X 10 ⁻⁶ (inch per inch per °F)

Alloy 6005/6105 Mechanical and Physical Property Limits

Temper	Specified Section or Wall Thickness (inches) ²		Tensile Strength (ksi)				Elongation ³ Percent Min. in 2 inch or 4D ⁴	Typical Thermal Conductivity at 77°F btu-in./ft ² hr°F	Typical Electrical Conductivity ⁵ (% IACS)
			Ultimate		Yield (0.2% offset)				
	Min.	Max.	Min.	Max.	Min.	Max.			
Alloy 6005 Standard Tempers¹									
F	All		No Properties Apply					N/A	N/A
T1	—	.500	25.0	—	15.0	—	16	1250	47
T5	—	.124	38.0	—	35.0	—	8	1310	49
T5	.125	—	38.0	—	35.0	—	10	1310	49
Alloy 6105 Standard Tempers¹									
F	All		No Properties Apply					N/A	46
T1	—	.500	25.0	—	15.0	—	16	1220	—
T5	—	.500	38.0	—	35.0	—	8	1340	50
Alloy 6005 Special Tempers²									
T1S14 ⁶	—	.124	38.0	—	35.0	—	8	1250	47
T1S14 ⁶	.125	—	38.0	—	35.0	—	10	1250	47
T5S3	All		35.0	—	30.0	—	8	N/A	N/A
T5511 ⁷	—	.124	38.0	—	35.0	—	8	1310	49
T5511 ⁷	.125	—	38.0	—	35.0	—	10	1310	49

① The mechanical property limits for standard tempers are listed in the Property Limits section of the Aluminum Association's *Aluminum Standards and Data* manual and *Tempers for Aluminum and Aluminum Alloy Products*. ② The thickness of the cross section from which the tension test specimen is taken determines the applicable mechanical properties. ③ For materials of such dimensions that a standard test specimen cannot be taken, or for shapes thinner than .062", the test for elongation is not required. ④ D=Specimen diameter. ⑤ Minimum, unless stated as typical. ⑥ These properties apply to the material after proper artificial aging. No properties apply to shipped product. ⑦ For stress-relieved tempers, the characteristics and properties other than those specified may differ somewhat from the corresponding characteristics and properties of material in the basic temper.

*Alcoa Special Temper designations are unregistered tempers for reference only and provided for customer use to identify unique processing, material, or end use application characteristics.

Comparative Characteristics of Related Alloys/Tempers¹

Alloy	Temper	Formability				Machinability				General Corrosion Resistance				Weldability (Arc with Inert Gas)				Brazability				Anodizing Response			Typical Conductivity (%IACS)			
		D	C	B	A	D	C	B	A	D	C	B	A	D	C	B	A	D	C	B	A	D	C	B	A			
6005	-T1																											
	-T5, T511																											
6105	-T1																											
	-T5																											
6061	-T4																											
	-T6																											
6063	-T4																											
	-T6																											
6262	-T6																											

① Rating: A=Excellent B=Good C=Fair D=Poor For further details of explanation of ratings for, see Aluminum Association's *Aluminum Standards and Data* manual.

Alcoa Distribution and Industrial Products

53 Pottsville Street
 Cressona, PA 17929
 Phone: 800-233-3165
 FAX: 800-252-4646

eral information

general information | wrought products

VARIOUS TEMPERATURES
Table 3 (continued)

TYPICAL TENSILE PROPERTIES AT VARIOUS TEMPERATURES
Table 3 (continued)

Elongation in 2 in., percent	Alloy and Temper	Temp., °F	Tensile Strength, ksi		Elongation in 2 in., percent
			Ultimate	Yield [ⓐ]	
46	5456-O	-320	62	26	32
35		-112	46	23	25
32		-18	45	23	22
30		75	45	23	20
36		212	42	22	31
50		300	31	20	30
60		400	22	17	60
80		500	17	11	80
110		600	11	7.5	110
130		700	6	4.2	130
46	6053-T6, -T651	75	37	32	13
35		212	32	28	13
32		300	23	24	13
30		400	13	12	25
36		500	3.5	4	70
50		600	2	2.7	80
60		700	2.9	2	90
46	6061-T6, -T651	-320	60	47	22
35		-112	49	42	18
32		-18	47	41	17
30		75	45	40	17
36		212	42	38	18
50		300	34	31	20
60		400	19	15	28
80		500	7.5	5	60
110		600	4.6	2.7	85
130		700	3	1.8	95
39	6063-T1	-320	34	16	44
30		-112	26	15	36
27		-18	24	14	34
25		75	22	13	33
31		212	22	14	18
50		300	21	15	20
60		400	9	6.5	40
80		500	4.5	3.5	75
110		600	3.2	2.5	80
130		700	2.3	2	105
36	6063-T5	-320	37	24	28
21		-112	29	22	24
18		-18	28	22	23
18		75	27	21	22
18		212	24	20	18
32		300	20	18	20
45		400	9	6.5	40
80		500	4.5	3.5	75
110		600	3.2	2.5	80
130		700	2.3	2	105

31,000 YIELD
x .66 = 20,340 DS


Alloy and Temper	Temp., °F	Tensile Strength, ksi		Elongation in 2 in., percent	Alloy and Temper	Temp., °F	Tensile Strength, ksi		Elongation in 2 in., percent
		Ultimate	Yield [ⓐ]				Ultimate	Yield [ⓐ]	
6063-T6	-320	47	36	24	7075-T6, -T651	-320	102	92	9
	-112	38	33	20		-112	90	79	11
	-18	36	32	18		-18	86	75	11
	75	35	31	18		75	83	73	11
	212	31	28	15		212	70	65	14
	300	21	20	20		300	31	27	30
	400	9	6.5	40		400	16	13	55
	500	4.5	3.5	75		500	11	9	65
	600	3.3	2.5	80		600	8	6.5	70
	700	2.3	2	105		700	6	4.6	70
6151-T6	-320	57	50	20	7075-T73, -T7351	-320	92	72	14
	-112	50	46	17		-112	79	67	14
	-18	49	45	17		-18	76	65	13
	75	48	43	17		75	73	63	13
	212	43	40	17		212	63	58	15
	300	28	27	20		300	31	27	30
	400	14	12	30		400	16	13	55
	500	6.5	5	50		500	11	9	65
	600	5	3.9	43		600	8	6.5	70
	700	4	3.2	35		700	6	4.6	70
G262-T651	-320	60	47	22	7079-T6, -T651	-320	92	80	12
	-112	49	42	18		-112	82	70	14
	-18	47	41	17		-18	79	68	14
	75	45	40	17		75	78	68	14
	212	42	38	18		212	67	60	18
	300	34	31	20		300	33	28	37
	400	15	13	14		400	16	13	60
G262-T9	-320	74	67	14	500	11	8.5	100	
	-112	62	58	10	600	7.5	6	175	
	-18	60	56	10	700	5.5	4.3	175	
	75	58	53	10					
	212	53	52	10					
	300	38	37	14					
	400	15	13	34					
500	8.5	6	48						
600	4.6	2.7	85						
700	3	1.8	95						

49,000* YIELD
x .66 = 32,340 DS

ⓐ Lowest strengths during 10,000 hours of exposure at testing temperature under no load; stress applied at 5,000 psi/min to yield strength and then at strain rate of 0.03 in./in./min to failure. Under some conditions of temperature and time, the application of heat will adversely affect certain other properties of some alloys. For specific information concerning the suitability of the various alloys for use at elevated temperatures, the nearest sales office of Aluminum Company of America should be consulted.

ⓑ Offset equals 0.2 percent.
ⓐ Preferred alloy designation is 6101.

21,000* YIELD x .66 = 13,860 DS

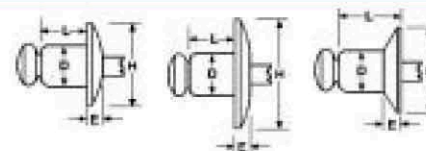

Stainless Rivet • Stainless Mandrel • IFI Grade 51

Buttonhead

AFS Part No.	D Rivet Dia. Nom. Inch (mm)	Drill No. & Hole Size (mm)	H Head Dia. Nom. Inch (mm)	E Head Height Max. Inch (mm)	L Rivet Length Max.		Grip Range		Typical Ultimate Strength (Lbs.) (newtons)	
					Inch	(mm)	Inch	(mm)	Shear	Tensile
SSB4-1S	1/8"(.125)	#30(.129-.133)	.250	.040	.212	5.4	.032-.062	0.8-1.6	520	600
SSB4-2S	3.2	3.3(3.28-3.38)	6.35	1.02	.275	7.0	.063-.125	1.7-3.2	2310	2660
SSB4-3S					.337	8.6	.126-.187	3.3-4.8		
SSB4-4S					.400	10.2	.188-.250	4.9-6.4		
SSB4-5S					.462	11.7	.251-.312	6.5-7.9		
SSB4-6S					.525	13.4	.313-.375	8.0-9.5		
SSB4-8S					.650	16.5	.376-.500	9.6-12.7		
SSB5-2S	5/32"(.156)	#20(.160-.164)	.312	.045	.300	7.6	.062-.125	1.6-3.2	785	1040
SSB5-3S	4.0	4.1(4.06-4.16)	7.92	1.14	.338	8.0	.126-.187	3.2-4.8	3490	4620
SSB5-4S					.425	10.8	.188-.250	4.9-6.4		
SSB5-6S					.550	14.0	.251-.375	6.5-9.5		
SSB5-8S					.675	17.2	.376-.500	9.6-12.7		
SSB5-10S					.800	20.3	.501-.625	12.8-15.9		
SSB6-2S	3/16"(.187)	#11(.192-.196)	.375	.066	.325	8.3	.062-.125	1.6-3.2	1150	1300
SSB6-4S	4.8	4.9(4.88-4.98)	9.53	1.40	.450	11.5	.126-.250	3.3-6.4	5110	5780
SSB6-6S					.575	14.6	.251-.375	6.5-9.5		
SSB6-8S					.700	17.8	.376-.500	9.6-12.7		
SSB6-10S					.825	21.0	.501-.625	12.8-15.9		
SSB6-12S					.950	24.2	.626-.750	16.0-19.1		
SSB6-16S					1.200	30.5	.751-1.000	19.1-25.4		
SSB8-4S	1/4"(.250)	F(.257-.261)	.500	.074	.500	12.7	.062-.250	1.6-6.4	1700	2100
SSB8-6S	6.4	6.5(6.53-6.63)	12.70	1.88	.625	15.9	.251-.375	6.5-9.5	7560	9340
SSB8-8S					.750	19.1	.376-.500	9.6-12.7		
SSB8-10S					.875	21.0	.501-.625	12.8-15.9		
SSB8-12S					1.000	25.4	.626-.750	16.0-19.1		


Large Flange

SSBL4-2S	1/8"(.125)	#30(.129-.133)	.375	.045	.275	7.0	.032-.125	0.8-3.2	520	600
SSBL4-3S	3.2	3.3(3.28-3.38)	9.53	1.14	.337	8.6	.126-.187	3.3-4.8	2310	2660
SSBL4-4S					.400	10.2	.188-.250	4.9-6.4		
SSBL6-4S	3/16"(.187)	#11(.192-.196)	.615	.082	.450	11.5	.062-.250	1.6-6.4	1150	1300
SSBL6-6S	4.8	4.9(4.88-4.98)	15.88	2.08	.575	14.6	.251-.375	6.5-9.5	5110	5780
SSBL6-8S					.700	17.8	.376-.500	9.6-12.7		
SSBL6-10S					.825	21.0	.501-.625	12.8-15.9		
SSBL6-12S					.950	24.2	.626-.750	16.0-19.1		

120° Countersunk

SSC4-2S	1/8"(.125)	#30(.129-.133)	.220	.045	.275	7.0	.063-.125	1.7-3.2	520	600
SSC4-3S	3.2	3.3(3.28-3.38)	5.59	1.14	.337	8.6	.126-.187	3.3-4.8	2310	2660
SSC4-4S					.400	10.2	.188-.250	4.9-6.4		
SSC4-5S					.462	11.7	.251-.312	6.5-7.9		
SSC6-4S	3/16"(.187)	#11(.192-.196)	.350	.050	.407	10.3	.126-.250	3.3-6.4	1150	1300
	4.8	4.9(4.88-4.98)	8.89	1.27					5110	5780

Meet our stainless lineup

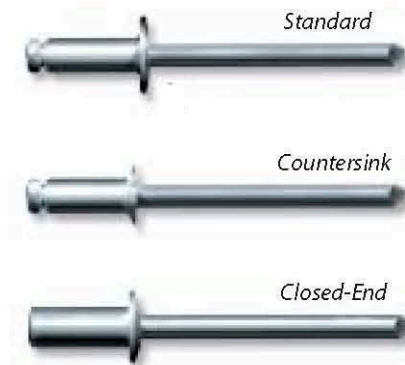

H.B. Tnemecol

APPLICATION

COVERAGE RATES

	Dry Mils (Microns)	Wet Mils (Microns)	Sq Ft/Gal (m ² /Gal)
Suggested	10.0 (255)	15.5 (395)	103 (9.5)
Minimum	8.0 (205)	12.5 (320)	128 (11.9)
Maximum	12.0 (305)	19.0 (480)	86 (7.9)

Allow for overspray and surface irregularities. Film thickness is rounded to the nearest 0.5 mil or 5 microns. Application of coating below minimum or above maximum recommended dry film thicknesses may adversely affect coating performance.

MIXING Stir thoroughly, making sure no pigment remains on the bottom of the can.

THINNING Use No. 2 Thinner. For air or airless spray, brush or roller, thin up to 5% or ¼ pint (190 mL) per gallon if necessary. Drum heaters or inline heaters may be necessary to maintain application viscosity during cool weather.

SURFACE TEMPERATURE Minimum 40°F (4°C) Maximum 135°F (57°C)
The surface should be dry and at least 5°F (3°C) above the dew point.

APPLICATION EQUIPMENT

Air Spray

Gun	Fluid Tip	Air Cap	Air Hose ID	Mat'l Hose ID	Atomizing Pressure	Pot Pressure
DeVilbiss MBC or JGA	E	704	3/8" or 1/2" (9.5 or 12.7 mm)	1/2" or 3/4" (12.7 or 19 mm)	50 psi (3.4 bar)	20 psi (1.4 bar)

Low temperatures or longer hoses require higher pot pressure.

Airless Spray

Tip Orifice	Atomizing Pressure	Mat'l Hose ID	Manifold Filter
0.017"-0.031" (430-785 microns)	2400-3000 psi (165-207 bar)	3/8" or 1/2" (9.5 or 12.7 mm)	60 mesh (250 microns)

Use appropriate tip/atomizing pressure for equipment, applicator technique and weather conditions.

Roller: Use high quality synthetic nap covers. Short nap for smooth surfaces. Long nap for rough surfaces. **Note:** Two or more coats may be required to obtain recommended film thicknesses.

Brush: Use high quality nylon or synthetic bristle brushes. **Note:** Two or more coats may be required to obtain recommended film thicknesses.

CLEANUP Flush and clean all equipment immediately after use with the recommended thinner or xylol.

WARRANTY & LIMITATION OF SELLER'S LIABILITY: Tnemec Company, Inc. warrants only that its coatings represented herein meet the formulation standards of Tnemec Company, Inc. THE WARRANTY DESCRIBED IN THE ABOVE PARAGRAPH SHALL BE IN LIEU OF ANY OTHER WARRANTY, EXPRESSED OR IMPLIED, INCLUDING BUT NOT LIMITED TO, ANY IMPLIED WARRANTY OF MERCHANTABILITY OR FITNESS FOR A PARTICULAR PURPOSE. THERE ARE NO WARRANTIES THAT EXTEND BEYOND THE DESCRIPTION ON THE FACE HEREOF. The buyer's sole and exclusive remedy against Tnemec Company, Inc. shall be for replacement of the product in the event a defective condition of the product should be found to exist and the exclusive remedy shall not have failed its essential purpose as long as Tnemec is willing to provide comparable replacement product to the buyer. NO OTHER REMEDY (INCLUDING, BUT NOT LIMITED TO, INCIDENTAL OR CONSEQUENTIAL DAMAGES FOR LOST PROFITS, LOST SALES, INJURY TO PERSON OR PROPERTY, ENVIRONMENTAL INJURIES OR ANY OTHER INCIDENTAL OR CONSEQUENTIAL LOSS) SHALL BE AVAILABLE TO THE BUYER. Technical and application information herein is provided for the purpose of establishing a general profile of the coating and proper coating application procedures. Test performance results were obtained in a controlled environment and Tnemec Company makes no claim that these tests or any other tests, accurately represent all environments. As application, environmental and design factors can vary significantly, due care should be exercised in the selection and use of the coating. FOR INDUSTRIAL USE ONLY.

DATA SHEET

TUTTLE ALUMINUM
120 SHADLOWLAWN DRIVE

FISHERS IN 46038

COAL TAR CTG. H.B. TNEMEC

FOR COATINGS, RESINS, AND RELATED MATERIALS
 (APPROVED BY THE U.S. DEPARTMENT OF LABOR AS
 'ESSENTIALLY SIMILAR' TO FORM OSHA-20)
 (MEETS REQUIREMENTS OF CFR 29 PART 1910.1200,
 OSHA'S HAZARD COMMUNICATION STANDARD)

NPCA 1-84

 SECTION 1 - MANUFACTURER AND PRODUCT INFORMATION

CHEMICAL PRODUCT IDENTIFICATION:

PRODUCT ID : F046-0465 5G
 PRODUCT CLASS : COAL TAR
 TRADE NAME : COAL TAR CTG. H.B. TNEMEC
 FORMULA VERSION NUMBER : 5
 MSDS PREPARATION DATE : 01/18/2001

MANUFACTURER IDENTIFICATION:

NAME : TNEMEC COMPANY, INC.
 ADDRESS : 123 WEST 23RD AVENUE
 NORTH KANSAS CITY, MO. 64116-3064
 TELEPHONE : 816-474-3400
 EMERGENCY TELEPHONE : 816-474-1425

 SECTION 2 - HAZARDOUS INGREDIENTS

1 MAGNESIUM SILICATE

CAS# 14807-96-6
 TALC (NO ASBESTOS FIBERS/RESPIRABLE DUST)
 PCT BY WT: 11-20
 EXPOSURE LIMIT:
 ACGIG TVL/TWA: 0002.00 MG/M3
 OSHA PEL/TWA: 0002.00 MG/M3

2

CAS# 7727-43-7
 BARIUM SULFATE (TOTAL DUST)
 PCT BY WT: 21-30
 EXPOSURE LIMIT:
 ACGIG TVL/TWA: 0010.00 MG/M3
 OSHA PEL/TWA: 0010.00 MG/M3

3

CAS# 65996-93-2
 REFINED COAL TAR PITCH (CONTAINS PPAH'S)
 PCT BY WT: 34.4860
 EXPOSURE LIMIT:
 ACGIG TVL/TWA: 0000.20 MG/M3
 OSHA PEL/TWA: 0000.20 MG/M3

4 METHYLBENZENE

CAS# 108-88-3
 TOLUENE
 PCT BY WT: 5.6690 VAPOR PRESSURE: 22.000 MMHG @ 68F
 EXPOSURE LIMIT:
 ACGIG TVL/TWA: 0050.00 PPM
 OSHA PEL/TWA: 0100.00 PPM
 OSHA STEL: 0150.00 PPM

5

CAS# 100-41-4
 ETHYL BENZENE
 PCT BY WT: 2.6770 VAPOR PRESSURE: 6.000 MMHG @ 68F
 EXPOSURE LIMIT:
 ACGIG TVL/TWA: 0100.00 PPM
 ACGIH TLV/STEL: 0125.00 PPM
 OSHA PEL/TWA: 0100.00 PPM
 OSHA STEL: 0125.00 PPM

6 XYLENE

CAS# 1330-20-7
 DIMETHYLBENZENE
 PCT BY WT: 11.0730 VAPOR PRESSURE: 5.100 MMHG @ 68F
 EXPOSURE LIMIT:
 ACGIG TVL/TWA: 0100.00 PPM
 ACGIH TLV/STEL: 0150.00 PPM
 OSHA PEL/TWA: 0100.00 PPM
 OSHA STEL: 0150.00 PPM

 This product contains one or more reported carcinogens or suspected
 carcinogens which are noted NTP, IARC, or OSHA-Z in the other limits

TNEMEC COMPANY, INC.
MATERIAL SAFETY DATA SHEET

F046-0465 5G

COAL TAR CTG. H.B. TNEMEC

SECTION 4 - FIRST AID MEASURES

EYE CONTACT:

Flush immediately with large amounts of clean water under low pressure for at least 15 minutes. Consult a physician.

SKIN CONTACT:

Wash affected area with soap and water. Remove contaminated clothing. Dispose of or launder accordingly. Consult a physician if skin irritation persists.

INHALATION:

Remove affected individual to fresh air. Treat symptomatically. If breathing is difficult, administer oxygen. If breathing has stopped give artificial respiration. Consult a physician.

INGESTION:

Drink 1 or 2 glasses of water to dilute. Do not induce vomiting. Consult a physician or poison control center IMMEDIATELY. Treat symptomatically.

NOTE TO PHYSICIAN:

SECTION 5 - FIRE AND EXPLOSION HAZARD DATA

FIRE AND EXPLOSIVE PROPERTIES OF THE CHEMICAL:

Flammability Classification	:	:	:	:	:	:	:	:	:
Flashpoint	:	:	:	:	:	:	:	:	80.0
Explosion Level	:	:	:	:	:	:	:	:	Low - 1.0
									High - -N/A
Flammability Limits	:	:	:	:	:	:	:	:	Lower - -N/A
									Higher - -N/A

EXTINGUISHING MEDIA:

Foam, carbon dioxide, and dry chemical.

FIRE-FIGHTING PROCEDURES AND EQUIPMENTS:

Keep away from heat, open flames, sparks, and areas where static charge may be generated. Do not apply to hot surfaces due to possible fire and explosion risk. For closed containers, pressure build-up and possible explosion might occur due to extreme heat exposure. Solvent vapors are heavier than air and may travel considerable distance to a source of ignition and flash back. Water may be used to cool unruptured containers. Wear self-contained breathing apparatus with a full facepiece operated in pressure-demand or other positive pressure mode to prevent inhalation of hazardous decomposition products. Use appropriate extinguishing media to control fire. Water may cause violent frothing if sprayed directly into containers of burning liquid.

SECTION 6 - SPILL OR LEAK PROCEDURES

CLEAN-UP:

Remove all sources of ignition. Spills may be collected with inert, absorbent material for proper disposal. Use non-sparking tools, protective gloves, goggles and clothing, adequate ventilation, avoid the breathing of vapors and use respiratory protective devices. Transfer absorbent material to suitable containers for proper disposal.

SECTION 7 - SPECIAL PRECAUTIONS

HANDLING AND STORAGE:

Store in dry area. Keep closures tight and upright to prevent leakage. Do not store in high temperature areas or near fire or open flame. Refer to product data sheet for recommended storage temperatures.

SPECIAL COMMENTS:

Prevent prolonged breathing of airborne contaminants such as vapor, spray mists, or dusts. Prevent contact with skin and eyes. Do not take internally. Keep out of reach of children. Do not reuse or alter containers without proper industrial cleaning. Do not weld or flame cut empty, uncleaned containers due to potential fire and explosion hazard. Consult product data sheet for proper application instructions.

TNEMEC COMPANY, INC.
MATERIAL SAFETY DATA SHEET

F046-0465 5G

COAL TAR CTG. H.B. TNEMEC

SECTION 12 - ECOLOGICAL INFORMATION

ECOTOXICOLOGICAL INFORMATION:

SECTION 13 - DISPOSAL CONSIDERATIONS

WASTE DISPOSAL:

Dispose of in accordance with Federal, state, and local regulations regarding pollution.

SECTION 14 - TRANSPORT INFORMATION

DOT HAZARD CLASS :

TRANSPORTATION ASSISTANCE:

Contact Tnemec's Traffic department @ (816) 474-3400.

SECTION 15 - REGULATORY INFORMATION

FEDERAL REGULATIONS:

This product contains the following toxic chemicals subject to the reporting requirements of Section 313 of the Emergency Planning and Community Right-To-Know Act of 1986 and of 40 CFR 372:

TOLUENE
CAS# 108-88-3 PCT BY WT: 5.6690

ETHYL BENZENE
CAS# 100-41-4 PCT BY WT: 2.6770

DIMETHYLBENZENE
CAS# 1330-20-7 PCT BY WT: 11.0730

STATE REGULATIONS:

SECTION 16 - OTHER INFORMATION

Prepared by : Kevin Settles

Date of issue : 01/18/2001

Last Revision Date : 02/23/1997

MSDS Prepared for : TUTTLE ALUMINUM
120 SHADLOWLAWN DRIVE

FISHERS IN 46038

MSDS Last Prepared : 04/27/2000

HMIS Information: Health- 3* Flammability- 3
Reactivity- 1

For specific information regarding occupational safety and health standards, please refer to the Code of Federal Regulations, Title 29, Part 1910.

To the best of our knowledge, the information contained herein is accurate. However, neither the Tnemec Company or any of its subsidiaries assume any liability whatsoever for the accuracy or completeness of the information contained herein. Final determination of suitability of any material is the sole responsibility of the user. All materials may present unknown health hazards and should be used with caution. Although certain hazards are described herein, we cannot guarantee that these are the only hazards which exist.

FOR COATINGS, RESINS, AND RELATED MATERIALS
(APPROVED BY THE U.S. DEPARTMENT OF LABOR AS
'ESSENTIALLY SIMILAR' TO FORM OSHA-20)
(MEETS REQUIREMENTS OF CFR 29 PART 1910.1200,
OSHA'S HAZARD COMMUNICATION STANDARD)

NPCA 1-84

SECTION 1 - MANUFACTURER AND PRODUCT INFORMATION

CHEMICAL PRODUCT IDENTIFICATION:

PRODUCT ID : F041-0002 5G
PRODUCT CLASS : THINNER
TRADE NAME : THINNER CLEAR
FORMULA VERSION NUMBER : 2
MSDS PREPARATION DATE : 01/18/2001
MANUFACTURER IDENTIFICATION:
NAME : TNEMEC COMPANY, INC.
ADDRESS : 123 WEST 23RD AVENUE
NORTH KANSAS CITY, MO. 64116-3064
TELEPHONE : 816-474-3400
EMERGENCY TELEPHONE : 816-474-1425

SECTION 2 - HAZARDOUS INGREDIENTS

1
CAS# 100-41-4
ETHYL BENZENE
PCT BY WT: 19.9980 VAPOR PRESSURE: 6.000 MMHG @ 68F
EXPOSURE LIMIT:
ACGIG TVL/TWA: 0100.00 PPM
ACGIH TLV/STEL: 0125.00 PPM
OSHA PEL/TWA: 0100.00 PPM
OSHA STEL: 0125.00 PPM

2 XYLENE
CAS# 1330-20-7
DIMETHYLBENZENE
PCT BY WT: 80.0020 VAPOR PRESSURE: 5.100 MMHG @ 68F
EXPOSURE LIMIT:
ACGIG TVL/TWA: 0100.00 PPM
ACGIH TLV/STEL: 0150.00 PPM
OSHA PEL/TWA: 0100.00 PPM
OSHA STEL: 0150.00 PPM

This product contains one or more reported carcinogens or suspected
carcinogens which are noted NTP, IARC, or OSHA-Z in the other limits
recommended column.

This substance contains a material classified as a hazardous air
pollutant.

SECTION 3 - HEALTH HAZARD INFORMATION

EMERGENCY OVERVIEW:

POTENTIAL HEALTH EFFECTS:

EYE:

Severe irritation.
Redness, tearing, blurred vision.

SKIN:

Moderate irritation, drying of skin, defatting and possible
dermatitis.

INHALATION - OVEREXPOSURE TO SOLVENT VAPORS OR SPRAY MIST:

Nasal and respiratory irritation, anesthetic effects, dizziness,
possible unconsciousness and asphyxiation, stupor, weakness,
fatigue, nausea, and headache.

INHALATION - OVEREXPOSURE TO FREE PIGMENT DUST:

INGESTION:

Gastrointestinal irritation, nausea, vomiting, diarrhea, death,
aspiration into the lungs which can be fatal.

CHRONIC EFFECTS:

NOTICE: Reports have associated repeated and prolonged occupational
overexposure to solvents with permanent brain and nervous system
damage. Intentional misuse by deliberately concentrating and
inhaling the vapors may be harmful or fatal.
Based on an International Agency for Research on Cancer (IARC) conclusion

TNEMEC COMPANY, INC.
MATERIAL SAFETY DATA SHEET

F041-0002 5G

THINNER CLEAR

SECTION 6 - SPILL OR LEAK PROCEDURES

CLEAN-UP:

Remove all sources of ignition. Spills may be collected with inert, absorbent material for proper disposal. Use non-sparking tools, protective gloves, goggles and clothing, adequate ventilation, avoid the breathing of vapors and use respiratory protective devices. Transfer absorbent material to suitable containers for proper disposal.

SECTION 7 - SPECIAL PRECAUTIONS

HANDLING AND STORAGE:

Store in dry area. Keep closures tight and upright to prevent leakage. Do not store in high temperature areas or near fire or open flame. Refer to product data sheet for recommended storage temperatures.

SPECIAL COMMENTS:

Prevent prolonged breathing of airborne contaminants such as vapor, spray mists, or dusts. Prevent contact with skin and eyes. Do not take internally. Keep out of reach of children. Do not reuse or alter containers without proper industrial cleaning. Do not weld or flame cut empty, uncleaned containers due to potential fire and explosion hazard. Consult product data sheet for proper application instructions.

SECTION 8 - SAFE HANDLING AND USE INFORMATION

HYGIENIC PRACTICES:

Wash hands and other contaminated skin areas with warm soap and water before eating.

EYE PROTECTION:

Use chemical resistant splash type goggles.

RESPIRATORY PROTECTION:

Respiratory protective devices must be used when engineering and administration controls are not adequate to maintain Threshold Limit Values (TLV) and Permissible Exposure Limits (PEL) of airborne contaminants below the listed values for those hazardous ingredients identified in Section II of this MSDS. Observe OSHA regulations for respirator use (CFR 29, 1910.134) whenever a respirator is used. Particulate, chemical cartridge, air purifying half-mask respirators can be used within certain limitations; consult the respirator manufacturer for specific uses and limitations. Where airborne contaminant concentrations are unknown, the use of a NIOSH/MSHA approved fresh-air supplied respirator is mandatory.

OTHER PROTECTION:

Use chemical resistant gloves.

Use chemical resistant coveralls or apron to protect against skin and clothing contamination.

Use protective cream where skin contact is likely.

VENTILATION:

Sufficient ventilation, in volume and pattern, should be provided through both local and general exhaust to keep the air contaminant concentration below current applicable OSHA Permissible Exposure Limits (PEL) and ACGIH's Threshold Limit Values (TLV). Appropriate ventilation should be employed to remove hazardous decomposition products formed during welding or flame cutting operations of surfaces coated with this product. Heavier than air solvent vapors should be removed from lower levels of work area due to potential explosion hazard and all ignition sources (non-explosion proof equipment) should be eliminated if flammable mixtures will be encountered.

SECTION 9 - PHYSICAL AND CHEMICAL PROPERTIES

Vapor Pressure	:	6.00	
Vapor Density	:	-N/A	
Boiling Range	:	Lower - 275.0	°F
	:	Higher - 288.0	°F
Formula Weight per Volume	:	7.2000	LB/GL
VOC IN LBS PER GALLON	:	7.200	
Evaporation Rate	:	9.400	(Ether = 1)

TNE MEC COMPANY, INC.
MATERIAL SAFETY DATA SHEET

F041-0002 5G

THINNER CLEAR

MSDS Last Prepared : 04/27/2000

HMIS Information: Health- 2 Flammability- 3
Reactivity- 1

For specific information regarding occupational safety and health standards, please refer to the Code of Federal Regulations, Title 29, Part 1910.

To the best of our knowledge, the information contained herein is accurate. However, neither the Tnemec Company or any of its subsidiaries assume any liability whatsoever for the accuracy of completeness of the information contained herein. Final determination of suitability of any material is the sole responsibility of the user. All materials may present unknown health hazards and should be used with caution. Although certain hazards are described herein, we cannot guarantee that these are the only hazards which exist.



ROCKY MOUNTAIN RAILINGS

Basic Cleaning Procedures for Anodic Finishes

Cleaning of light surface soil may be accomplished using the following methods:

- Flush surface with water using moderate pressure to remove soil. If soil is still adhering after drying, a mild detergent may be necessary.
- When mild detergent or soap is necessary, it should be used with brushing (non-metal) or sponging. The surface must be thoroughly rinsed with clean water after the use of any cleaning agent. It may be necessary to sponge the surface while rinsing, particularly if the cleaner is permitted to dry on the surface. Mild detergents ruled safe for bare hands should be safe for coated aluminum. Stronger detergents should be carefully spot tested and may necessitate the use of rubber gloves, long handled brushes, etc.
- If surface soil still adheres after following the procedures above, cleaning using a palm-sized nylon pad can be employed. Thoroughly wet pad with clean water or a mild detergent. Rub the metal surface in the direction of the metal grain with uniform pressure. After scrubbing, the metal surface should be rinsed thoroughly using clean water to remove all residues. Solvents may be used to remove non-water soluble deposits. Extreme care must be exercised when solvents are used since they may damage organic sealants, gaskets and painted finishes. If solvents are used, rinse the surface completely with clean water.

Cleaning Precautions

- Never use aggressive alkaline or acid cleaners on aluminum finishes. Do not use cleaners containing trisodium phosphate, phosphoric acid, hydrochloric acid, hydrofluoric acid, fluorides, or similar compounds on anodized aluminum surfaces. Always follow the cleaner manufacturer's recommendations as to the proper cleaner and concentration. Test-clean a small area first. Different cleaners should not be mixed.
- It is preferable to clean the metal when shaded. Do not attempt to clean hot, sun-heated surfaces since possible chemical reactions on hot metal surfaces will be highly accelerated and non-uniform. Also, avoid cleaning in freezing temperatures or when metal temperatures are sufficiently cold to cause condensation. Surfaces cleaned under these adverse conditions can become streaked or tainted that they cannot be restored to their original appearance.

References

VOLUNTARY GUIDE SPECIFICATION FOR CLEANING AND MAINTENANCE
OF ARCHITECTURAL ANODIZED ALUMINUM, AAMA 609.1
American Architectural Manufacturers Association

RMR 80KD System Calculations

Aluminum Railing Design Calculations – R11-10-240

Colorado

Prepared for
Rocky Mountain Railings
Denver, CO

Design Criteria:

Date: 11/21/11

1. Railing live loads per **International Building Code 2009:**

Guardrails

- 50 plf uniform load in any direction on top rail
- 200 pound concentrated load in any direction on top rail
- 50 pound concentrated load over 1 ft² of infill area
- Concentrated load and uniform loads need not be assumed to act concurrently

Railing deflections per ASTM E985

Members designed per Aluminum Association Inc, "Aluminum Design Manual"


2. Aluminum member sizes shall be as recommended in the calculation booklet
3. Aluminum alloys shall be as recommended in the calculation booklet
4. Stainless steel fasteners to be minimum **Condition "CW"**, **F_y = 65 ksi**
5. Aluminum welds to be **filler alloy 5356**, unless noted otherwise
6. Concrete strength is assumed to be **F'_c = 4,000 psi**, normal weight
7. Separate dissimilar metals.
8. Additional RISA Finite Element Analysis model data available upon request.

RICE ENGINEERING

This Certification is limited to the structural design of structural components of this handrail or divider system. It does NOT include responsibility for:


- Structural design of misc. hardware (latches, hinges, etc.).
- Structural design of concrete slabs and other masonry units
- Structural design of wood blocking or wood framing
- Structural design of all other anchorage substrates
- The manufacture, assembly, or installation of the system.
- Quantities of materials or dimensional accuracy of drawings

Engineers Design Approval Stamp:

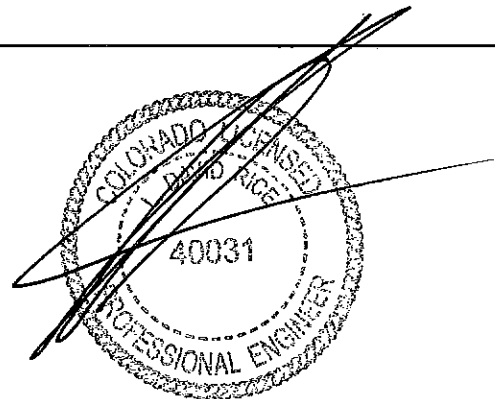

NOV 21 2011

Project Location & Specifications	SHT PL
-----------------------------------	-----------

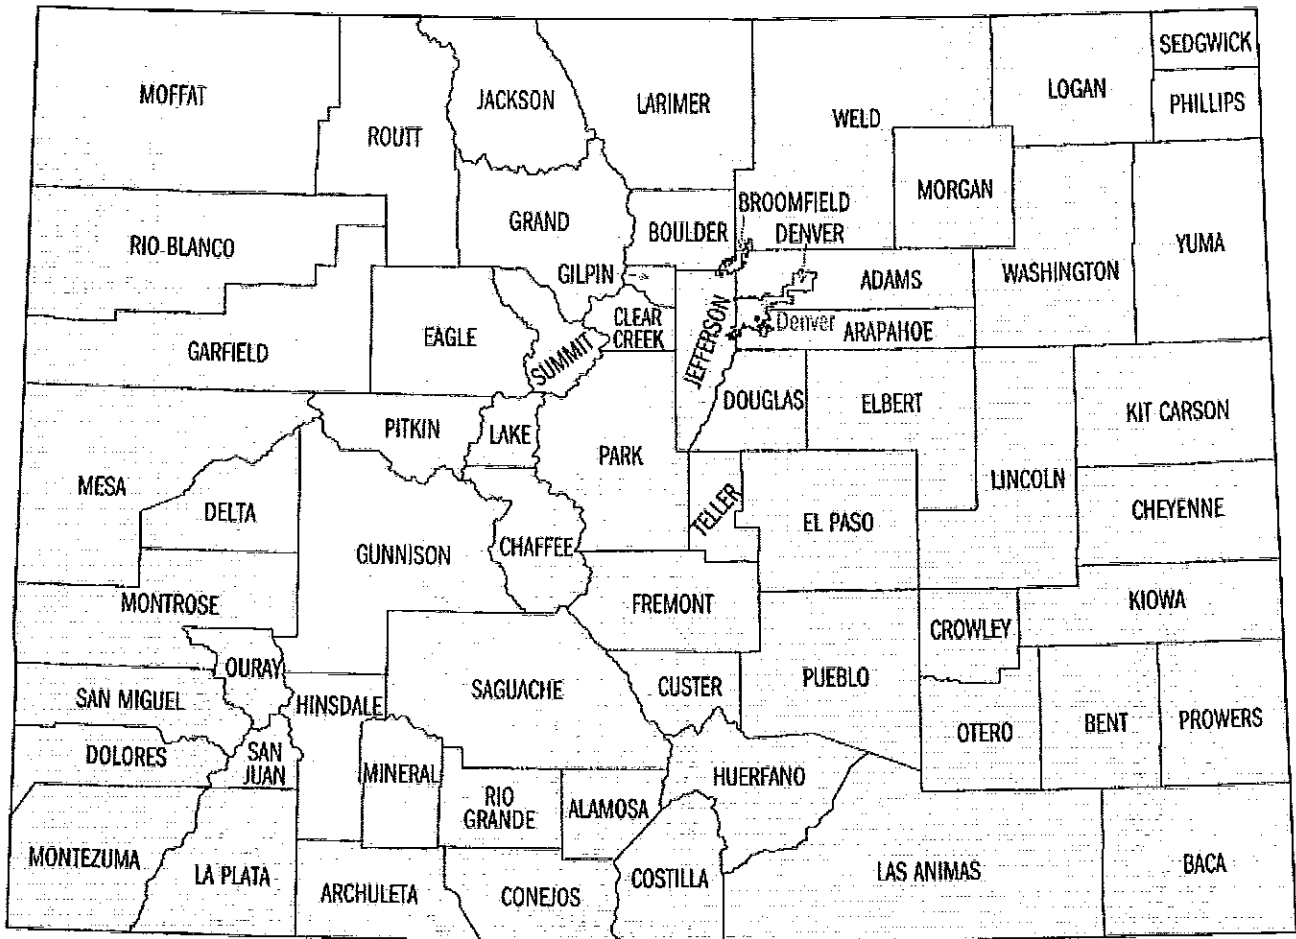

Project Location: Colorado


- Design Loads per IBC 2009

50 plf uniform load in any direction on top rail

200# concentrated load in any direction on top rail

50# concentrated load applied to 1 square foot of infill

RICE ENGINEERING Template: REL-MC-2002	105 School Creek Trail Luxemburg, WI 54217 Phone: (920)845-1042 Fax: (920)845-1048 www.rice-inc.com	Project Description:		Job No:	R11-10-240		
		RMR 80KD System		Engineer:	JDB	Sheet No:	PL
				Date:	10/24/11	Rev:	
				Chk By:		Date:	

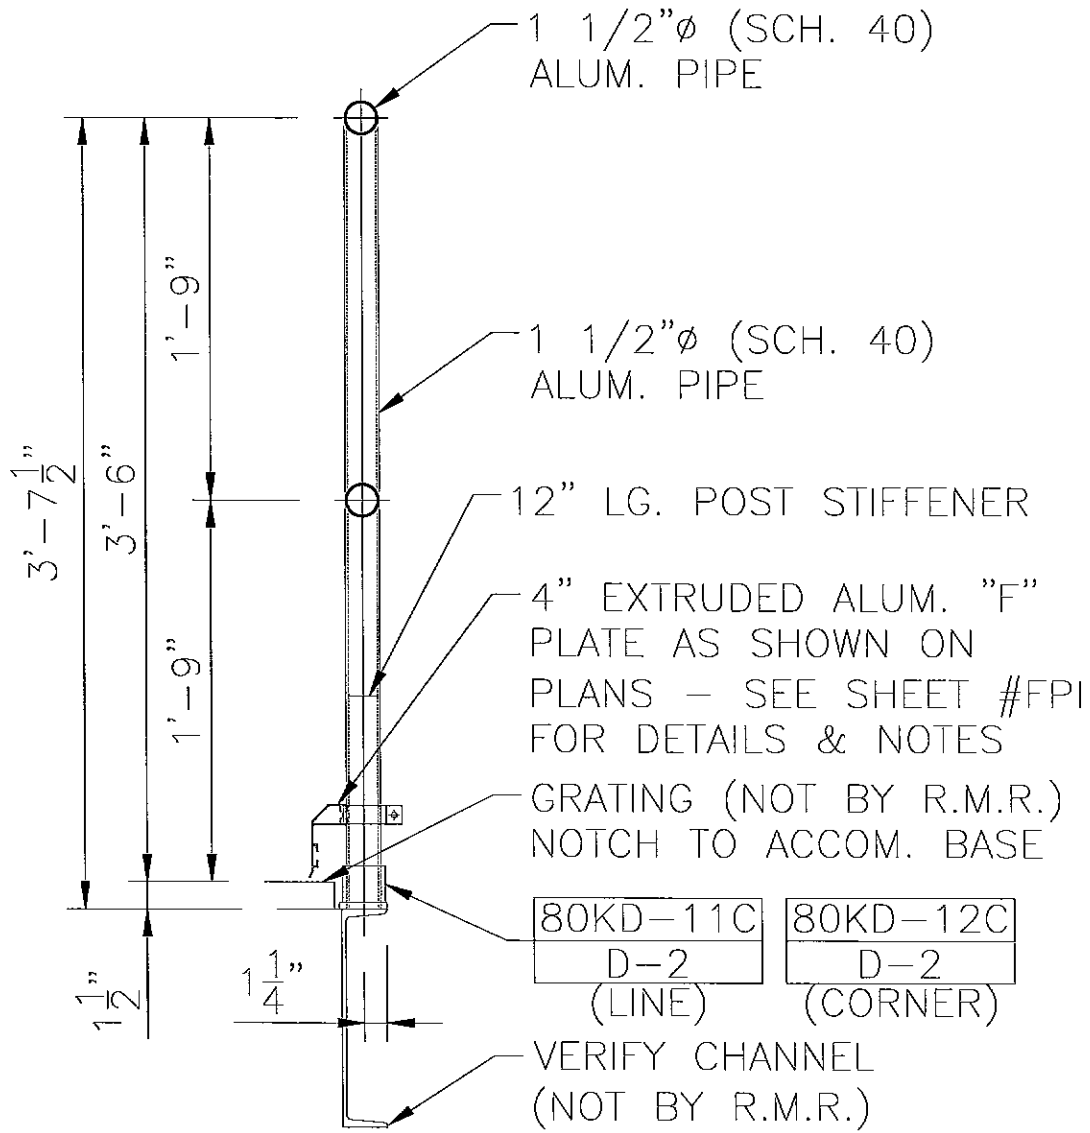

SECTION A
D-1

Note: Structural steel, Concrete, CMU and all other anchorage substrates designed by others



ROCKY MOUNTAIN RAILINGS

RICE ENGINEERING Template: REI-MC-5707	105 School Creek Trail Luxemburg, WI 54217 Phone: (920)845-1042 Fax: (920)845-1048 www.rice-inc.com	Project Description: RMR 80KD System	Job No: R11-10-240
			Engineer: JDB Sheet No: A
			Date: 10/24/11 Rev:
			Chk By: Date:

Pipe Railing & Post

These calculations are based on empirical test data performed by Julius Blum & Co., Inc.

Guardrail "A" Analysis	SHT A1
------------------------	-----------

Input Variables:

- $F_H := 50$ plf Load Case 1 (Uniform Load)
- $F_v := 0$ plf Simultaneous Vertical Uniform Load
- $P := 200$ lb Load Case 2 (Point Load)
- $L_{bp} := 21$ in Unbraced Length of Post
- $h := 41$ in Railing Height Above Base Flange
- $L := 60$ in **5'-0" MAX POST SPACING**

Number of Railing Spans:

- 1 span
- 2 span
- 3 or more spans

Note:
Limited to 5'0"

Railing Section:

- 1 1/4" Schd. 40
- 1 1/4" Schd. 80
- 1 1/2" Schd. 40
- 1 1/2" Schd. 80
- 1 1/2" tube
- 2" Schd. 40
- 2" Schd. 80

Post Section:


- 1 1/4" Schd. 40
- 1 1/4" Schd. 80
- 1 1/2" Schd. 40
- 1 1/2" Schd. 80
- 1 1/2" tube
- 2" Schd. 40
- 2" Schd. 80

Railing Temper:

- 6063-T5
- 6063-T6
- 6061-T6 or 6105-T5
- 4/3 increase allowed

Post Temper:

- 6063-T6
- 6005-T5
- 6061-T6 or 6105-T5
- Post Welded to Base Plate

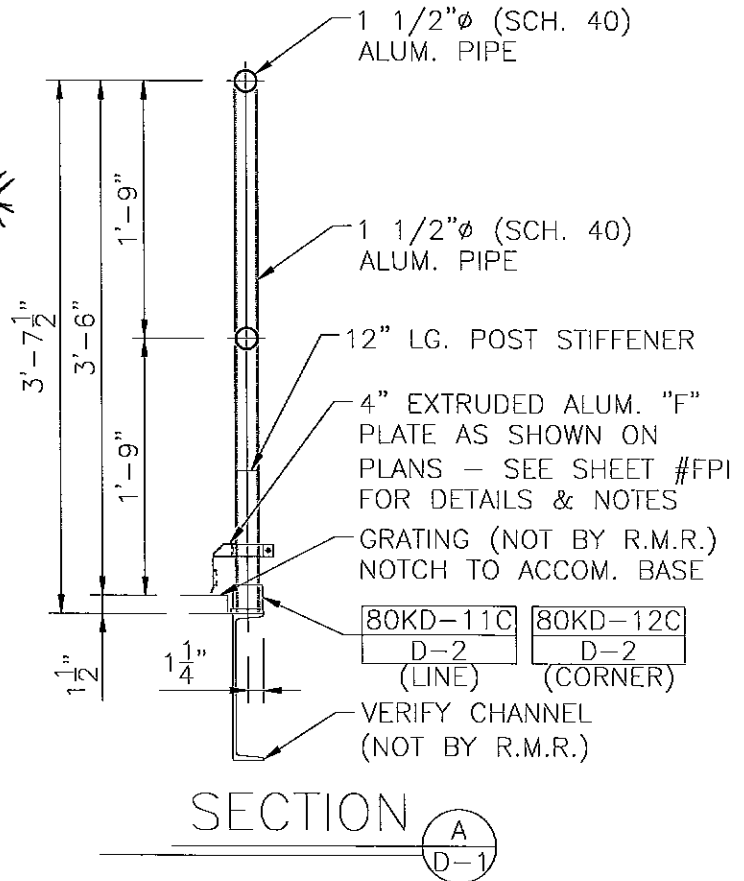

All calculations below this line are automatic

Railing Properties

$I_{xr} =$	0.31
$I_{yr} =$	0.31
$S_{xr} =$	0.326
$S_{yr} =$	0.326
$R =$	0.95
$t =$	0.145

Post Properties

$I_{xp} =$	0.31
$I_{yp} =$	0.31
$S_{xp} =$	0.326
$S_{yp} =$	0.326
$R =$	0.95
$t =$	0.145

Computational Factors

$$S_{R1} = \frac{R_r}{t_r} \quad S_{R1} = 6.55 \quad K_1 := (8 \cdot q_1) + (8 \cdot q_2) + (9.5 \cdot q_3) \quad K_1 = 8$$

$$S_{R3} = \frac{R_p}{t_p} \quad S_{R3} = 6.55 \quad K_2 := (4 \cdot q_1) + (5 \cdot q_2) + (5 \cdot q_3) \quad K_2 = 5$$

$$K_3 := (48 \cdot q_1) + (66 \cdot q_2) + (87 \cdot q_3) \quad K_3 = 66$$

$E_r := 10100000$ psi

$I_{xtotr} := I_{xr} \quad I_{xtotr} = 0.31 \text{ in}^4 \quad I_{xtotp} := I_{xp} \quad I_{xtotp} = 0.31 \text{ in}^4$
 $I_{ytotr} := I_{yr} \quad I_{ytotr} = 0.31 \text{ in}^4 \quad I_{ytop} := I_{yp} \quad I_{ytop} = 0.31 \text{ in}^4$

12" Min. Length AL. Ribbed Tube Stub

$I_{st} := 0.174 \text{ in}^4 \quad L_{st} := 9.5 \text{ in}$
 $S_{st} := 0.224 \text{ in}^3 \quad F_{bst} := 25000 \text{ psi}$

RICE ENGINEERING Template: REI-MC-5707	105 School Creek Trail Luxemburg, WI 54217 Phone: (920)845-1042 Fax: (920)845-1048 www.rice-inc.com	Project Description: RMR 80KD System	Job No: R11-10-240
			Engineer: JDB Sheet No: A1
			Date: 10/24/11 Rev:
			Chk By: Date:

Railing Analysis:

$$W_h := \frac{F_H}{12}$$

$$W_v := \frac{F_V}{12}$$

Guardrail "A" Analysis	SHT A1 A
------------------------	-------------

Case 1 Uniform Load:

$$\Delta_{yr1} := \frac{5 \cdot W_h \cdot L^4}{384 \cdot E_r \cdot I_{ytotr}}$$

$$\Delta_{yr1} = 0.225 \quad \text{in} \quad \text{Modeled as a simple span}$$

$$\Delta_{xr1} := \frac{5 \cdot W_v \cdot L^4}{384 \cdot E_r \cdot I_{xtotr}}$$

$$\Delta_{xr1} = 0 \quad \text{in}$$

$$\Delta_{allr} := \frac{L}{96}$$

$$\Delta_{allr} = 0.63 \quad \text{in} \quad \text{Per ASTM Specification E985}$$

$$M_{yrmax} := \frac{W_h \cdot L^2}{K_1}$$

$$M_{yrmax} = 1875 \quad \text{lb-in}$$

$$M_{xrmax} := \frac{W_v \cdot L^2}{K_1}$$

$$M_{xrmax} = 0 \quad \text{lb-in}$$



$$f_{bry1} := \frac{M_{yrmax}}{S_{yr}}$$

$$f_{bry1} = 5752 \quad \text{psi}$$

$$f_{brx1} := \frac{M_{xrmax}}{S_{xr}}$$

$$f_{brx1} = 0 \quad \text{psi}$$

Case 2 - Point Load:

$$\Delta_{yr2} := \frac{P \cdot L^3}{K_3 \cdot E_r \cdot I_{ytotr}}$$

$$\Delta_{yr2} = 0.209 \quad \text{in}$$

$$M_{yrmax2} := \frac{P \cdot L}{K_2}$$

$$M_{yrmax2} = 2400 \quad \text{lb-in}$$

$$f_{bry2} := \frac{M_{yrmax2}}{S_{yr}}$$

$$f_{bry2} = 7362 \quad \text{psi}$$

$$F_{bry} := \begin{cases} (F_{bry1} \cdot 1.33) & \text{if IBC} = 1 \\ F_{bry1} & \text{otherwise} \end{cases}$$

$$F_{bry} = 25000 \quad \text{psi}$$

Calculation Results:

$$Int_{r1} := \left(\frac{f_{brx1}}{F_{bry}} \right) + \left(\frac{f_{bry1}}{F_{bry}} \right)$$

$$Int_{r1} = 0.23$$

$$Int_{r2} := \frac{f_{bry2}}{F_{bry}}$$

$$Int_{r2} = 0.29$$

$$RAILS := \begin{cases} \text{"OK"} & \text{if } \frac{\max(\Delta_{yr1}, \Delta_{xr1}, \Delta_{yr2})}{\Delta_{allr}} \leq 1 \wedge \left(\frac{f_{brx1}}{F_{bry}} \right) + \left(\frac{f_{bry1}}{F_{bry}} \right) \leq 1 \wedge \frac{f_{bry2}}{F_{bry}} \leq 1 \\ \text{"FAIL"} & \text{otherwise} \end{cases}$$

$$RAILS = \text{"OK"}$$

RICE ENGINEERING Template: REI-MC-5707	105 School Creek Trail Luxemburg, WI 54217 Phone: (920)845-1042 Fax: (920)845-1048 www.rice-inc.com	Project Description:	Job No: R11-10-240
		RMR 80KD System	Engineer: JDB Sheet No: A1 A
			Date: 10/24/11 Rev:
			Chk By: Date:

Post Analysis:

$E_p := E_r$

Guardrail "A" Analysis	SHT A1 B
------------------------	-------------

$$\Delta_{xp1} := \frac{W_h \cdot L \cdot (h - L_{st})^3}{3 \cdot E_p \cdot (I_{xp})}$$

$\Delta_{xp1} = 0.832$ in

$$\Delta_{xp2} := \frac{P \cdot 0.85 \cdot (h - L_{st})^3}{3 \cdot E_p \cdot (I_{xp})}$$

$\Delta_{xp2} = 0.566$ in

Max Deflection:

$$\Delta_{tot} := \frac{W_h \cdot L \cdot (h - L_{st})^3}{3 \cdot E_p \cdot I_{xp}} + \frac{W_h \cdot L \cdot [h^3 - (h - L_{st})^3]}{3 \cdot [(E_p \cdot I_{xp}) + (E_p \cdot I_{st})]}$$

$\Delta_{tot} = 1.474$ in

$$\Delta_{allp} := \frac{h}{12}$$

$\Delta_{allp} = 3.42$ in Per ASTM E985

Case 1 - Uniform Load:

$$M_{xp} := (W_h \cdot L \cdot h) + W_v \cdot L \cdot \Delta_{tot}$$

$$M_{xpmax} := 0.5 \cdot M_{xp} \cdot q1 + M_{xp} \cdot q2 + M_{xp} \cdot q3$$

$M_{xpmax} = 10250$ lb-in

$$M_{xp2} := W_h \cdot L \cdot (h - L_{st}) + W_v \cdot L \cdot \Delta_{xp1}$$

$$M_{xpmax2} := 0.5 \cdot M_{xp2} \cdot q1 + M_{xp2} \cdot q2 + M_{xp2} \cdot q3$$

$M_{xpmax2} = 7875$ lb-in

Case 2 - Point Load:

$$M_{xpmax4} := P \cdot (h - L_{st}) \cdot 0.85$$

$M_{xpmax4} = 5355$ lb-in

$$M_{xpmax3} := (P \cdot h \cdot 0.85)$$

$M_{xpmax3} = 6970$ lb-in

Max Post Stress:

$$f_{bpx} := \frac{\max(M_{xpmax2}, M_{xpmax4})}{S_{xp}}$$

$f_{bpx} = 24156$ psi

$$F_{bpx} := \begin{cases} (f_{bpx} \cdot 1.33) & \text{if IBC} = 1 \\ f_{bpx} & \text{otherwise} \end{cases}$$

$F_{bpx} = 25000$ psi

Max Post/Stub Combined Stress:

$$f_{bpx2} := \max(M_{xpmax}, M_{xpmax3}) \cdot \frac{I_{xp}}{(I_{xp} + I_{st}) \cdot S_{xp}}$$

$f_{bpx2} = 20138$ psi

$F_{bpx} = 25000$ psi

Max Stub Stress:

$$f_{bst} := \max(M_{xpmax}, M_{xpmax3}) \cdot \frac{I_{st}}{(I_{xp} + I_{st}) \cdot S_{st}}$$

$f_{bst} = 16451$ psi

$F_{bst} = 25000$ psi

Calculation Results:

$$Intp1 := \max\left(\frac{f_{bpx}}{F_{bpx}}, \frac{f_{bpx2}}{F_{bpx}}, \frac{f_{bst}}{F_{bst}}\right)$$

$Intp1 = 0.97$



$$POSTS := \begin{cases} \text{"OK"} & \text{if } Intp1 \leq 1 \wedge \frac{\max(\Delta_{xp1}, \Delta_{xp2}, \Delta_{tot})}{\Delta_{allp}} \leq 1 \\ \text{"FAIL"} & \text{otherwise} \end{cases}$$

$POSTS = \text{"OK"}$

RICE ENGINEERING Template: REI-MC-5707	105 School Creek Trail Luxemburg, WI 54217 Phone: (920)845-1042 Fax: (920)845-1048 www.rice-inc.com	Project Description:	Job No: R11-10-240
	RMR 80KD System	Engineer: JDB	Sheet No: A1 B
		Date: 10/24/11	Rev:
		Chk By:	Date:

2-Bolt Base Plate

SHT A2

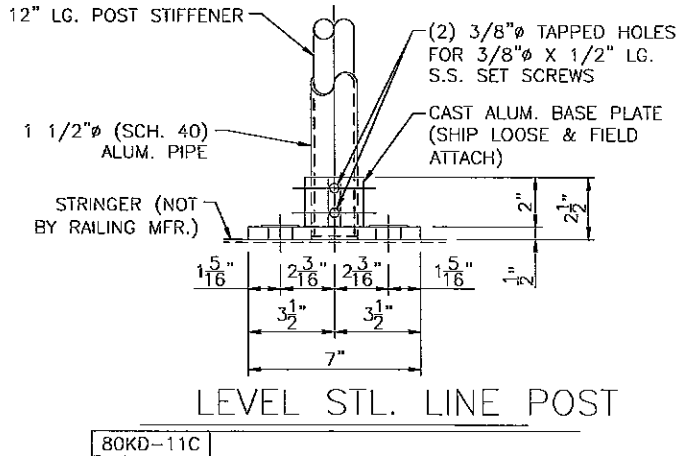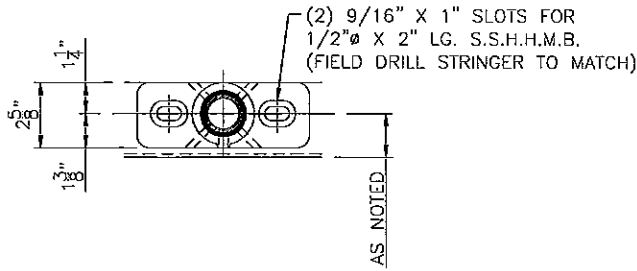

$$R_{max} := 250 \quad \text{lb}$$

$$M_{max} := 10250 + R_{max} \cdot 2.5 = 10875 \quad \text{lb-in}$$

$$d := 2.5 \quad \text{in (sleeve dia.)}$$

Chk shear on shoe wall:

$$P := \frac{M_{max}}{0.85 \cdot (2.375)} \quad P = 5387 \quad \text{lb}$$

$$f_v := \frac{(P + R_{max})}{2 \cdot (0.315) \cdot (2)} \quad f_v = 4474 \quad \text{psi}$$

$$F_v := \frac{0.57 \cdot (18000)}{1.65} \quad F_v = 6218 \quad \text{psi}$$

$$I := \frac{f_v}{F_v} \quad I = 0.72 \quad \text{Shear Stress "OK"}$$

Separate Dissimilar Metals

Chk Aluminum Base Plate:

$$L1 := 7 \quad \text{in} \quad D1 := 1.3125 \quad \text{in}$$

$$L2 := 2.625 \quad \text{in} \quad D2 := 1.25 \quad \text{in}$$

$$t := 0.563 \quad \text{in}$$

$$L := L1 - (2 \cdot D1) \quad L = 4.38 \quad \text{in}$$

$$P := \frac{M_{max}}{d} \quad P = 4350 \quad \text{lb}$$

$$M_{p1} := 0.5 \cdot P \cdot 0.9375 \quad M_{p1} = 2039 \quad \text{in-lb}$$

$$F_y := \frac{1.3 \cdot (18000)}{1.65} \quad F_y = 14182 \quad \text{psi}$$

$$t_{req1} := \sqrt{\frac{M_{p1} \cdot 6}{F_y \cdot L2}} \quad t_{req1} = 0.573 \quad \text{in}$$

$$I_2 := \frac{t_{req1}}{t} \quad I_2 = 1.02 \quad \text{2% Over OK}$$

Chk Bolts to Steel Stringer:

$$V_b := \frac{R_{max}}{2} \quad V_b = 125 \quad \text{lb}$$

$$T_b := \frac{M_{max}}{2 \cdot 1.25} \quad T_b = 4350 \quad \text{lb}$$

$$V_{all} := 0.196 \cdot 23094 \quad V_{all} = 4526 \quad \text{lb}$$

$$T_{all} := 0.142 \cdot 40000 \quad T_{all} = 5680 \quad \text{lb}$$



$$I_3 := \left(\frac{V_b}{V_{all}} \right)^2 + \left(\frac{T_b}{T_{all}} \right)^2 \quad I_3 = 0.59$$

Use (2) - 1/2" Dia. S.S. Thru-Bolts
Condition "CW" - $F_y = 65 \text{ ksi}$

Use Cast Aluminum Base, as shown
535 casting alloy, $F_u = 35 \text{ ksi min.}$

RICE ENGINEERING Template:	105 School Creek Trail Luxemburg, WI 54217 Phone: (920)845-1042 Fax: (920)845-1048 www.rice-inc.com	Project Description: RMR 80KD System	Job No: R11-10-240	
			Engineer: JDB	Sheet No: A2
			Date: 10/24/11	Rev:
			Chk By:	Date:

Corner Base Plate	SHT A3
-------------------	-----------

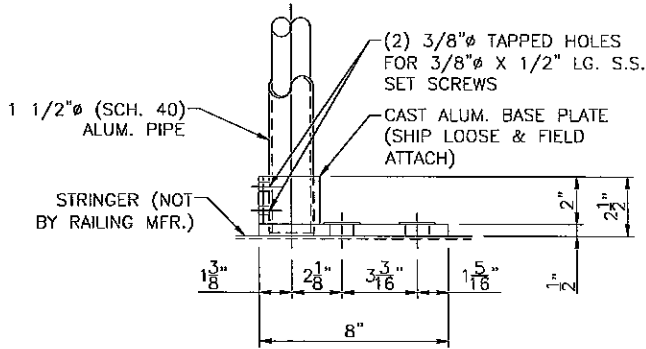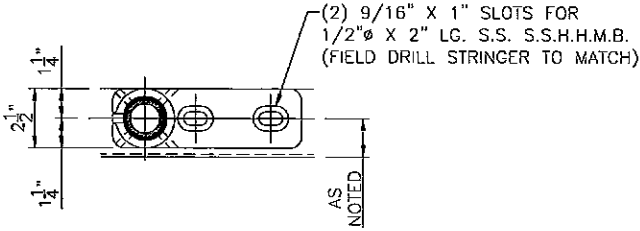

LEVEL STL. CORNER POST
80KD-12C

Separate Dissimilar Metals

$R_{max} := 101$ lb *Reactions from RISA Model*
 $M_{max} := 0$ lb-in *(Corner Post Modeled as a Pin Connection)*
 $d := 2.5$ in (sleeve dia.)

Chk shear on shoe wall:

$P := \frac{M_{max}}{0.85 \cdot (2.375)}$ $P = 0$ lb
 $f_v := \frac{(P + R_{max})}{2 \cdot (0.315) \cdot (2)}$ $f_v = 80$ psi
 $F_v := \frac{0.57 \cdot (18000)}{1.65}$ $F_v = 6218$ psi
 $I := \frac{f_v}{F_v}$ $I = 0.01$ **Shear Stress "OK"**

Chk Aluminum Base Plate:

$L1 := 7$ in $D1 := 1.3125$ in
 $L2 := 2.625$ in $D2 := 1.25$ in
 $t := 0.563$ in
 $L := L1 - (2 \cdot D1)$ $L = 4.38$ in
 $P := \frac{M_{max}}{d}$ $P = 0$ lb
 $M_{p1} := P \cdot 0.9375$ $M_{p1} = 0$ in-lb
 $F_y := \frac{1.3 \cdot (18000)}{1.65}$ $F_y = 14182$ psi
 $t_{req1} := \sqrt{\frac{M_{p1} \cdot 6}{F_y \cdot L2}}$ $t_{req1} = 0$ in
 $I_2 := \frac{t_{req1}}{t}$ $I_2 = 0$



Chk Bolts to Steel Stringer:

$V_b := \frac{R_{max}}{2}$ $V_b = 50.5$ lb
 $T_b := \frac{M_{max}}{2 \cdot 1.25}$ $T_b = 0$ lb
 $V_{all} := 0.196 \cdot 23094$ $V_{all} = 4526$ lb
 $T_{all} := 0.142 \cdot 40000 \cdot \frac{0.1875}{0.456}$ $T_{all} = 2336$ lb
 $I_3 := \left(\frac{V_b}{V_{all}}\right)^2 + \left(\frac{T_b}{T_{all}}\right)^2$ $I_3 = 0$

Use (2) - 1/2" Dia. S.S. Thru-Bolts or Drill & Tap - 3/16" Min. Thread Engagement
 Condition "CW" - $F_y = 65$ ksi

Use Cast Aluminum Base, as shown
 535 casting alloy, $F_u = 35$ ksi min.

RICE ENGINEERING Template:	105 School Creek Trail Luxemburg, WI 54217 Phone: (920)845-1042 Fax: (920)845-1048 www.rice-inc.com	Project Description: RMR 80KD System	Job No: R11-10-240
			Engineer: JDB Sheet No: A3
			Date: 10/24/11 Rev:
			Chk By: Date:

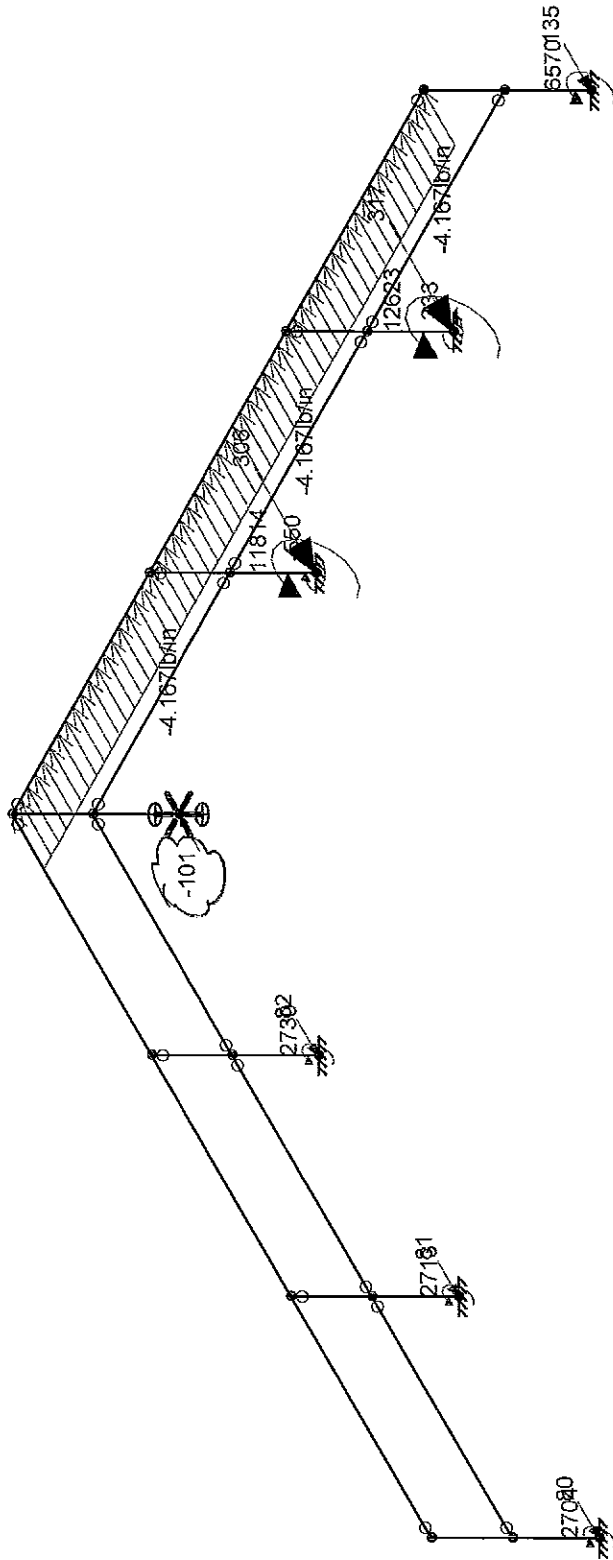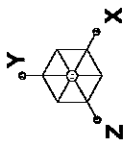

Loads: BLC 1,
 Results for LC 1, Dist 1
 Z-moment Reaction units are lb and lb-in



Rice Engineering

Joe Bauer

SK - 1

Feb 23, 2011 at 5:24 PM

Corner Bracket A.r3d

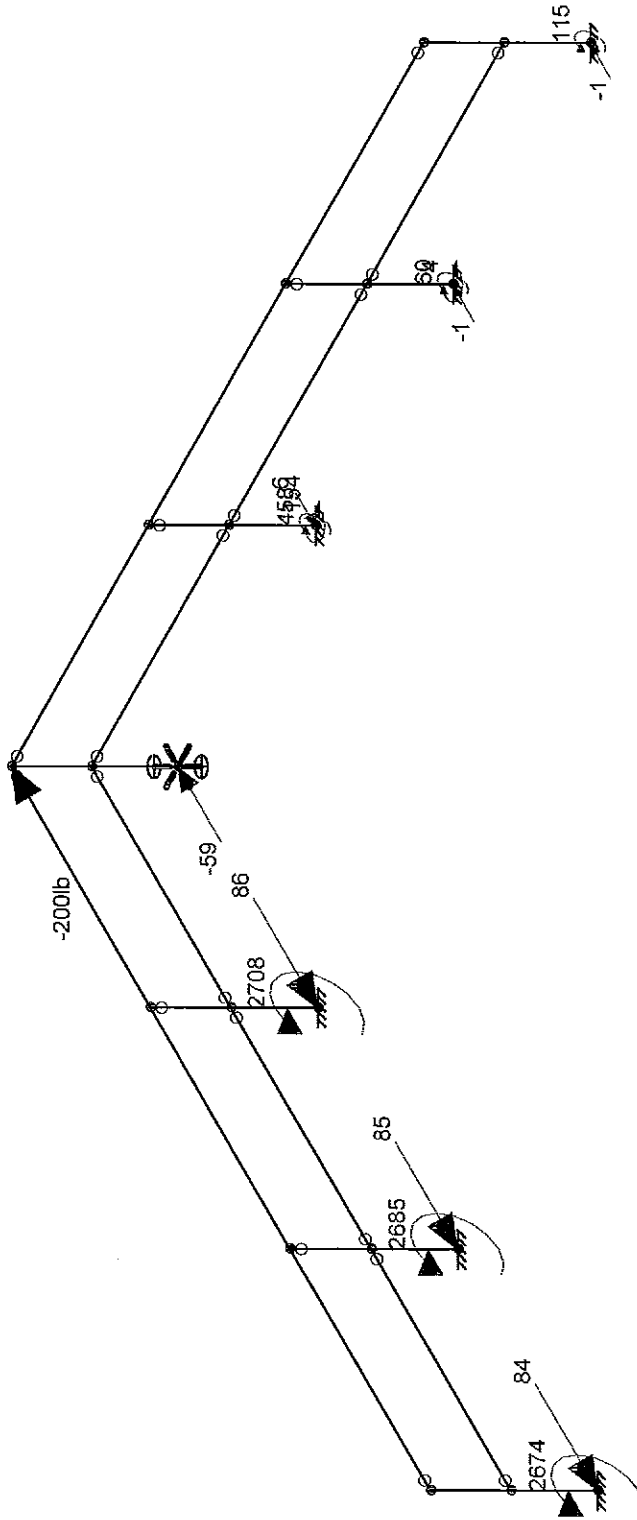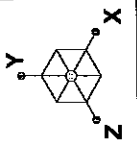

Loads: BLC 2,
 Results for LC 2, Point
 Z-moment Reaction units are lb and lb-in


Rice Engineering

Joe Bauer

SK - 2

Feb 23, 2011 at 5:24 PM

Corner Bracket A.r3d

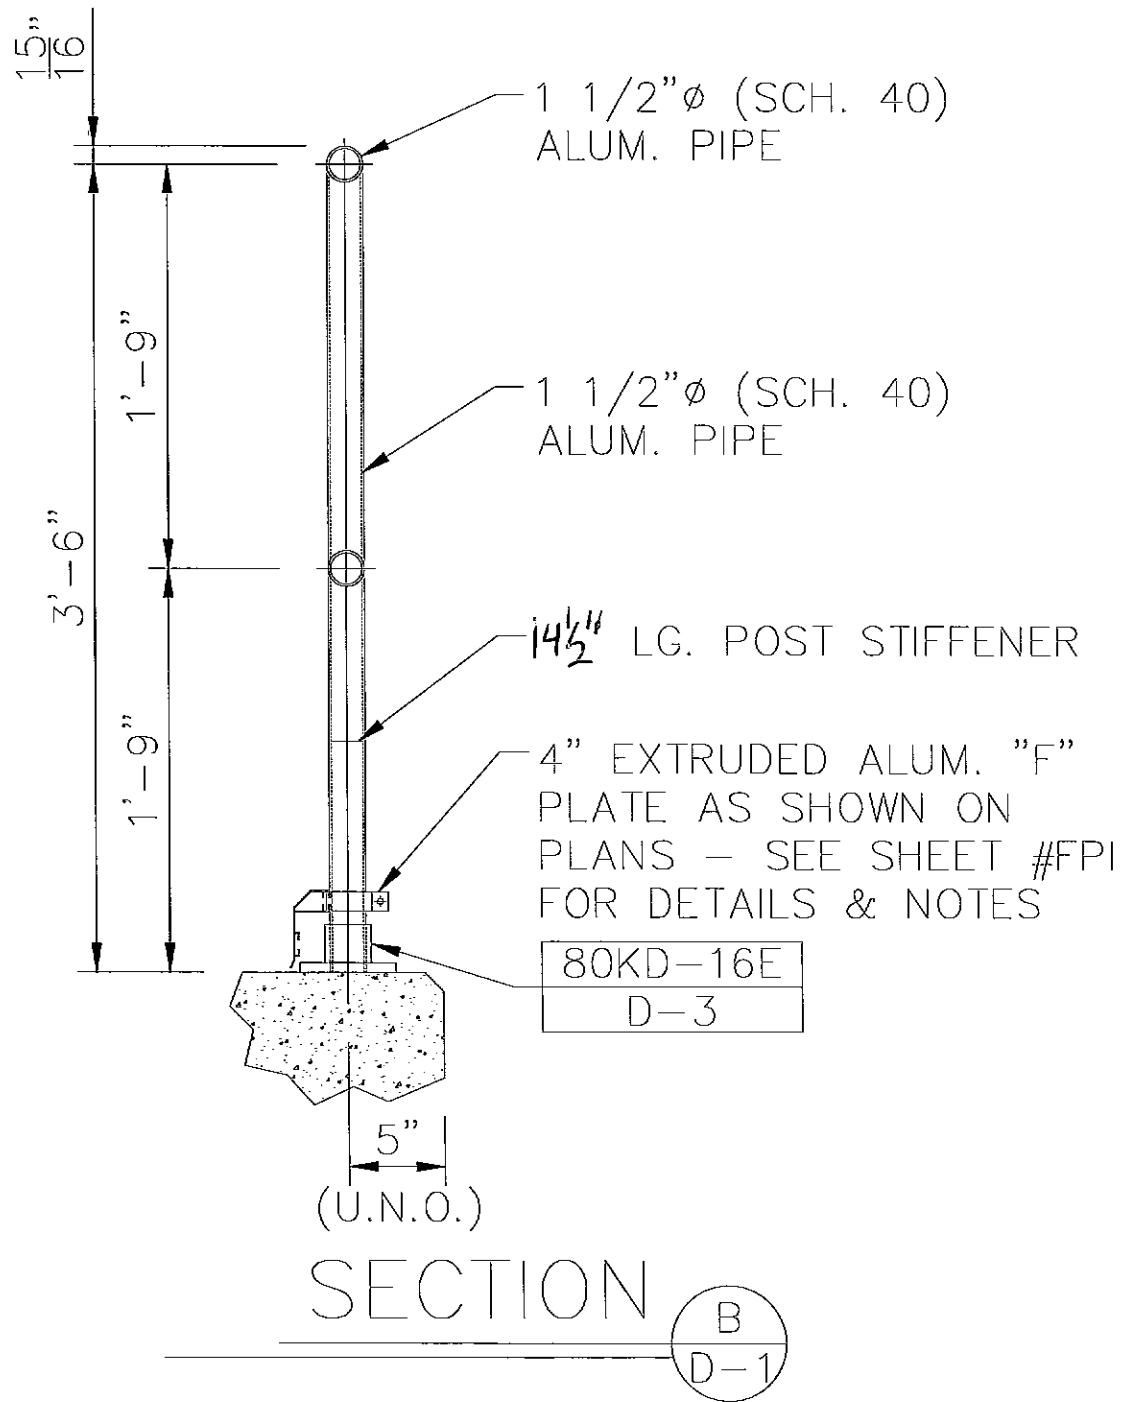

Note: Structural steel, Concrete, CMU and all other anchorage substrates designed by others



ROCKY MOUNTAIN RAILINGS

RICE ENGINEERING Template: REI-MC-5707	105 School Creek Trail Luxemburg, WI 54217 Phone: (920)845-1042 Fax: (920)845-1048 www.rice-inc.com	Project Description: RMR 80KD System	Job No: R11-10-240
			Engineer: JDB Sheet No: B
			Date: 10/24/11 Rev:
			Chk By: Date:

Pipe Railing & Post

These calculations are based on empirical test data performed by Julius Blum & Co., Inc.

Guardrail "B" Analysis	SHT B1
------------------------	-----------

Input Variables:

- $F_H := 50$ plf Load Case 1 (Uniform Load)
- $F_V := 0$ plf Simultaneous Vertical Uniform Load
- $P := 200$ lb Load Case 2 (Point Load)
- $L_{bp} := 19.5$ in Unbraced Length of Post
- $h := 39.5$ in Railing Height Above Base Flange
- $L := 72$ in **6'-0" MAX POST SPACING**

Number of Railing Spans:

- 1 span
- 2 span
- 3 or more spans

Railing Section:

- 1 1/4" Schd. 40
- 1 1/4" Schd. 80
- 1 1/2" Schd. 40
- 1 1/2" Schd. 80
- 1 1/2" tube
- 2" Schd. 40
- 2" Schd. 80

Railing Temper:


- 6063-T5
- 6063-T6
- 6061-T6 or 6105-T5
- 4/3 increase allowed

Post Section:

- 1 1/4" Schd. 40
- 1 1/4" Schd. 80
- 1 1/2" Schd. 40
- 1 1/2" Schd. 80
- 1 1/2" tube
- 2" Schd. 40
- 2" Schd. 80

Post Temper:

- 6063-T6
- 6005-T5
- 6061-T6 or 6105-T5
- Post Welded to Base Plate

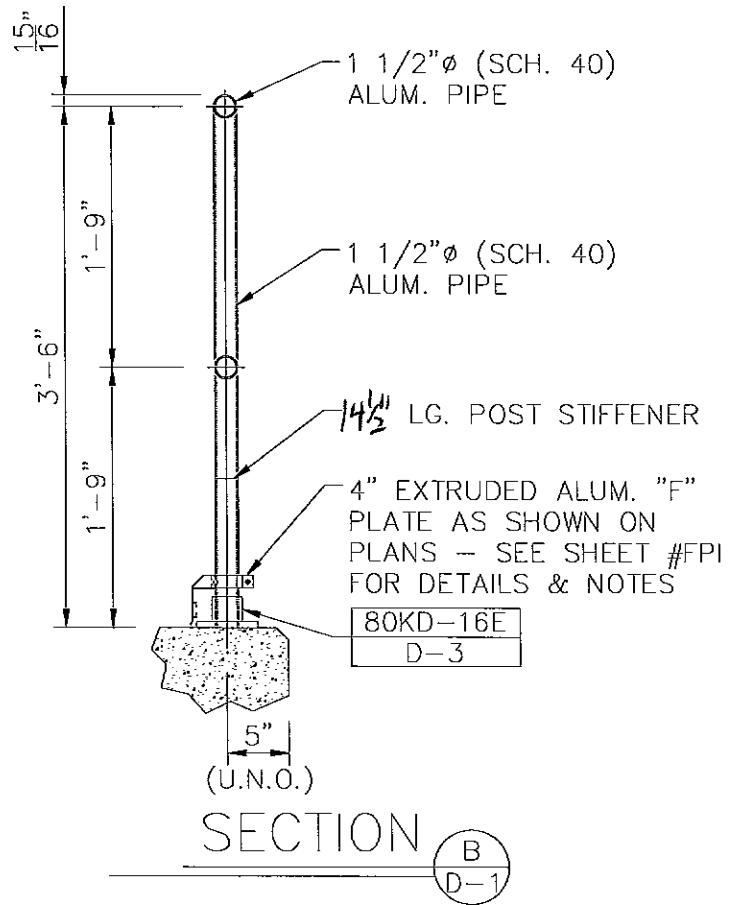

All calculations below this line are automatic

Railing Properties

$I_{xr} =$	0.31
$I_{yr} =$	0.31
$S_{xr} =$	0.326
$S_{yr} =$	0.326
$R =$	0.95
$t =$	0.145

$E_r := 10100000$ psi

$I_{xtotr} := I_{xr}$ $I_{xtotr} = 0.31$ in⁴

$I_{ytotr} := I_{yr}$ $I_{ytotr} = 0.31$ in⁴

Post Properties

$I_{xp} =$	0.31
$I_{yp} =$	0.31
$S_{xp} =$	0.326
$S_{yp} =$	0.326
$R =$	0.95
$t =$	0.145

$I_{xtotp} := I_{xp}$ $I_{xtotp} = 0.31$ in⁴

$I_{ytop} := I_{yp}$ $I_{ytop} = 0.31$ in⁴

Computational Factors

$$S_{R1} = \frac{R_r}{t_r} \quad S_{R1} = 6.55 \quad K_1 := (8 \cdot q_1) + (8 \cdot q_2) + (9.5 \cdot q_3) \quad K_1 = 8$$

$$S_{R3} = \frac{R_p}{t_p} \quad S_{R3} = 6.55 \quad K_2 := (4 \cdot q_1) + (5 \cdot q_2) + (5 \cdot q_3) \quad K_2 = 5$$

$$K_3 := (48 \cdot q_1) + (66 \cdot q_2) + (87 \cdot q_3) \quad K_3 = 66$$

14.5" Min. Length AL. Ribbed Tube Stub

$$I_{st} := 0.174 \text{ in}^4 \quad L_{st} := 12 \text{ in}$$

$$S_{st} := 0.224 \text{ in}^3 \quad F_{bst} := 25000 \text{ psi}$$

RICE ENGINEERING Template: REI-MC-5707	105 School Creek Trail Luxemburg, WI 54217 Phone: (920)845-1042 Fax: (920)845-1048 www.rice-inc.com	Project Description: RMR 80KD System	Job No: R11-10-240
			Engineer: JDB Sheet No: B1
			Date: 10/24/11 Rev:
			Chk By: Date:

Railing Analysis:

$$W_h := \frac{F_H}{12}$$

$$W_v := \frac{F_V}{12}$$

Guardrail "B" Analysis	SHT B1 A
------------------------	-------------

Case 1 Uniform Load:

$$\Delta_{yr1} := \frac{5 \cdot W_h \cdot L^4}{384 \cdot E_r \cdot I_{ytotr}}$$

$\Delta_{yr1} = 0.466$ in Modeled as a simple span

$$\Delta_{xr1} := \frac{5 \cdot W_v \cdot L^4}{384 \cdot E_r \cdot I_{xtotr}}$$

$\Delta_{xr1} = 0$ in

$$\Delta_{allr} := \frac{L}{96}$$

$\Delta_{allr} = 0.75$ in Per ASTM Specification E985

$$M_{yrmax} := \frac{W_h \cdot L^2}{K_1}$$

$M_{yrmax} = 2700$ lb-in

$$M_{xrmax} := \frac{W_v \cdot L^2}{K_1}$$

$M_{xrmax} = 0$ lb-in



$$f_{bry1} := \frac{M_{yrmax}}{S_{yr}}$$

$f_{bry1} = 8282$ psi

$$f_{brx1} := \frac{M_{xrmax}}{S_{xr}}$$

$f_{brx1} = 0$ psi

Case 2 - Point Load:

$$\Delta_{yr2} := \frac{P \cdot L^3}{K_3 \cdot E_r \cdot I_{ytotr}}$$

$\Delta_{yr2} = 0.361$ in

$$M_{yrmax2} := \frac{P \cdot L}{K_2}$$

$M_{yrmax2} = 2880$ lb-in

$$f_{bry2} := \frac{M_{yrmax2}}{S_{yr}}$$

$f_{bry2} = 8834$ psi

$$F_{bry} := \begin{cases} (f_{bry1} \cdot 1.33) & \text{if } IBC = 1 \\ f_{bry1} & \text{otherwise} \end{cases}$$

$F_{bry} = 25000$ psi

Calculation Results:

$$Int_r1 := \left(\frac{f_{brx1}}{F_{bry}} \right) + \left(\frac{f_{bry1}}{F_{bry}} \right)$$

$Int_r1 = 0.33$

$$Int_r2 := \frac{f_{bry2}}{F_{bry}}$$

$Int_r2 = 0.35$

$$RAILS := \begin{cases} \text{"OK"} & \text{if } \frac{\max(\Delta_{yr1}, \Delta_{xr1}, \Delta_{yr2})}{\Delta_{allr}} \leq 1 \wedge \left(\frac{f_{brx1}}{F_{bry}} \right) + \left(\frac{f_{bry1}}{F_{bry}} \right) \leq 1 \wedge \frac{f_{bry2}}{F_{bry}} \leq 1 \\ \text{"FAIL"} & \text{otherwise} \end{cases}$$

$RAILS = \text{"OK"}$

RICE ENGINEERING Template: REI-MC-5707	105 School Creek Trail Luxemburg, WI 54217 Phone: (920)845-1042 Fax: (920)845-1048 www.rice-inc.com	Project Description:	Job No: R11-10-240
		RMR 80KD System	Engineer: JDB Sheet No: B1 A
			Date: 10/24/11 Rev:
			Chk By: Date:

Post Analysis:

$E_p := E_r$

Guardrail "B" Analysis	SHT
	B1 B

$\Delta_{xp1} := \frac{W_h \cdot L \cdot (h - L_{st})^3}{3 \cdot E_p \cdot (I_{xp})}$

$\Delta_{xp1} = 0.664$ in

$\Delta_{xp2} := \frac{P \cdot 0.85 \cdot (h - L_{st})^3}{3 \cdot E_p \cdot (I_{xp})}$

$\Delta_{xp2} = 0.376$ in

Max Deflection:

$\Delta_{tot} := \frac{W_h \cdot L \cdot (h - L_{st})^3}{3 \cdot E_p \cdot I_{xp}} + \frac{W_h \cdot L \cdot [h^3 - (h - L_{st})^3]}{3 \cdot [(E_p \cdot I_{xp}) + (E_p \cdot I_{st})]}$

$\Delta_{tot} = 1.5$ in

$\Delta_{allp} := \frac{h}{12}$

$\Delta_{allp} = 3.29$ in Per ASTM E985

Case 1 - Uniform Load:

$M_{xp} := (W_h \cdot L \cdot h) + W_v \cdot L \cdot \Delta_{tot}$

$M_{xpmax} := 0.5 \cdot M_{xp} \cdot q1 + M_{xp} \cdot q2 + M_{xp} \cdot q3$

$M_{xpmax} = 11850$ lb-in

$M_{xp2} := W_h \cdot L \cdot (h - L_{st}) + W_v \cdot L \cdot \Delta_{xp1}$

$M_{xpmax2} := 0.5 \cdot M_{xp2} \cdot q1 + M_{xp2} \cdot q2 + M_{xp2} \cdot q3$

$M_{xpmax2} = 8250$ lb-in

Case 2 - Point Load:

$M_{xpmax4} := P \cdot (h - L_{st}) \cdot 0.85$

$M_{xpmax4} = 4675$ lb-in

$M_{xpmax3} := (P \cdot h \cdot 0.85)$

$M_{xpmax3} = 6715$ lb-in

Max Post Stress:

$f_{bpx} := \frac{\max(M_{xpmax2}, M_{xpmax4})}{S_{xp}}$

$f_{bpx} = 25307$ psi

$F_{bpx} := \begin{cases} (f_{bpx} \cdot 1.33) & \text{if } IBC = 1 \\ f_{bpx} & \text{otherwise} \end{cases}$

$F_{bpx} = 25000$ psi

Max Post/Stub Combined Stress:

$f_{bpx2} := \max(M_{xpmax}, M_{xpmax3}) \cdot \frac{I_{xp}}{(I_{xp} + I_{st}) \cdot S_{xp}}$

$f_{bpx2} = 23282$ psi

$F_{bpx} = 25000$ psi

Max Stub Stress:

$f_{bst} := \max(M_{xpmax}, M_{xpmax3}) \cdot \frac{I_{st}}{(I_{xp} + I_{st}) \cdot S_{st}}$

$f_{bst} = 19018$ psi

$F_{bst} = 25000$ psi

Calculation Results:

$Intp1 := \max\left(\frac{f_{bpx}}{F_{bpx}}, \frac{f_{bpx2}}{F_{bpx}}, \frac{f_{bst}}{F_{bst}}\right)$



$Intp1 = 1.01$ 1% Over OK

$POSTS := \begin{cases} \text{"OK"} & \text{if } Intp1 \leq 1.014 \wedge \frac{\max(\Delta_{xp1}, \Delta_{xp2}, \Delta_{tot})}{\Delta_{allp}} \leq 1 \\ \text{"FAIL"} & \text{otherwise} \end{cases}$

$POSTS = \text{"OK"}$

RICE ENGINEERING Template: REI-MC-5707	105 School Creek Trail Luxemburg, WI 54217 Phone: (920)845-1042 Fax: (920)845-1048 www.rice-inc.com	Project Description: RMR 80KD System	Job No: R11-10-24O
			Engineer: JDB Sheet No: B1 B
			Date: 10/24/11 Rev:
			Chk By: Date:

Surface Mount Anchor Analysis	SHT B2
----------------------------------	-----------

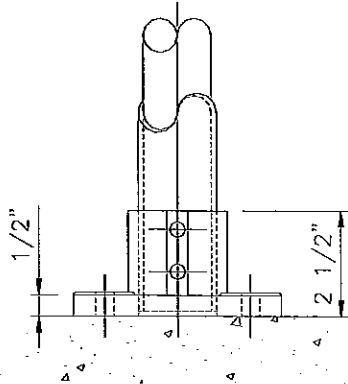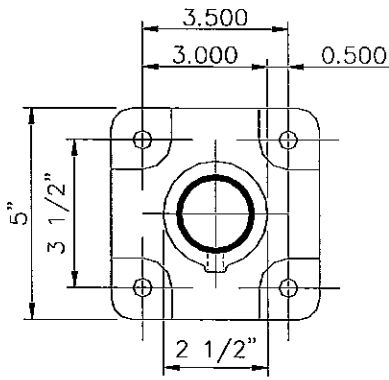

$$R_{\max} := 300 \quad \text{lb}$$

$$M_{\max} := 11850 + R_{\max} \cdot 2.5 = 12600 \quad \text{lb-in}$$

$$d := 2.5 \quad \text{in (sleeve dia.)}$$

Chk shear on shoe wall:

$$P := \frac{M_{\max}}{0.85 \cdot (2.375)} \quad P = 6241 \quad \text{lb}$$

$$f_v := \frac{(P + R_{\max})}{2 \cdot (0.315) \cdot (2)} \quad f_v = 5192 \quad \text{psi}$$

$$F_v := \frac{0.57 \cdot (18000)}{1.65} \quad F_v = 6218 \quad \text{psi}$$

$$I := \frac{f_v}{F_v} \quad I = 0.83 \quad \text{Shear Stress "OK"}$$

Chk Anchor Bolts (assume $f'_c = 4,000$ psi conc.):

$$V_b := \frac{R_{\max}}{2} \cdot 1.6 \quad V_b = 240 \quad \text{lb}$$

$$T_b := \frac{M_{\max}}{(L1 - D2) \cdot 0.85 \cdot 1} \cdot 1.6 \quad T_b = 5581 \quad \text{lb}$$

See Next Sheet for Calculation

**Use (4) - 1/2" Dia. S.S. Threaded Rods
W/ Hilti HIT-RE 500 SD Epoxy Adhesive**
 Embedment= 4-1/2"
 Edge Distance= 3-1/4"
 End Distance = 5-1/4"

Chk Aluminum Base Plate:

$$L1 := 5 \quad \text{in} \quad D1 := 0.75 \quad \text{in}$$

$$L2 := 5 \quad \text{in} \quad D2 := 0.75 \quad \text{in}$$

$$L := L2 - (2 \cdot D2) \quad L = 3.5 \quad \text{in}$$

$$F_y := \frac{1.3 \cdot (18000)}{1.65} \quad F_y = 14182 \quad \text{psi}$$

$$P := \frac{M_{\max}}{d \cdot 2} \quad P = 2520 \quad \text{lb}$$

$$M_{pl} := \frac{P \cdot 0.5 \cdot 3^2}{3.5^2} \quad M_{pl} = 926 \quad \text{in-lb}$$

$$t_{req} := \sqrt{\frac{M_{pl} \cdot 6}{F_y \cdot 5}} \quad t_{req} = 0.28 \quad \text{in}$$

$$I := \frac{t_{req}}{0.5} \quad I = 0.56 \quad \text{Bending Stress "OK"}$$

Use Cast Aluminum Base, as shown
 535 casting alloy, $F_u = 35$ ksi min.


RICE ENGINEERING Template:	105 School Creek Trail Luxemburg, WI 54217 Phone: (920)845-1042 Fax: (920)845-1048 www.rice-inc.com	Project Description: RMR 80KD System	Job No: R11-10-240
			Engineer: JDB Sheet No: B2
			Date: 10/24/11 Rev:
			Chk By: Date:

Company:
 Specifier:
 Address:
 Phone | Fax: - | -
 E-Mail:

Page: 1
 Project:
 Sub-Project | Pos. No.:
 Date: 10/25/2011

Specifier's comments:
Input data

Anchor type and diameter: HIT-RE 500-SD + HAS-R 304/316, 1/2
Effective embedment depth: $h_{ef,act} = 4.500$ in. ($h_{ef,limit} = -$ in.)
Material: ASTM F 593
Evaluation Service Report:: ESR 2322
Issued | Valid: 4/1/2010 | -
Proof: design method ACI 318 / AC308
Stand-off installation: $e_b = 0.000$ in. (no stand-off); $t = 0.500$ in.
Anchor plate: $l_x \times l_y \times t = 3.000 \times 6.000 \times 0.500$ in. (Recommended plate thickness: not calculated)
Profile: no profile
Base material: uncracked concrete, 4000, $f'_c = 4000$ psi; $h = 8.000$ in., Temp. short/long: 32/32°F
Installation: hammer drilled hole, installation condition: dry
Reinforcement: tension: condition B, shear: condition B; no supplemental splitting reinforcement present
 edge reinforcement: none or < No. 4 bar
 Seismic loads (cat. C, D, E, or F): no

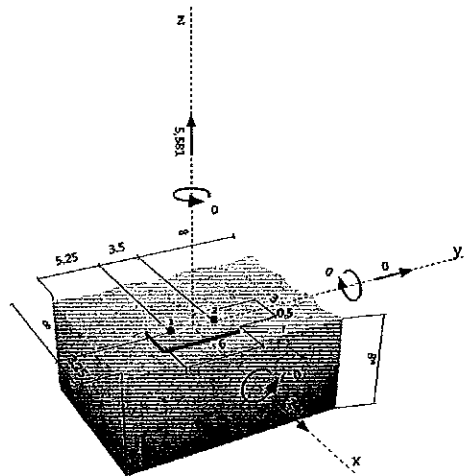
Geometry [in.] & Loading [lb, in.-lb]

Proof | Utilization (Governing Cases)

Loading	Proof	Design values [lb]		Utilization [%]	Status
		Load	Capacity	β_N / β_V	
Tension	Concrete Breakout Strength	5581	5582	100 / -	OK
Shear	Concrete edge failure in direction x+	240	3702	- / 6	OK
Loading	β_N	β_V	ζ	Utilization $\beta_{N,V}$ [%]	Status
Combined tension and shear loads	1.000	0.065	-	89	OK

Warnings

• Please consider all details and hints/warnings given in the detailed report!

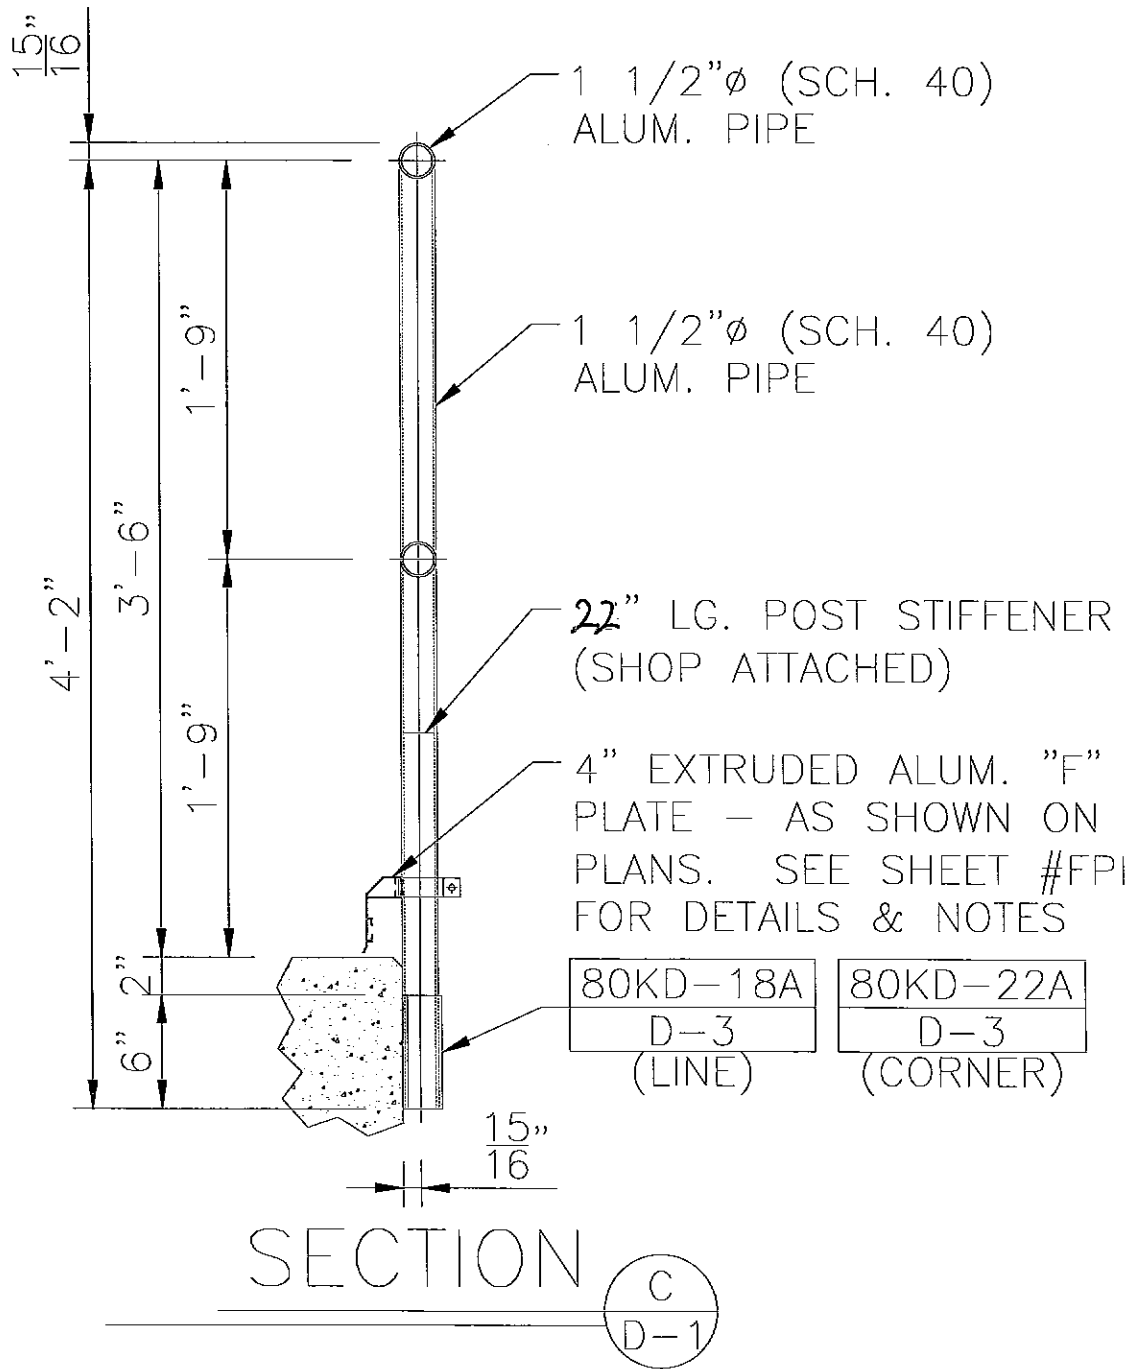Fastening meets the design criteria!



Note: Structural steel, Concrete, CMU and all other anchorage substrates designed by others



ROCKY MOUNTAIN RAILINGS

RICE ENGINEERING Template: REI-MC-5707	105 School Creek Trail Luxenburg, WI 54217 Phone: (920)845-1042 Fax: (920)845-1048 www.rice-inc.com	Project Description: RMR 80KD System	Job No: R11-10-240	
			Engineer: JDB	Sheet No: C
			Date: 10/24/11	Rev:
			Chk By:	Date:

Pipe Railing & Post

These calculations are based on empirical test data performed by Julius Blum & Co., Inc.

Guardrail "C" Analysis	SHT C1
------------------------	-----------

Input Variables:

$F_H := 50$	plf	Load Case 1 (Uniform Load)
$F_v := 0$	plf	Simultaneous Vertical Uniform Load
$P := 200$	lb	Load Case 2 (Point Load)
$L_{bp} := 23$	in	Unbraced Length of Post
$h := 44$	in	Railing Height Above Anchor Bracket
$L := 72$	in	6'-0" MAX POST SPACING

Number of Railing Spans:

- 1 span
- 2 span
- 3 or more spans

Railing Section:

- 1 1/4" Schd. 40
- 1 1/4" Schd. 80
- 1 1/2" Schd. 40
- 1 1/2" Schd. 80
- 1 1/2" tube
- 2" Schd. 40
- 2" Schd. 80

Railing Temper:


- 6063-T5
- 6063-T6
- 6061-T6 or 6105-T5
- 4/3 increase allowed

Post Section:

- 1 1/4" Schd. 40
- 1 1/4" Schd. 80
- 1 1/2" Schd. 40
- 1 1/2" Schd. 80
- 1 1/2" tube
- 2" Schd. 40
- 2" Schd. 80

Post Temper:

- 6063-T6
- 6005-T5
- 6061-T6 or 6105-T5
- Post Welded to Base Plate

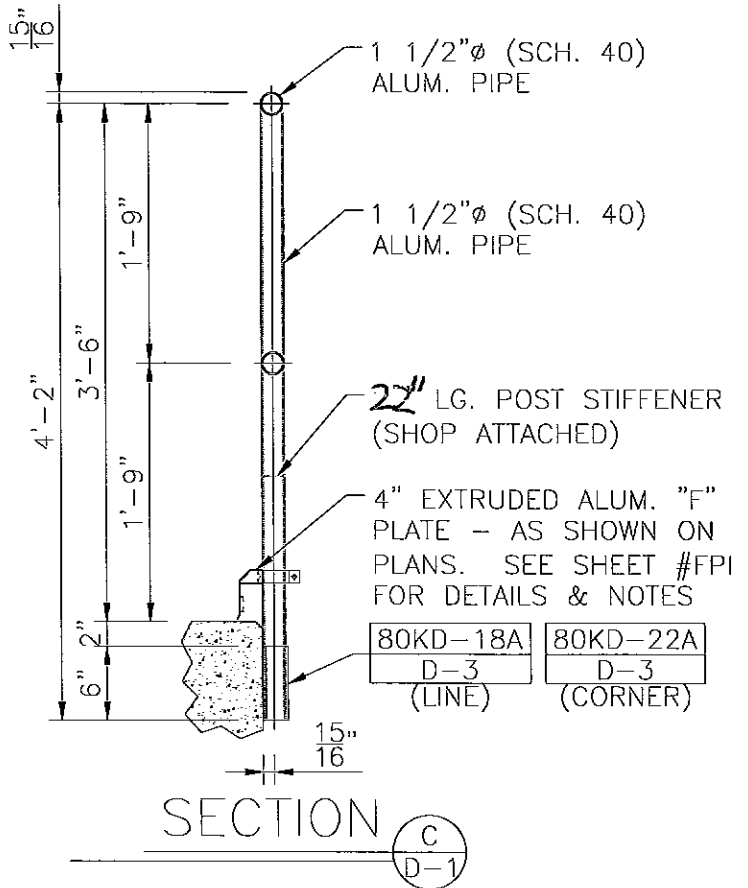

All calculations below this line are automatic

Railing Properties

$k_{xr} =$	0.31
$l_{yr} =$	0.31
$S_{xr} =$	0.326
$S_{yr} =$	0.326
$R =$	0.95
$t =$	0.145

$E_r := 10100000$ psi

$I_{xtot} := I_{xr}$	$I_{xtot} = 0.31$ in ⁴
$I_{ytot} := I_{yr}$	$I_{ytot} = 0.31$ in ⁴

Post Properties

$k_{rp} =$	0.31
$l_{yp} =$	0.31
$S_{xp} =$	0.326
$S_{yp} =$	0.326
$R =$	0.95
$t =$	0.145

$I_{xtot} := I_{xp}$	$I_{xtot} = 0.31$ in ⁴
$I_{ytot} := I_{yp}$	$I_{ytot} = 0.31$ in ⁴

Computational Factors

$$S_{R1} := \frac{R_r}{t_r} \quad S_{R1} = 6.55 \quad K_1 := (8 \cdot q_1) + (8 \cdot q_2) + (9.5 \cdot q_3) \quad K_1 = 8$$

$$S_{R3} := \frac{R_p}{t_p} \quad S_{R3} = 6.55 \quad K_2 := (4 \cdot q_1) + (5 \cdot q_2) + (5 \cdot q_3) \quad K_2 = 5$$

$$K_3 := (48 \cdot q_1) + (66 \cdot q_2) + (87 \cdot q_3) \quad K_3 = 66$$

22" Min. Length AL. Ribbed Tube Stub

$$I_{st} := 0.174 \text{ in}^4 \quad L_{st} := 16 \text{ in}$$

$$S_{st} := 0.224 \text{ in}^3 \quad F_{bst} := 25000 \text{ psi}$$

RICE ENGINEERING Template: REL-MC-5707	105 School Creek Trail Luxemburg, WI 54217 Phone: (920)845-1042 Fax: (920)845-1048 www.rice-inc.com	Project Description: RMR 80KD System	Job No: R11-10-240	
			Engineer: JDB	Sheet No: C1
			Date: 10/24/11	Rev:
			Chk By:	Date:

Railing Analysis:

$$W_h := \frac{F_H}{12}$$

$$W_v := \frac{F_V}{12}$$

Guardrail "C" Analysis	SHT CI A
------------------------	-------------

Case 1 Uniform Load:

$$\Delta_{yr1} := \frac{5 \cdot W_h \cdot L^4}{384 \cdot E_r \cdot I_{ytotr}}$$

$$\Delta_{yr1} = 0.466 \quad \text{in} \quad \text{Modeled as a simple span}$$

$$\Delta_{xr1} := \frac{5 \cdot W_v \cdot L^4}{384 \cdot E_r \cdot I_{xtotr}}$$

$$\Delta_{xr1} = 0 \quad \text{in}$$

$$\Delta_{allr} := \frac{L}{96}$$

$$\Delta_{allr} = 0.75 \quad \text{in} \quad \text{Per ASTM Specification E985}$$

$$M_{yrmax} := \frac{W_h \cdot L^2}{K_1}$$

$$M_{yrmax} = 2700 \quad \text{lb-in}$$

$$M_{xrmax} := \frac{W_v \cdot L^2}{K_1}$$

$$M_{xrmax} = 0 \quad \text{lb-in}$$



$$f_{bry1} := \frac{M_{yrmax}}{S_{yr}}$$

$$f_{bry1} = 8282 \quad \text{psi}$$

$$f_{brx1} := \frac{M_{xrmax}}{S_{xr}}$$

$$f_{brx1} = 0 \quad \text{psi}$$

Case 2 - Point Load:

$$\Delta_{yr2} := \frac{P \cdot L^3}{K_3 \cdot E_r \cdot I_{ytotr}}$$

$$\Delta_{yr2} = 0.361 \quad \text{in}$$

$$M_{yrmax2} := \frac{P \cdot L}{K_2}$$

$$M_{yrmax2} = 2880 \quad \text{lb-in}$$

$$f_{bry2} := \frac{M_{yrmax2}}{S_{yr}}$$

$$f_{bry2} = 8834 \quad \text{psi}$$

$$F_{bry} := \begin{cases} (F_{bry1} \cdot 1.33) & \text{if IBC} = 1 \\ F_{bry1} & \text{otherwise} \end{cases}$$

$$F_{bry} = 25000 \quad \text{psi}$$

Calculation Results:

$$Int_r1 := \left(\frac{f_{brx1}}{F_{bry}} \right) + \left(\frac{f_{bry1}}{F_{bry}} \right)$$

$$Int_r1 = 0.33$$

$$Int_r2 := \frac{f_{bry2}}{F_{bry}}$$

$$Int_r2 = 0.35$$

$$RAILS := \begin{cases} \text{"OK"} & \text{if } \frac{\max(\Delta_{yr1}, \Delta_{xr1}, \Delta_{yr2})}{\Delta_{allr}} \leq 1 \wedge \left(\frac{f_{brx1}}{F_{bry}} \right) + \left(\frac{f_{bry1}}{F_{bry}} \right) \leq 1 \wedge \frac{f_{bry2}}{F_{bry}} \leq 1 \\ \text{"FAIL"} & \text{otherwise} \end{cases}$$

RAILS = "OK"

RICE ENGINEERING Template: REI-MC-5707	105 School Creek Trail Luxemburg, WI 54217 Phone: (920)845-1042 Fax: (920)845-1048 www.rice-inc.com	Project Description:	Job No: R11-10-240
		RMR 80KD System	Engineer: JDB
			Sheet No: CI A
			Date: 10/24/11
		Rev:	Rev:
		Chk By:	Date:

Post Analysis:

$E_p := E_r$

Guardrail "C" Analysis	SHT C1 B
------------------------	-------------

$$\Delta_{xp1} := \frac{W_h \cdot L \cdot (h - L_{st})^3}{3 \cdot E_p \cdot (I_{xp})}$$

$\Delta_{xp1} = 0.701$ in

$$\Delta_{xp2} := \frac{P \cdot 0.85 \cdot (h - L_{st})^3}{3 \cdot E_p \cdot (I_{xp})}$$

$\Delta_{xp2} = 0.397$ in

Max Deflection:

$$\Delta_{tot} := \frac{W_h \cdot L \cdot (h - L_{st})^3}{3 \cdot E_p \cdot I_{xp}} + \frac{W_h \cdot L \cdot [h^3 - (h - L_{st})^3]}{3 \cdot [(E_p \cdot I_{xp}) + (E_p \cdot I_{st})]}$$

$\Delta_{tot} = 1.995$ in

$$\Delta_{allp} := \frac{h}{12}$$

$\Delta_{allp} = 3.67$ in Per ASTM E985

Case 1 - Uniform Load:

$$M_{xp} := (W_h \cdot L \cdot h) + W_v \cdot L \cdot \Delta_{tot}$$

$$M_{xpmax} := 0.5 \cdot M_{xp} \cdot q1 + M_{xp} \cdot q2 + M_{xp} \cdot q3$$

$M_{xpmax} = 13200$ lb-in

$$M_{xp2} := W_h \cdot L \cdot (h - L_{st}) + W_v \cdot L \cdot \Delta_{xp1}$$

$$M_{xpmax2} := 0.5 \cdot M_{xp2} \cdot q1 + M_{xp2} \cdot q2 + M_{xp2} \cdot q3$$

$M_{xpmax2} = 8400$ lb-in

Case 2 - Point Load:

$$M_{xpmax4} := P \cdot (h - L_{st}) \cdot 0.85$$

$M_{xpmax4} = 4760$ lb-in

$$M_{xpmax3} := (P \cdot h \cdot 0.85)$$

$M_{xpmax3} = 7480$ lb-in

Max Post Stress:

$$f_{bpx} := \frac{\max(M_{xpmax2}, M_{xpmax4})}{S_{xp}}$$

$f_{bpx} = 25767$ psi

$$F_{bpx} := \begin{cases} (F_{bpx1} \cdot 1.33) & \text{if } IBC = 1 \\ F_{bpx1} & \text{otherwise} \end{cases}$$

$F_{bpx} = 25000$ psi

Max Post/Stub Combined Stress:

$$f_{bpx2} := \max(M_{xpmax}, M_{xpmax3}) \cdot \frac{I_{xp}}{(I_{xp} + I_{st}) \cdot S_{xp}}$$

$f_{bpx2} = 25934$ psi

$F_{bpx} = 25000$ psi

Max Stub Stress:

$$f_{bst} := \max(M_{xpmax}, M_{xpmax3}) \cdot \frac{I_{st}}{(I_{xp} + I_{st}) \cdot S_{st}}$$

$f_{bst} = 21185$ psi

$F_{bst} = 25000$ psi

Calculation Results:

$$Int_{p1} := \max\left(\frac{f_{bpx}}{F_{bpx}}, \frac{f_{bpx2}}{F_{bpx}}, \frac{f_{bst}}{F_{bst}}\right)$$


$Int_{p1} = 1.04$ 4% Over OK

$$POSTS := \begin{cases} \text{"OK"} & \text{if } Int_{p1} \leq 1.04 \wedge \frac{\max(\Delta_{xp1}, \Delta_{xp2}, \Delta_{tot})}{\Delta_{allp}} \leq 1 \\ \text{"FAIL"} & \text{otherwise} \end{cases}$$

$POSTS = \text{"OK"}$

RICE ENGINEERING Template: REL-MC-5707	105 School Creek Trail Luxemburg, WI 54217 Phone: (920)845-1042 Fax: (920)845-1048 www.rice-inc.com	Project Description:	Job No: R11-10-240
		RMR 80KD System	Engineer: JDB Sheet No: C1 B
			Date: 10/24/11 Rev:
			Chk By: Date:

Side Mount Anchorage	SHT C2
-------------------------	-----------

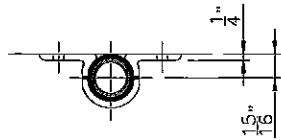


$$R_{max} := 300 \quad \text{lb}$$

$$M_{max} := 13200 + R_{max} \cdot 3 = 14100 \quad \text{lb-in}$$

$$L1 := 6 \quad \text{in}$$

$$L2 := 5.25 \quad \text{in}$$

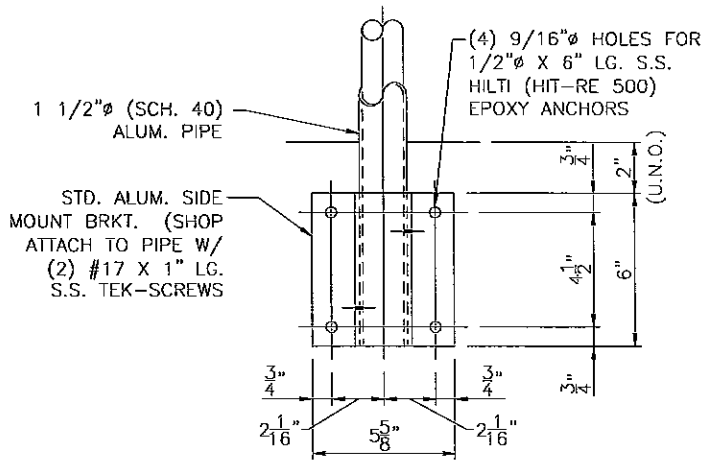

Chk Extruded Aluminum Bracket:

$$P := \frac{M_{max}}{L1} + R_{max} \quad P = 2650 \quad \text{lb}$$

$$M_{pl} := \frac{P}{2} \cdot 0.688 \quad M_{pl} = 912 \quad \text{in-lb}$$

$$t_{req} := \sqrt{\frac{6 \cdot M_{pl}}{28000 \cdot L1}} \quad t_{req} = 0.18 \quad \text{in}$$

$$I := \frac{t_{req}}{0.25} \quad I = 0.72$$

CONC. SIDE MOUNT 4-HOLE

80KD-18A

Use Side Mount Bracket, As Shown
6105-T5 alloy

Chk Anchor Bolts: (Assume $f_c = 4000$ psi Conc.)

$$V_b := \frac{R_{max}}{2} \cdot 1.6 \quad V_b = 240 \quad \text{lb}$$

$$T_b := \left(\frac{M_{max}}{L2 \cdot 1.085} + \frac{R_{max}}{2} \right) \cdot 1.6 \quad T_b = 5295 \quad \text{lb}$$

Chk TEK Screws:

$$V := \frac{R_{max}}{(2)} \quad V = 150 \quad \text{lb}$$

$$V_{all} := 2148 \cdot 0.333 \quad V_{all} = 715 \quad \text{lb}$$

See Next Sheet for Calculation

$$I_2 := \left(\frac{V}{V_{all}} \right) \quad I_2 = 0.21 < 1.0$$

Use (4) - 1/2" Dia. S.S. Threaded Rods
With Hilti HIT-RE 500 SD Epoxy Adhesive
Embedment = 4-1/2"
Edge = 2-3/4"
End = 5-1/8"

Use (2) - #17 S.S. TEK Screws
300 Series S.S.
ITW Buildex or Better


RICE ENGINEERING Template:	105 School Creek Trail Luxemburg, WI 54217 Phone: (920)845-1042 Fax: (920)845-1048 www.rice-inc.com	Project Description: RMR 80KD System	Job No: R11-10-240	
			Engineer: JDB	Sheet No: C2
			Date: 10/24/11	Rev:
			Chk By:	Date:

Company:
 Specifier:
 Address:
 Phone | Fax: - | -
 E-Mail:

Page: 1
 Project:
 Sub-Project | Pos. No.:
 Date: 10/25/2011

Specifier's comments:
Input data

Anchor type and diameter: HIT-RE 500-SD + HAS-R 304/316, 1/2
Effective embedment depth: $h_{ef,act} = 4.500$ in. ($h_{ef,limit} = -$ in.)
Material: ASTM F 593
Evaluation Service Report:: ESR 2322
Issued | Valid: 4/1/2010 | -
Proof: design method ACI 318 / AC308
Stand-off installation: $e_o = 0.000$ in. (no stand-off); $t = 0.500$ in.
Anchor plate: $l_x \times l_y \times t = 3.000 \times 6.000 \times 0.500$ in. (Recommended plate thickness: not calculated)
Profile: no profile
Base material: uncracked concrete, 4000, $f'_c = 4000$ psi; $h = 8.000$ in., Temp. short/long: 32/32°F
Installation: hammer drilled hole, installation condition: dry
Reinforcement: tension: condition B, shear: condition B; no supplemental splitting reinforcement present
 edge reinforcement: none or < No. 4 bar
 Seismic loads (cat. C, D, E, or F): no

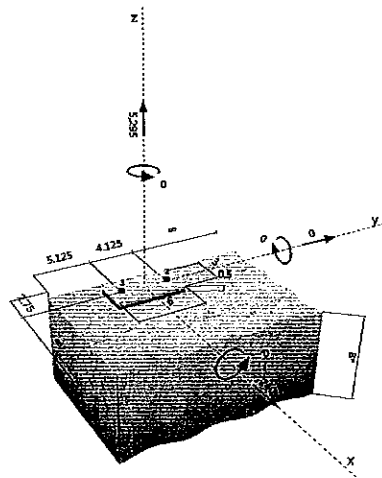Geometry [in.] & Loading [lb, in.-lb]

Proof I Utilization (Governing Cases)


Loading	Proof	Design values [lb]		Utilization [%]	Status
		Load	Capacity	β_N/β_V	
Tension	Concrete Breakout Strength	5295	5331	99 / -	OK
Shear	Concrete edge failure in direction x-	240	6362	- / 4	OK
Loading	β_N	β_V	ζ	Utilization $\beta_{N,V}$ [%]	Status
Combined tension and shear loads	0.993	0.038	-	86	OK

Warnings

• Please consider all details and hints/warnings given in the detailed report!

Fastening meets the design criteria!

Corner Side Mount Anchorage	SHT C4
--------------------------------	-----------

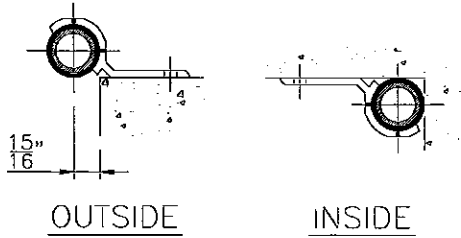

$R_{max} := 97$ lb *Reactions from RISA Model*
 $M_{max} := 0$ lb-in *(Corner Post Modeled as a Pin Connection)*
 $L1 := 6$ in
 $L2 := 5.25$ in


Chk Extruded Aluminum Bracket:

$$P := \frac{M_{max}}{L1} + R_{max} \quad P = 97 \quad \text{lb}$$

$$M_{pl} := \frac{P}{2} \cdot 0.688 \quad M_{pl} = 33 \quad \text{in-lb}$$

$$t_{req} := \sqrt{\frac{6 \cdot M_{pl}}{28000 \cdot L1}} \quad t_{req} = 0.03 \quad \text{in}$$

$$I := \frac{t_{req}}{0.25} \quad I = 0.14$$

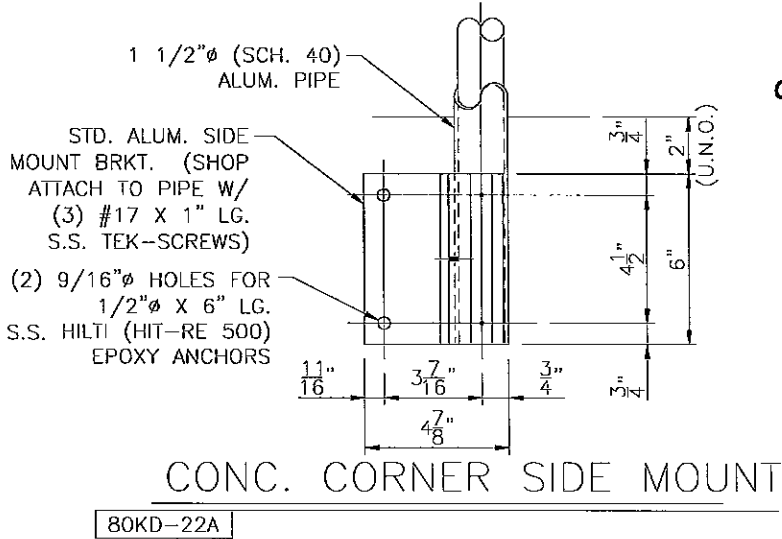

Use Side Mount Bracket, As Shown
6105-T5 alloy

Chk Anchor Bolts: (Assume $f_c = 4000$ psi Conc.)

$$V_b := \frac{R_{max}}{1} \cdot 1.6 \quad V_b = 155 \quad \text{lb}$$

$$T_b := \frac{R_{max}}{1} \cdot 1.6 \quad T_b = 155 \quad \text{lb}$$

Chk TEK Screws:

$$V := \frac{R_{max}}{(3)} \quad V = 32 \quad \text{lb}$$

$$V_{all} := 2148 \cdot 0.333 \quad V_{all} = 715 \quad \text{lb}$$

$$T := \frac{M_{max}}{L2} + \frac{R_{max}}{(2)} \quad T = 49 \quad \text{lb}$$

$$T_{all} := 2065 \cdot 0.33 \quad T_{all} = 681 \quad \text{lb}$$



$$I_2 := \left(\frac{V}{V_{all}} \right)^2 + \left(\frac{T}{T_{all}} \right)^2 \quad I_2 = 0.01 < 1.0$$

See Next Sheet for Calculation

Use (2) - 1/2" Dia. S.S. Threaded Rods
W/ Hilti HIT-RE 500 SD Epoxy Adhesive
 Embedment= 4-1/2" min.
 Edge Distance= 2-3/4" min.
 End Distance = 2-1/2"

Use (3) - #17 S.S. TEK Screws
 300 Series S.S.
 ITW Buildex or Better

RICE ENGINEERING Template:	105 School Creek Trail Luxemburg, WI 54217 Phone: (920)845-1042 Fax: (920)845-1048 www.rice-inc.com	Project Description: RMR 80KD System	Job No: R11-10-240	
			Engineer: JDB	Sheet No: C4
			Date: 10/24/11	Rev:
			Chk By:	Date:

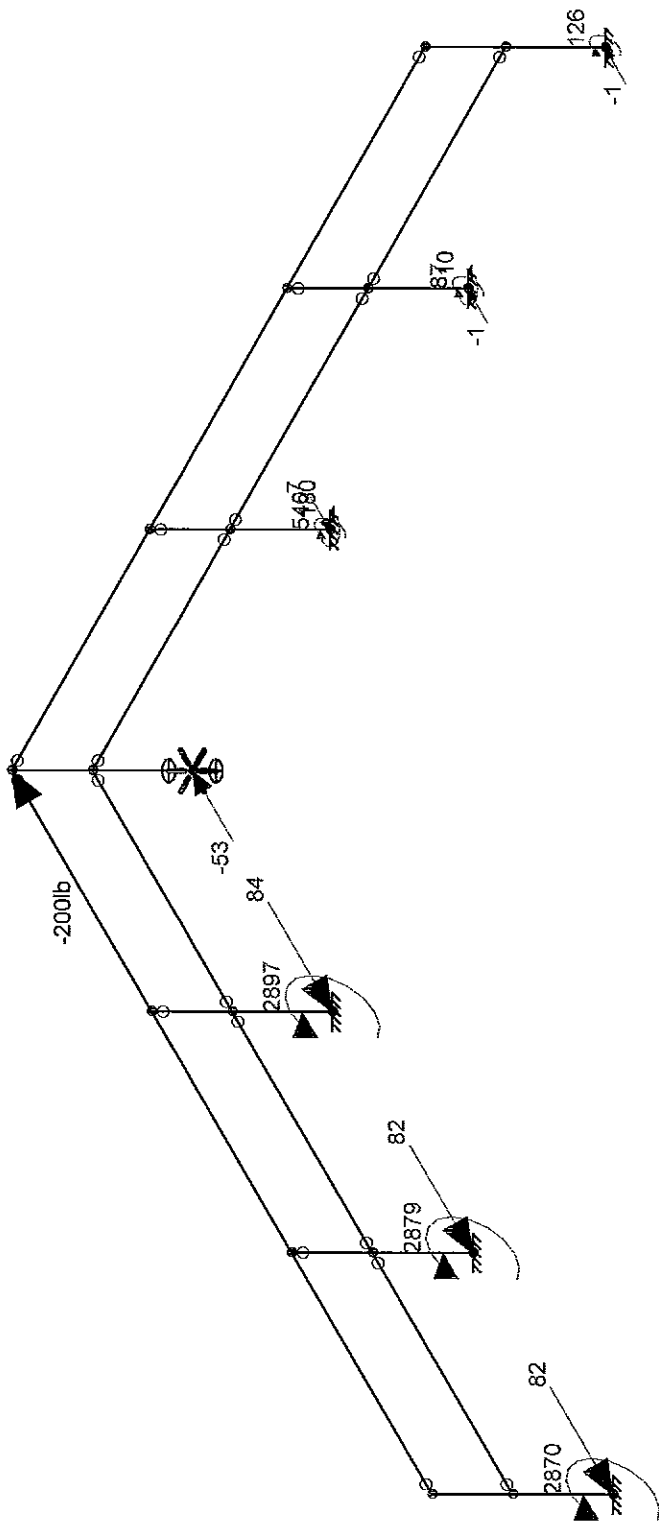
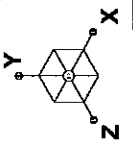


Loads: BLC 2,
 Results for LC 2, Point
 Z-moment Reaction units are lb and lb-in

Rice Engineering
 Joe Bauer

SK - 4
 Feb 23, 2011 at 4:51 PM
 Corner Brackets.r3d

CH.1

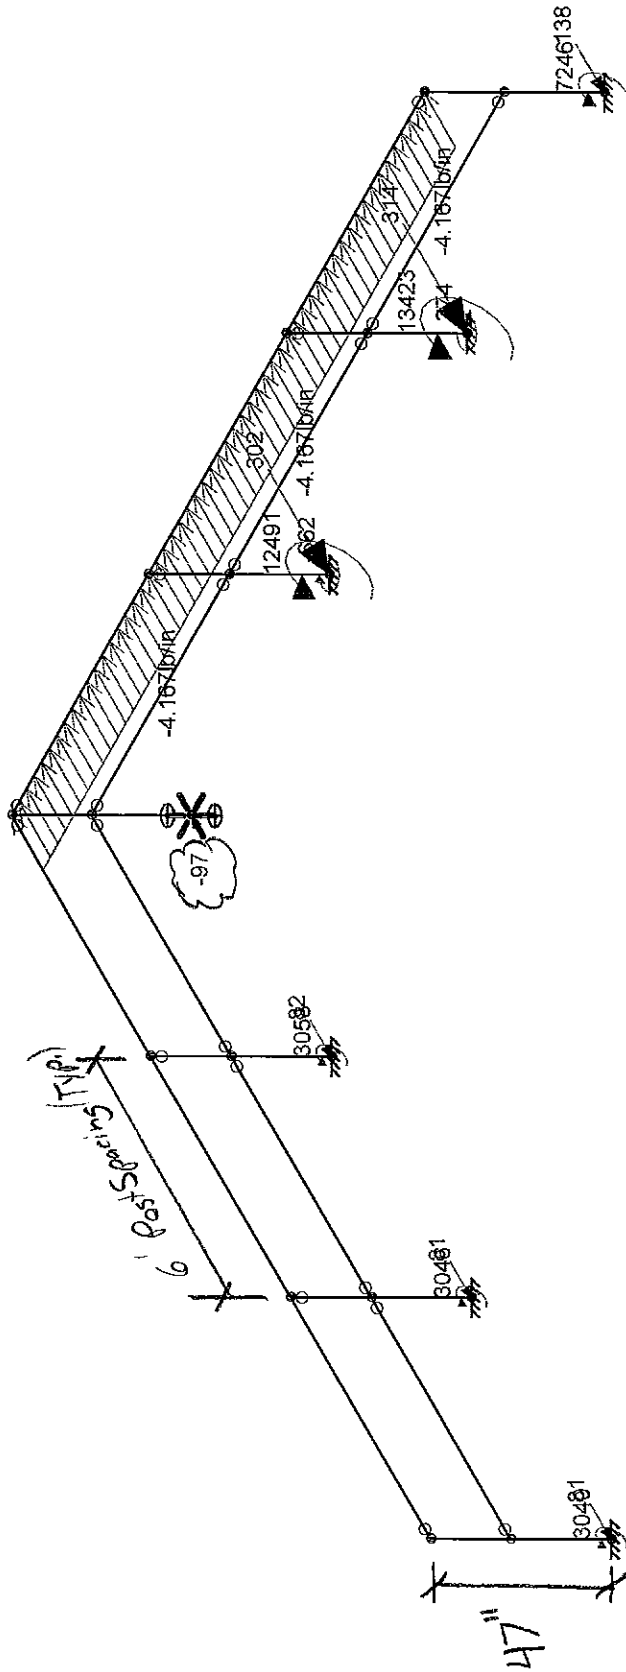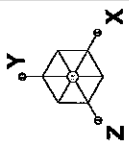

Loads: BLC 1,
 Results for LC 1, Dist 1
 Z-moment Reaction units are lb and lb-in

Rice Engineering

Joe Bauer

SK - 5

Feb 23, 2011 at 4:51 PM


Corner Brackets.r3d

Company:
 Specifier:
 Address:
 Phone | Fax: - | -
 E-Mail:

Page: 1
 Project:
 Sub-Project | Pos. No.:
 Date: 10/25/2011

Specifier's comments:
Input data

Anchor type and diameter: HIT-RE 500-SD + HAS-R 304/316, 1/2
Effective embedment depth: $h_{e,eff} = 2.810$ in. ($h_{e,limit} = 6.750$ in.)
Material: ASTM F 593
Evaluation Service Report: ESR 2322
Issued | Valid: 4/1/2010 | -
Proof: design method ACI 318 / AC308
Stand-off installation: $e_o = 0.000$ in. (no stand-off); $t = 0.500$ in.
Anchor plate: $l_x \times l_y \times t = 3.000 \times 7.000 \times 0.500$ in. (Recommended plate thickness: not calculated)
Profile: no profile
Base material: uncracked concrete, 4000, $f_c' = 4000$ psi; $h = 8.000$ in., Temp. short/long: 32/32°F
Installation: hammer drilled hole, installation condition: dry
Reinforcement: tension: condition B, shear: condition B; no supplemental splitting reinforcement present
 edge reinforcement: none or < No. 4 bar
Seismic loads (cat. C, D, E, or F): no

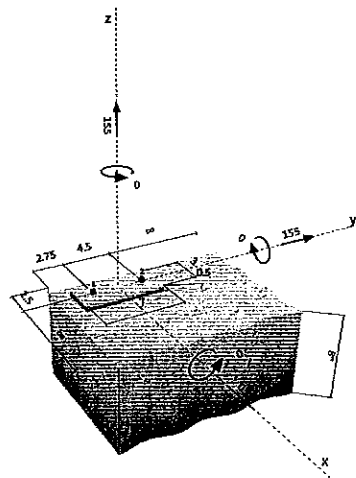Geometry [in.] & Loading [lb, in.-lb]

Proof | Utilization (Governing Cases)

Loading	Proof	Design values [lb]		Utilization [%]	
		Load	Capacity	β_N / β_V	Status
Tension	Concrete Breakout Strength	155	4152	4 / -	OK
Shear	Concrete edge failure in direction y-	155	3174	- / 5	OK
Loading	β_N	β_V	ζ	Utilization $\beta_{N,V}$ [%]	Status
Combined tension and shear loads	0.037	0.049	5/3	1	OK


Warnings

- Please consider all details and hints/warnings given in the detailed report!

Fastening meets the design criteria!

C5

Side Mount Anchor (Bottom of Stairs)	SHT C6
---	-----------

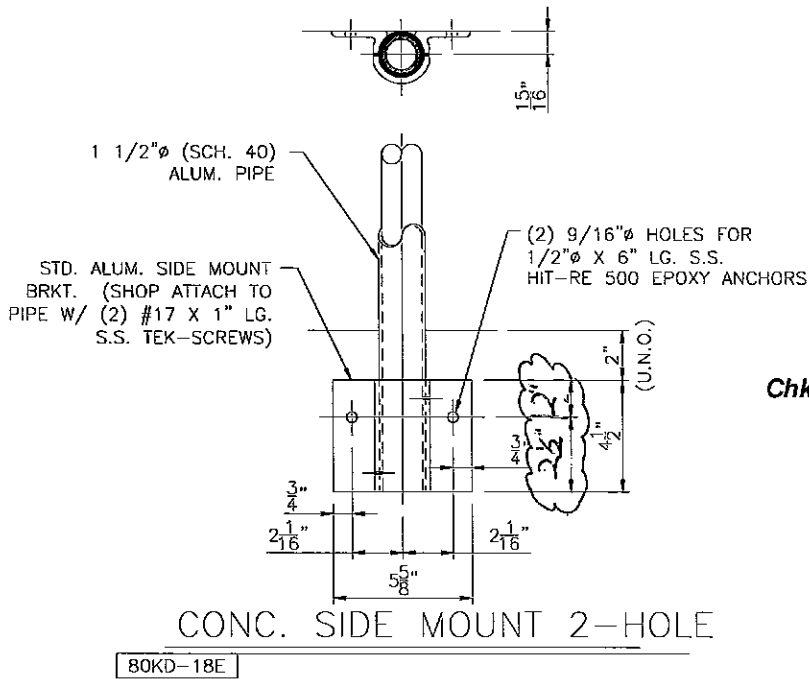

$$R_{max} := 200 \quad \text{lb}$$

$$M_{max} := R_{max} \cdot 42.068 = 8414 \quad \text{lb-in}$$

$$L1 := 4.5 \quad \text{in}$$

$$L2 := 2.5 \quad \text{in}$$

Chk Extruded Aluminum Bracket:

$$P := \frac{M_{max}}{L1} + R_{max} \quad P = 2070 \quad \text{lb}$$

$$M_{pl} := \frac{P}{2} \cdot 0.688 \quad M_{pl} = 712 \quad \text{in-lb}$$

$$t_{req} := \sqrt{\frac{6 \cdot M_{pl}}{28000 \cdot L1}} \quad t_{req} = 0.18 \quad \text{in}$$

$$I := \frac{t_{req}}{0.25} \quad I = 0.74$$

Chk Anchor Bolts: (Assume $f_c = 4000$ psi Conc.)

Uniform Load

$$V_b := \frac{R_{max}}{1} \cdot 1.6 \quad V_b = 320 \quad \text{lb}$$

$$T_b := \left(\frac{M_{max}}{L2 \cdot 1.085} + \frac{R_{max}}{1} \right) \cdot 1.6 \quad T_b = 6655 \quad \text{lb}$$

Concentrated Load

$$V_{b2} := \frac{200 \cdot 0.85}{1} \cdot 1.6 \quad V_{b2} = 272 \quad \text{lb}$$

$$T_{b2} := \left(\frac{200 \cdot 0.85 \cdot 42.068}{2 \cdot 1.085} + \frac{200 \cdot 0.85}{1} \right) \cdot 1.6 \quad T_{b2} = 7003 \quad \text{lb}$$

See Next Sheet for Calculation

Use (4) - 1/2" Dia. S.S. Threaded Rods
With Hilti HIT-RE 500 SD Epoxy Adhesive
 Embedment = 4-1/2"
 Edge = 3-1/2"
 End = 3"

Use Side Mount Bracket, As Shown
 6105-T5 alloy

Chk TEK Screws:

$$V := \frac{R_{max}}{(2)} \quad V = 100 \quad \text{lb}$$

$$V_{all} := 2148 \cdot 0.333 \quad V_{all} = 715 \quad \text{lb}$$

$$I_2 := \left(\frac{V}{V_{all}} \right) \quad I_2 = 0.14 < 1.0$$

Use (2) - #17 S.S. TEK Screws
 300 Series S.S.
 ITW Buildex or Better


RICE ENGINEERING Template:	105 School Creek Trail Luxemburg, WI 54217 Phone: (920)845-1042 Fax: (920)845-1048 www.rice-inc.com	Project Description: RMR 80KD System	Job No: R11-10-240
			Engineer: JDB Sheet No: C6
			Date: 10/24/11 Rev:
			Chk By: Date:

Company:
 Specifier:
 Address:
 Phone | Fax: - | -
 E-Mail:

Page: 1
 Project:
 Sub-Project | Pos. No.:
 Date: 10/25/2011

Specifier's comments:
Input data

Anchor type and diameter: HIT-RE 500-SD + HAS-R 304/316, 1/2
Effective embedment depth: $h_{e,act} = 4.500$ in. ($h_{e,limit} = -$ in.)
Material: ASTM F 593
Evaluation Service Report:: ESR 2322
Issued | Valid: 4/1/2010 | -
Proof: design method ACI 318 / AC308
Stand-off installation: $e_b = 0.000$ in. (no stand-off); $t = 0.500$ in.
Anchor plate: $l_x \times l_y \times t = 3.000 \times 6.000 \times 0.500$ in. (Recommended plate thickness: not calculated)
Profile: no profile
Base material: uncracked concrete, 4000, $f'_c = 4000$ psi; $h = 24.000$ in., Temp. short/long: 32/32°F
Installation: hammer drilled hole, installation condition: dry
Reinforcement: tension: condition B, shear: condition B; no supplemental splitting reinforcement present
 edge reinforcement: none or < No. 4 bar
 Seismic loads (cat. C, D, E, or F): no

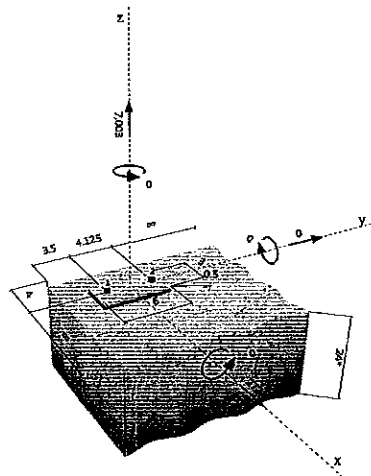Geometry [in.] & Loading [lb, in.-lb]


3% Over OK


Proof I Utilization (Governing Cases)

Loading	Proof	Design values [lb]		Utilization [%]	Status
		Load	Capacity		
Tension	Concrete Breakout Strength	7003	6832	103 / -	not recommended
Shear	Concrete edge failure in direction y-	272	5365	- / 5	OK

Loading	β_N	β_V	ζ	Utilization $\beta_{N,V}$ [%]	Status
Combined tension and shear loads	1.025	0.051	-	-	OK

Warnings

- Please consider all details and hints/warnings given in the detailed report!

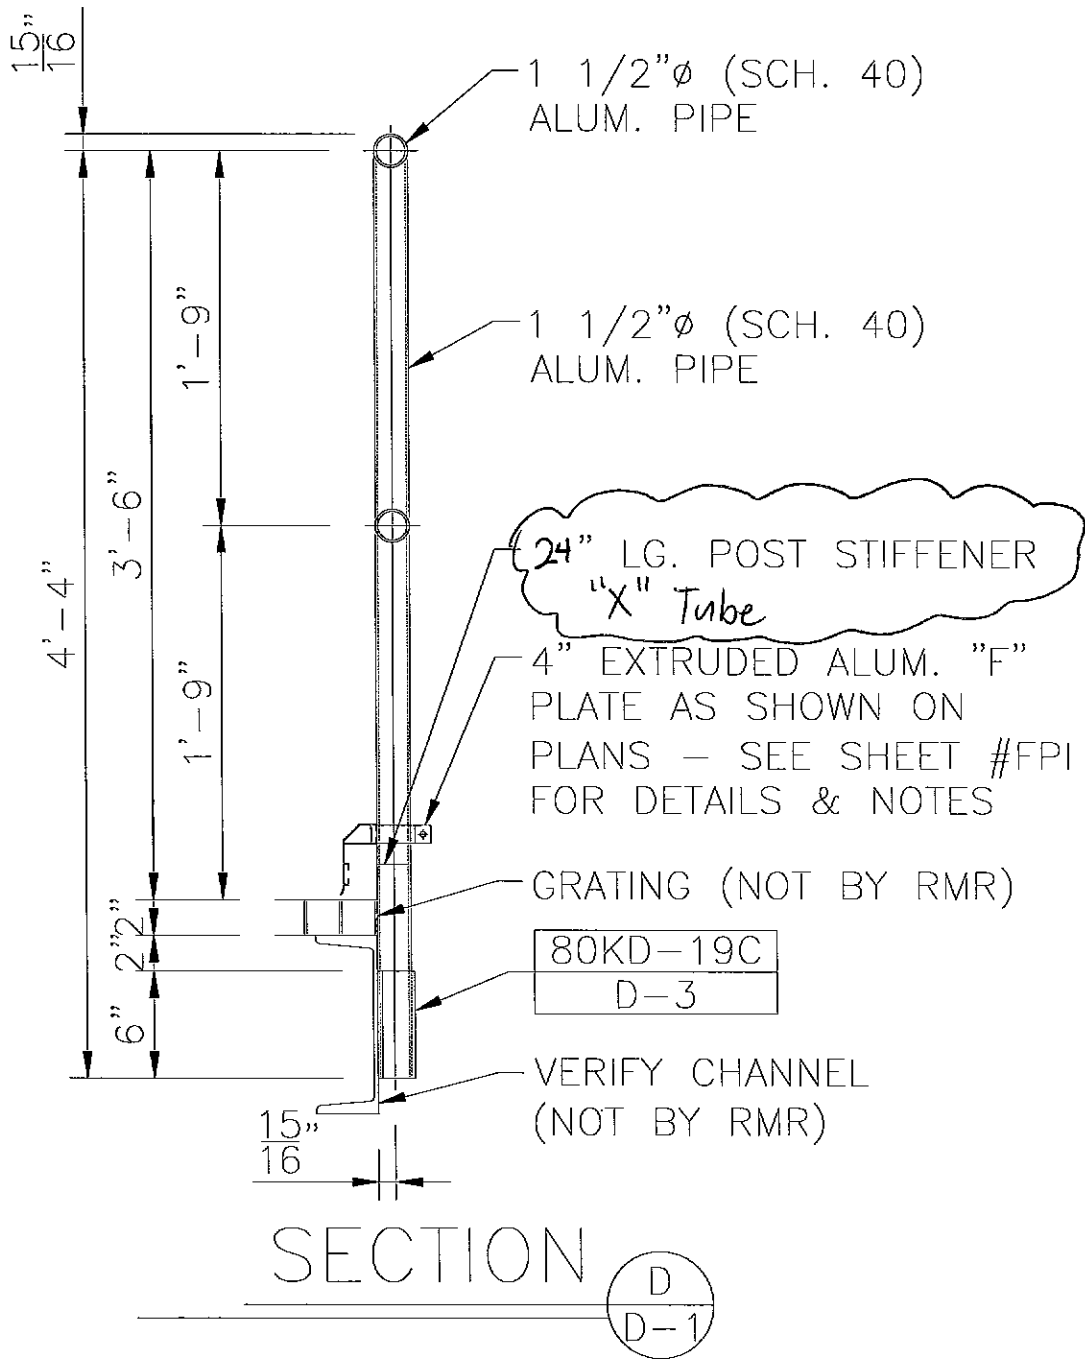

Note: Structural steel, Concrete, CMU and all other anchorage substrates designed by others



ROCKY MOUNTAIN RAILINGS

RICE ENGINEERING Template: REI-MC-5707	105 School Creek Trail Luxemburg, WI 54217 Phone: (920)845-1042 Fax: (920)845-1048 www.rice-inc.com	Project Description: RMR 80KD System	Job No: R11-10-240
			Engineer: JDB Sheet No: D
			Date: 10/24/11 Rev:
			Chk By: Date:

Pipe Railing & Post

These calculations are based on empirical test data performed by Julius Blum & Co., Inc.

Guardrail "D" Analysis	SHT D1
------------------------	-----------

Input Variables:

- $F_H := 50$ plf Load Case 1 (Uniform Load)
- $F_V := 0$ plf Simultaneous Vertical Uniform Load
- $P := 200$ lb Load Case 2 (Point Load)
- $L_{bp} := 25$ in Unbraced Length of Post
- $h := 46$ in Railing Height Above Anchor Bracket
- $L := 72$ in **6'-0" MAX POST SPACING**

Number of Railing Spans:

- 1 span
- 2 span
- 3 or more spans

Railing Section:

- 1 1/4" Schd. 40
- 1 1/4" Schd. 80
- 1 1/2" Schd. 40
- 1 1/2" Schd. 80
- 1 1/2" tube
- 2" Schd. 40
- 2" Schd. 80

Railing Temper:


- 6063-T5
- 6063-T6
- 6061-T6 or 6105-T5
- 4/3 increase allowed

Post Section:

- 1 1/4" Schd. 40
- 1 1/4" Schd. 80
- 1 1/2" Schd. 40
- 1 1/2" Schd. 80
- 1 1/2" tube
- 2" Schd. 40
- 2" Schd. 80

Post Temper:

- 6063-T6
- 6005-T5
- 6061-T6 or 6105-T5
- Post Welded to Base Plate

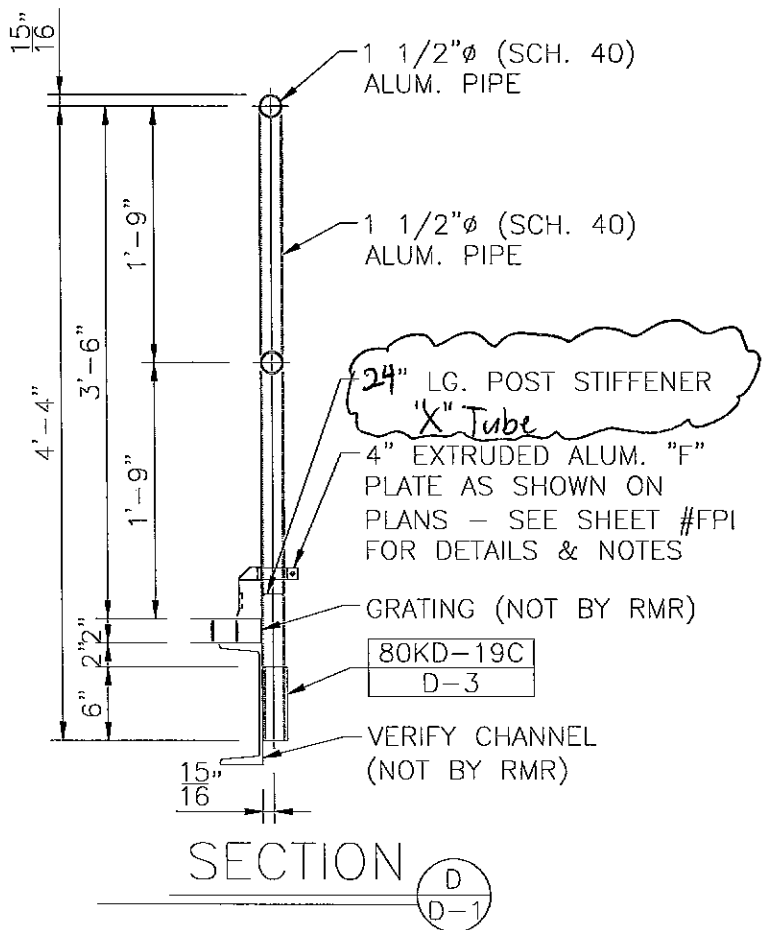

All calculations below this line are automatic

Railing Properties

$I_{xr} =$	0.31
$I_{yr} =$	0.31
$S_{xr} =$	0.326
$S_{yr} =$	0.326
$R =$	0.95
$t =$	0.145

$E_r := 10100000$ psi

Post Properties

$I_{xp} =$	0.31
$I_{yp} =$	0.31
$S_{xp} =$	0.326
$S_{yp} =$	0.326
$R =$	0.95
$t =$	0.145

$I_{xtotr} := I_{xr}$	$I_{xtotr} = 0.31$ in ⁴	$I_{xtotp} := I_{xp}$	$I_{xtotp} = 0.31$ in ⁴
$I_{ytotr} := I_{yr}$	$I_{ytotr} = 0.31$ in ⁴	$I_{ytop} := I_{yp}$	$I_{ytop} = 0.31$ in ⁴

Computational Factors

$$S_{R1} := \frac{R_r}{t_r} \quad S_{R1} = 6.55 \quad K_1 := (8 \cdot q_1) + (8 \cdot q_2) + (9.5 \cdot q_3) \quad K_1 = 8$$

$$S_{R3} := \frac{R_p}{t_p} \quad S_{R3} = 6.55 \quad K_2 := (4 \cdot q_1) + (5 \cdot q_2) + (5 \cdot q_3) \quad K_2 = 5$$

$$K_3 := (48 \cdot q_1) + (66 \cdot q_2) + (87 \cdot q_3) \quad K_3 = 66$$

24" Min. Length AL. "X" Tube Stub

$$I_{st} := 0.249 \text{ in}^4 \quad L_{st} := 18 \text{ in}$$

$$S_{st} := 0.311 \text{ in}^3 \quad F_{bst} := 25000 \text{ psi}$$

RICE ENGINEERING Template: REL-MC-5707	105 School Creek Trail Luxemburg, WI 54217 Phone: (920)845-1042 Fax: (920)845-1048 www.rice-inc.com	Project Description:		Job No:	R11-10-240		
		RMR 80KD System		Engineer:	JDB	Sheet No:	D1
				Date:	10/24/11	Rev:	
				Chk By:		Date:	

Railing Analysis:

$$W_h := \frac{F_H}{12}$$

$$W_v := \frac{F_V}{12}$$

Guardrail "D" Analysis	SHT D1 A
------------------------	-------------

Case 1 Uniform Load:

$$\Delta_{yr1} := \frac{5 \cdot W_h \cdot L^4}{384 \cdot E_r \cdot I_{ytotr}}$$

$\Delta_{yr1} = 0.466$ in Modeled as a simple span

$$\Delta_{xr1} := \frac{5 \cdot W_v \cdot L^4}{384 \cdot E_r \cdot I_{xtotr}}$$

$\Delta_{xr1} = 0$ in

$$\Delta_{allr} := \frac{L}{96}$$

$\Delta_{allr} = 0.75$ in Per ASTM Specification E985

$$M_{yrmax} := \frac{W_h \cdot L^2}{K_1}$$

$M_{yrmax} = 2700$ lb-in

$$M_{xrmax} := \frac{W_v \cdot L^2}{K_1}$$

$M_{xrmax} = 0$ lb-in



$$f_{bry1} := \frac{M_{yrmax}}{S_{yr}}$$

$f_{bry1} = 8282$ psi

$$f_{brx1} := \frac{M_{xrmax}}{S_{xr}}$$

$f_{brx1} = 0$ psi

Case 2 - Point Load:

$$\Delta_{yr2} := \frac{P \cdot L^3}{K_3 \cdot E_r \cdot I_{ytotr}}$$

$\Delta_{yr2} = 0.361$ in

$$M_{yrmax2} := \frac{P \cdot L}{K_2}$$

$M_{yrmax2} = 2880$ lb-in

$$f_{bry2} := \frac{M_{yrmax2}}{S_{yr}}$$

$f_{bry2} = 8834$ psi

$$F_{bry} := \begin{cases} (F_{bry1} \cdot 1.33) & \text{if IBC} = 1 \\ F_{bry1} & \text{otherwise} \end{cases}$$

$F_{bry} = 25000$ psi

Calculation Results:

$$Int_{r1} := \left(\frac{f_{brx1}}{F_{bry}} \right) + \left(\frac{f_{bry1}}{F_{bry}} \right)$$

$Int_{r1} = 0.33$

$$Int_{r2} := \frac{f_{bry2}}{F_{bry}}$$

$Int_{r2} = 0.35$

$$RAILS := \begin{cases} \text{"OK"} & \text{if } \frac{\max(\Delta_{yr1}, \Delta_{xr1}, \Delta_{yr2})}{\Delta_{allr}} \leq 1 \wedge \left(\frac{f_{brx1}}{F_{bry}} \right) + \left(\frac{f_{bry1}}{F_{bry}} \right) \leq 1 \wedge \frac{f_{bry2}}{F_{bry}} \leq 1 \\ \text{"FAIL"} & \text{otherwise} \end{cases}$$

RAILS = "OK"

RICE ENGINEERING Template: REI-MC-5707	105 School Creek Trail Luxemburg, WI 54217 Phone: (920)845-1042 Fax: (920)845-1048 www.rice-inc.com	Project Description:	Job No: R11-10-240
		RMR 80KD System	Engineer: JDB
			Sheet No: D1 A
			Date: 10/24/11
		Rev:	Rev:
		Chk By:	Date:

Post Analysis:

$E_p := E_r$

Guardrail "D" Analysis	SHT
	D1 B

$$\Delta_{xp1} := \frac{W_h \cdot L \cdot (h - L_{st})^3}{3 \cdot E_p \cdot (I_{xp})}$$

$\Delta_{xp1} = 0.701$ in

$$\Delta_{xp2} := \frac{P \cdot 0.85 \cdot (h - L_{st})^3}{3 \cdot E_p \cdot (I_{xp})}$$

$\Delta_{xp2} = 0.397$ in

Max Deflection:

$$\Delta_{tot} := \frac{W_h \cdot L \cdot (h - L_{st})^3}{3 \cdot E_p \cdot I_{xp}} + \frac{W_h \cdot L \cdot [h^3 - (h - L_{st})^3]}{3 \cdot [(E_p \cdot I_{xp}) + (E_p \cdot I_{st})]}$$

$\Delta_{tot} = 2.036$ in

$$\Delta_{allp} := \frac{h}{12}$$

$\Delta_{allp} = 3.83$ in Per ASTM E985

Case 1 - Uniform Load:

$$M_{xp} := (W_h \cdot L \cdot h) + W_v \cdot L \cdot \Delta_{tot}$$

$$M_{xpmax} := 0.5 \cdot M_{xp} \cdot q1 + M_{xp} \cdot q2 + M_{xp} \cdot q3$$

$M_{xpmax} = 13800$ lb-in

$$M_{xp2} := W_h \cdot L \cdot (h - L_{st}) + W_v \cdot L \cdot \Delta_{xp1}$$

$$M_{xpmax2} := 0.5 \cdot M_{xp2} \cdot q1 + M_{xp2} \cdot q2 + M_{xp2} \cdot q3$$

$M_{xpmax2} = 8400$ lb-in

Case 2 - Point Load:

$$M_{xpmax4} := P \cdot (h - L_{st}) \cdot 0.85$$

$M_{xpmax4} = 4760$ lb-in

$$M_{xpmax3} := (P \cdot h \cdot 0.85)$$

$M_{xpmax3} = 7820$ lb-in

Max Post Stress:

$$f_{bpx} := \frac{\max(M_{xpmax2}, M_{xpmax4})}{S_{xp}}$$

$f_{bpx} = 25767$ psi

$$F_{bpx} := \begin{cases} (F_{bpx1} \cdot 1.33) & \text{if IBC} = 1 \\ F_{bpx1} & \text{otherwise} \end{cases}$$

$F_{bpx} = 25000$ psi

Max Post/Stub Combined Stress:

$$f_{bpx2} := \max(M_{xpmax}, M_{xpmax3}) \cdot \frac{I_{xp}}{(I_{xp} + I_{st}) \cdot S_{xp}}$$

$f_{bpx2} = 23475$ psi

$F_{bpx} = 25000$ psi

Max Stub Stress:

$$f_{bst} := \max(M_{xpmax}, M_{xpmax3}) \cdot \frac{I_{st}}{(I_{xp} + I_{st}) \cdot S_{st}}$$

$f_{bst} = 19765$ psi

$F_{bst} = 25000$ psi

Calculation Results:


$$Int_{p1} := \max\left(\frac{f_{bpx}}{F_{bpx}}, \frac{f_{bpx2}}{F_{bpx}}, \frac{f_{bst}}{F_{bst}}\right)$$

$Int_{p1} = 1.03$ 3% Over OK

$$POSTS := \begin{cases} \text{"OK"} & \text{if } Int_{p1} \leq 1.034 \wedge \frac{\max(\Delta_{xp1}, \Delta_{xp2}, \Delta_{tot})}{\Delta_{allp}} \leq 1 \\ \text{"FAIL"} & \text{otherwise} \end{cases}$$

$POSTS = \text{"OK"}$

RICE ENGINEERING Template: REI-MC-5707	105 School Creek Trail Luxemburg, WI 54217 Phone: (920)845-1042 Fax: (920)845-1048 www.rice-inc.com	Project Description: RMR 80KD System	Job No: R11-10-240 Engineer: JDB Date: 10/24/11 Chk By:	Sheet No: D1 B Rev: Date:
--	---	---	--	---------------------------------

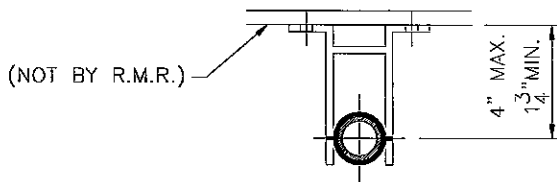


Side Mount Anchorage	SHT D3
----------------------	--------

$$R_{max} := 300 \text{ lb}$$

$$M_{max} := R_{max} \cdot 39 = 11700 \text{ lb-in}$$

$$L1 := 4 \text{ in}$$

$$L2 := 2 \text{ in}$$

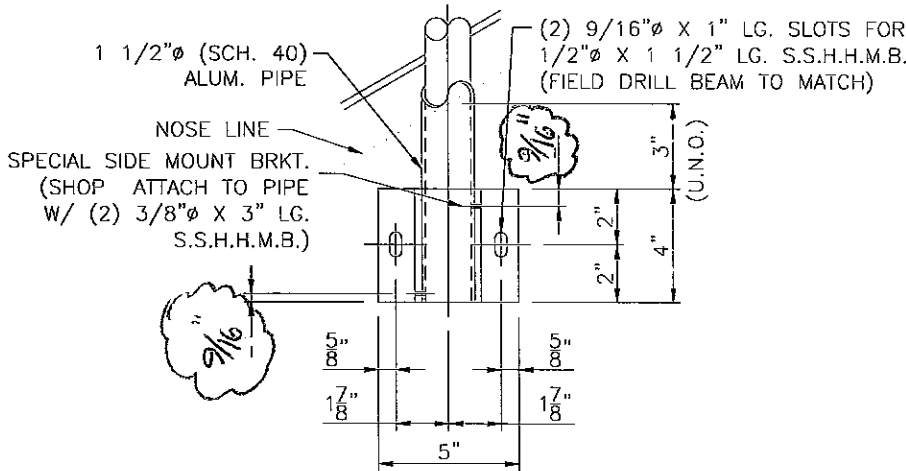

Use Halfen Slip Resistant Flange Nuts or Equal

SPECIAL SIDE MOUNT 2-HOLE

80KD-19E

Chk Post Attachment to Bracket:

$$V := \frac{M_{max}}{2.875 \cdot (1)} + \frac{R_{max}}{(2)} \quad V = 4220 \text{ lb}$$

$$V_{all} := 0.110 \cdot 23000 \cdot (2) \quad V_{all} = 5060 \text{ lb}$$

Use (2) - 3/8" Dia. S.S. Thru-Bolts @ 2-7/8" O.C. 300 Series S.S.

Chk Extruded Aluminum Bracket:

$$P := \frac{M_{max}}{L1} + R_{max} \quad P = 3225 \text{ lb}$$

$$M_{pl} := \frac{P}{2} \cdot 0.7 \quad M_{pl} = 1129 \text{ in-lb}$$

$$t_{req} := \sqrt{\frac{6 \cdot M_{pl}}{28000 \cdot L1}} \quad t_{req} = 0.25 \text{ in}$$

$$I := \frac{t_{req}}{0.25} \quad I = 0.98$$

Use Side Mount Bracket, 4" Long 6105-T5 alloy

Chk Anchor Bolts:

$$V_b := \frac{R_{max}}{2} \quad V_b = 150 \text{ lb}$$

$$T_b := \frac{M_{max}}{L2 \cdot 2} + \frac{R_{max}}{2} \quad T_b = 3075 \text{ lb}$$


$$V_{all} := 0.196 \cdot 23000 \quad V_{all} = 4508 \text{ lb}$$

$$T_{all} := 0.142 \cdot 40000 \cdot \frac{0.25}{0.456} \quad T_{all} = 3114 \text{ lb}$$

$$I := \left(\frac{V_b}{V_{all}} \right)^2 + \left(\frac{T_b}{T_{all}} \right)^2 \quad I = 0.98 < 1.0$$

Use (4) - 1/2" Dia. S.S. Thru Bolts (or Drill & Tap - 1/4" Min. Thread Engagement) Cond "CW", Fy= 65 ksi minimum Steel Stringers Designed By Others

RICE ENGINEERING Template: REL-MC-5741	105 School Creek Trail Luxemburg, WI 54217 Phone: (920)845-1042 Fax: (920)845-1048 www.rice-inc.com	Project Description: R0001 - RMR Standard Calcs	Job No: R11-02-15H	
			Engineer: JDB	Sheet No: D3
			Date: 2/23/11	Rev:
			Chk By:	Date:

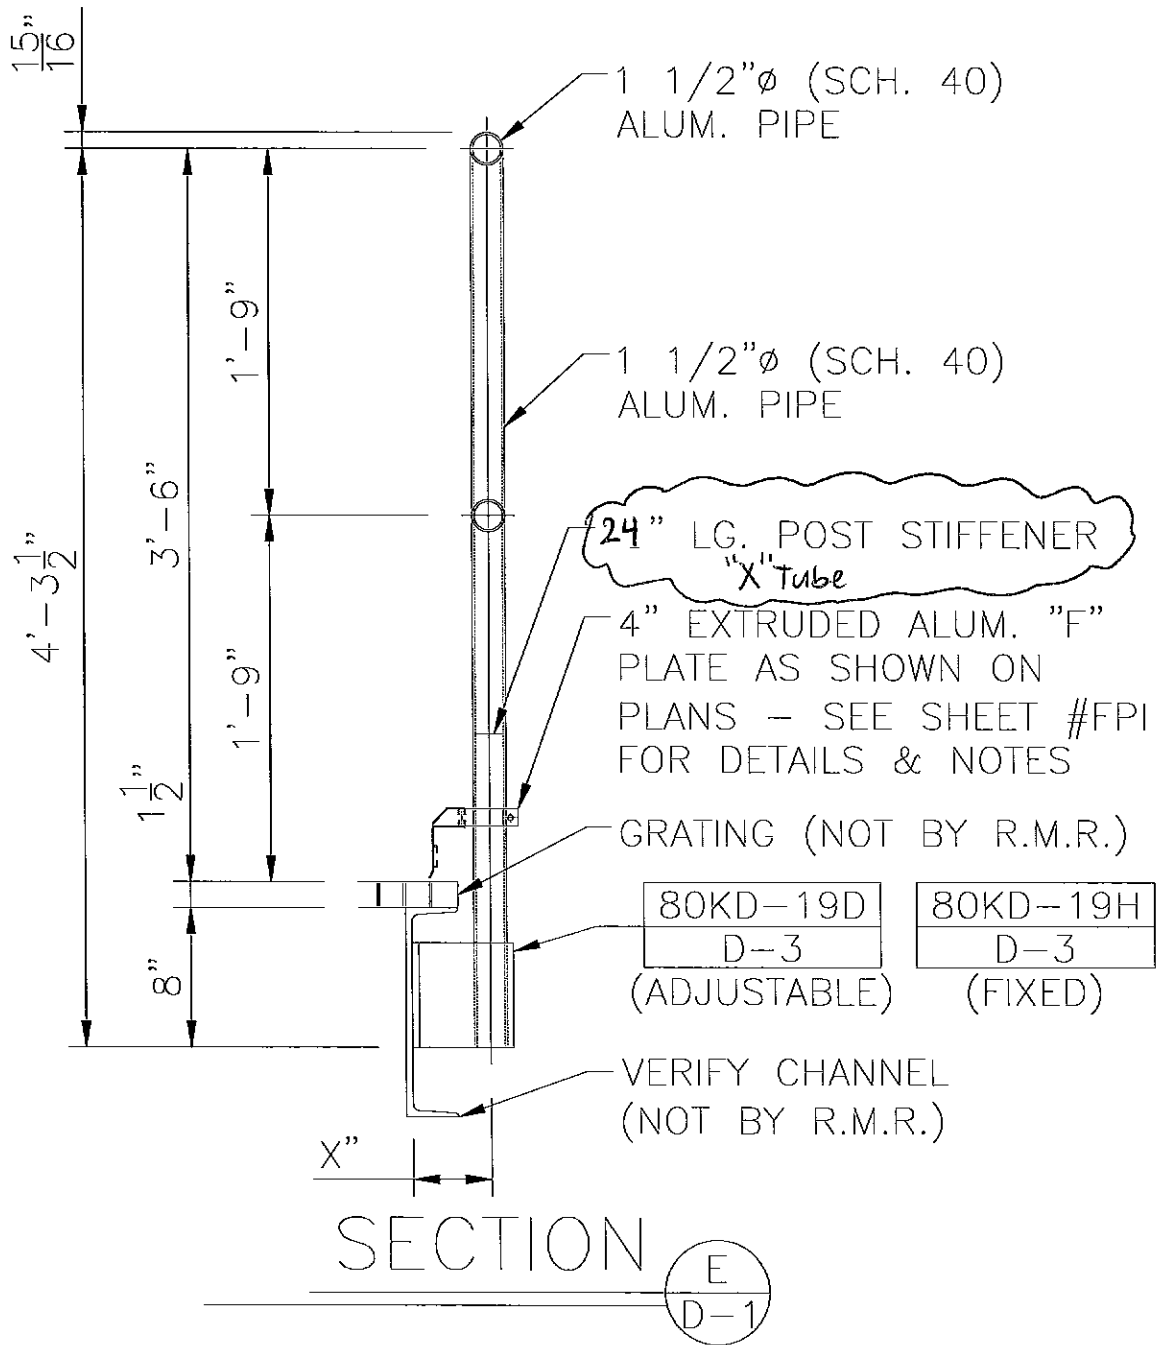

Note: Structural steel, Concrete, CMU and all other anchorage substrates designed by others



ROCKY MOUNTAIN RAILINGS

RICE ENGINEERING Template: REL-MC-5707	105 School Creek Trail Luxemburg, WI 54217 Phone: (920)845-1042 Fax: (920)845-1048 www.rice-inc.com	Project Description: RMR 80KD System	Job No: R11-10-240	
			Engineer: JDB	Sheet No: E
			Date: 10/24/11	Rev:
			Chk By:	Date:

Pipe Railing & Post

These calculations are based on empirical test data performed by Julius Blum & Co., Inc.

Guardrail "E" Analysis	SHT E1
------------------------	-----------

Input Variables:

$F_H := 50$	plf	Load Case 1 (Uniform Load)
$F_V := 0$	plf	Simultaneous Vertical Uniform Load
$P := 200$	lb	Load Case 2 (Point Load)
$L_{bp} := 24.5$	in	Unbraced Length of Post
$h := 46.5$	in	Railing Height Above Top Anchor Bolt
$L := 72$	in	6'-0" MAX POST SPACING

Number of Railing Spans:

1 span	<input checked="" type="checkbox"/>
2 span	<input checked="" type="checkbox"/>
3 or more spans	<input checked="" type="checkbox"/>

Railing Section:

<input type="checkbox"/> 1 1/4" Schd. 40
<input type="checkbox"/> 1 1/4" Schd. 80
<input checked="" type="checkbox"/> 1 1/2" Schd. 40
<input type="checkbox"/> 1 1/2" Schd. 80
<input type="checkbox"/> 1 1/2" tube
<input type="checkbox"/> 2" Schd. 40
<input type="checkbox"/> 2" Schd. 80

Post Section:


<input type="checkbox"/> 1 1/4" Schd. 40
<input type="checkbox"/> 1 1/4" Schd. 80
<input checked="" type="checkbox"/> 1 1/2" Schd. 40
<input type="checkbox"/> 1 1/2" Schd. 80
<input type="checkbox"/> 1 1/2" tube
<input type="checkbox"/> 2" Schd. 40
<input type="checkbox"/> 2" Schd. 80

Railing Temper:

<input type="checkbox"/> 6063-T5
<input type="checkbox"/> 6063-T6
<input checked="" type="checkbox"/> 6061-T6 or 6105-T5
<input type="checkbox"/> 4/3 increase allowed

Post Temper:

<input type="checkbox"/> 6063-T6
<input type="checkbox"/> 6005-T5
<input checked="" type="checkbox"/> 6061-T6 or 6105-T5
<input type="checkbox"/> Post Welded to Base Plate

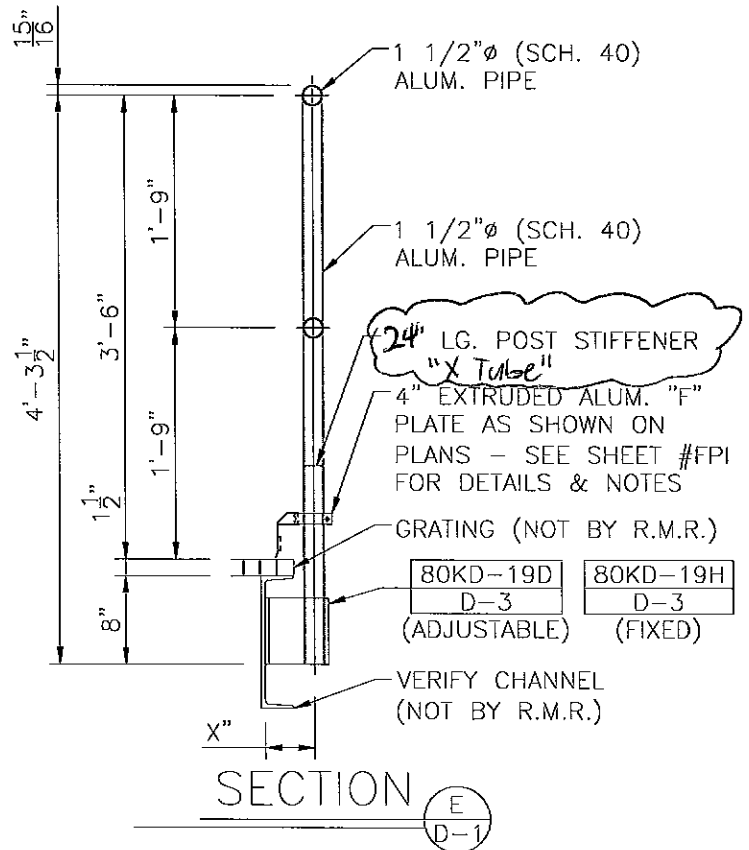

All calculations below this line are automatic

Railing Properties

$k_r =$	0.31
$l_r =$	0.31
$S_{x_r} =$	0.326
$S_{y_r} =$	0.326
$R =$	0.95
$t =$	0.145

Post Properties

$k_r =$	0.31
$l_r =$	0.31
$S_{x_r} =$	0.326
$S_{y_r} =$	0.326
$R =$	0.95
$t =$	0.145

Computational Factors

$S_{R1} := \frac{R_r}{l_r}$	$S_{R1} = 6.55$	$K_1 := (8 \cdot q_1) + (8 \cdot q_2) + (9.5 \cdot q_3)$	$K_1 = 8$
$S_{R3} := \frac{R_p}{l_p}$	$S_{R3} = 6.55$	$K_2 := (4 \cdot q_1) + (5 \cdot q_2) + (5 \cdot q_3)$	$K_2 = 5$
		$K_3 := (48 \cdot q_1) + (66 \cdot q_2) + (87 \cdot q_3)$	$K_3 = 66$

$E_r := 10100000$ psi

$I_{xtot} := I_{xr}$	$I_{xtot} = 0.31$ in ⁴	$I_{xtot} := I_{xp}$	$I_{xtot} = 0.31$ in ⁴
$I_{ytot} := I_{yr}$	$I_{ytot} = 0.31$ in ⁴	$I_{ytot} := I_{yp}$	$I_{ytot} = 0.31$ in ⁴

24" Min. Length AL. "X" Tube Stub

$I_{st} := 0.249$	in ⁴	$L_{st} := 19$	in
$S_{st} := 0.311$	in ³	$F_{bst} := 25000$	psi

RICE ENGINEERING Template: REL-MC-5707	105 School Creek Trail Luxemburg, WI 54217 Phone: (920)845-1042 Fax: (920)845-1048 www.rice-inc.com	Project Description: RMR 80KD System	Job No: R11-10-240
			Engineer: JDB Sheet No: E1
			Date: 10/24/11 Rev:
			Chk By: Date:

Railing Analysis:

$$W_h := \frac{F_H}{12} \quad W_v := \frac{F_v}{12}$$

Guardrail "E" Analysis	SHT E1 A
------------------------	-------------

Case 1 Uniform Load:

$$\Delta_{yr1} := \frac{5 \cdot W_h \cdot L^4}{384 \cdot E_r \cdot I_{ytotr}} \quad \Delta_{yr1} = 0.466 \quad \text{in} \quad \text{Modeled as a simple span}$$

$$\Delta_{xr1} := \frac{5 \cdot W_v \cdot L^4}{384 \cdot E_r \cdot I_{xtotr}} \quad \Delta_{xr1} = 0 \quad \text{in}$$

$$\Delta_{allr} := \frac{L}{96} \quad \Delta_{allr} = 0.75 \quad \text{in} \quad \text{Per ASTM Specification E985}$$

$$M_{yrmax} := \frac{W_h \cdot L^2}{K_1} \quad M_{yrmax} = 2700 \quad \text{lb-in}$$

$$M_{xrmax} := \frac{W_v \cdot L^2}{K_1} \quad M_{xrmax} = 0 \quad \text{lb-in}$$



$$f_{bry1} := \frac{M_{yrmax}}{S_{yr}} \quad f_{bry1} = 8282 \quad \text{psi}$$

$$f_{brx1} := \frac{M_{xrmax}}{S_{xr}} \quad f_{brx1} = 0 \quad \text{psi}$$

Case 2 - Point Load:

$$\Delta_{yr2} := \frac{P \cdot L^3}{K_3 \cdot E_r \cdot I_{ytotr}} \quad \Delta_{yr2} = 0.361 \quad \text{in}$$

$$M_{yrmax2} := \frac{P \cdot L}{K_2} \quad M_{yrmax2} = 2880 \quad \text{lb-in}$$

$$f_{bry2} := \frac{M_{yrmax2}}{S_{yr}} \quad f_{bry2} = 8834 \quad \text{psi}$$

$$F_{bry} := \begin{cases} (f_{bry1} \cdot 1.33) & \text{if IBC} = 1 \\ f_{bry1} & \text{otherwise} \end{cases} \quad F_{bry} = 25000 \quad \text{psi}$$

Calculation Results:

$$Int_{r1} := \left(\frac{f_{brx1}}{F_{bry}} \right) + \left(\frac{f_{bry1}}{F_{bry}} \right) \quad Int_{r1} = 0.33$$

$$Int_{r2} := \frac{f_{bry2}}{F_{bry}} \quad Int_{r2} = 0.35$$

$$RAILS := \begin{cases} \text{"OK"} & \text{if } \frac{\max(\Delta_{yr1}, \Delta_{xr1}, \Delta_{yr2})}{\Delta_{allr}} \leq 1 \wedge \left(\frac{f_{brx1}}{F_{bry}} \right) + \left(\frac{f_{bry1}}{F_{bry}} \right) \leq 1 \wedge \frac{f_{bry2}}{F_{bry}} \leq 1 \\ \text{"FAIL"} & \text{otherwise} \end{cases} \quad RAILS = \text{"OK"}$$

RICE ENGINEERING Template: REI-MC-5707	105 School Creek Trail Luxemburg, WI 54217 Phone: (920)845-1042 Fax: (920)845-1048 www.rice-inc.com	Project Description:	Job No: R11-10-240
		RMR 80KD System	Engineer: JDB Sheet No: E1 A
			Date: 10/24/11 Rev:
			Chk By: Date:

Post Analysis:

$E_p := E_r$

Guardrail "E" Analysis	SHT E1 B
------------------------	-------------

$$\Delta_{xp1} := \frac{W_h \cdot L \cdot (h - L_{st})^3}{3 \cdot E_p \cdot (I_{xp})}$$

$\Delta_{xp1} = 0.664$ in

$$\Delta_{xp2} := \frac{P \cdot 0.85 \cdot (h - L_{st})^3}{3 \cdot E_p \cdot (I_{xp})}$$

$\Delta_{xp2} = 0.376$ in

Max Deflection:

$$\Delta_{tot} := \frac{W_h \cdot L \cdot (h - L_{st})^3}{3 \cdot E_p \cdot I_{xp}} + \frac{W_h \cdot L \cdot [h^3 - (h - L_{st})^3]}{3 \cdot [(E_p \cdot I_{xp}) + (E_p \cdot I_{st})]}$$

$\Delta_{tot} = 2.077$ in

$$\Delta_{allp} := \frac{h}{12}$$

$\Delta_{allp} = 3.88$ in Per ASTM E985

Case 1 - Uniform Load:

$$M_{xp} := (W_h \cdot L \cdot h) + W_v \cdot L \cdot \Delta_{tot}$$

$$M_{xpmmax} := 0.5 \cdot M_{xp} \cdot q1 + M_{xp} \cdot q2 + M_{xp} \cdot q3$$

$M_{xpmmax} = 13950$ lb-in

$$M_{xp2} := W_h \cdot L \cdot (h - L_{st}) + W_v \cdot L \cdot \Delta_{xp1}$$

$$M_{xpmmax2} := 0.5 \cdot M_{xp2} \cdot q1 + M_{xp2} \cdot q2 + M_{xp2} \cdot q3$$

$M_{xpmmax2} = 8250$ lb-in

Case 2 - Point Load:

$$M_{xpmmax4} := P \cdot (h - L_{st}) \cdot 0.85$$

$M_{xpmmax4} = 4675$ lb-in

$$M_{xpmmax3} := (P \cdot h \cdot 0.85)$$

$M_{xpmmax3} = 7905$ lb-in

Max Post Stress:

$$f_{bpx} := \frac{\max(M_{xpmmax2}, M_{xpmmax4})}{S_{xp}}$$

$f_{bpx} = 25307$ psi

$$F_{bpx} := \begin{cases} (F_{bpx1} \cdot 1.33) & \text{if IBC} = 1 \\ F_{bpx1} & \text{otherwise} \end{cases}$$

$F_{bpx} = 25000$ psi

Max Post/Stub Combined Stress:

$$f_{bpx2} := \max(M_{xpmmax}, M_{xpmmax3}) \cdot \frac{I_{xp}}{(I_{xp} + I_{st}) \cdot S_{xp}}$$

$f_{bpx2} = 23730$ psi

$F_{bpx} = 25000$ psi

Max Stub Stress:

$$f_{bst} := \max(M_{xpmmax}, M_{xpmmax3}) \cdot \frac{I_{st}}{(I_{xp} + I_{st}) \cdot S_{st}}$$

$f_{bst} = 19980$ psi

$F_{bst} = 25000$ psi

Calculation Results:



$$Int_{p1} := \max\left(\frac{f_{bpx}}{F_{bpx}}, \frac{f_{bpx2}}{F_{bpx}}, \frac{f_{bst}}{F_{bst}}\right)$$

$Int_{p1} = 1.01$ 5% Over OK

$$POSTS := \begin{cases} \text{"OK"} & \text{if } Int_{p1} \leq 1.014 \wedge \frac{\max(\Delta_{xp1}, \Delta_{xp2}, \Delta_{tot})}{\Delta_{allp}} \leq 1 \\ \text{"FAIL"} & \text{otherwise} \end{cases}$$

$POSTS = \text{"OK"}$

RICE ENGINEERING Template: REI-MC-5707	105 School Creek Trail Luxemburg, WI 54217 Phone: (920)845-1042 Fax: (920)845-1048 www.rice-inc.com	Project Description:	Job No: R11-10-240
		RMR 80KD System	Engineer: JDB Sheet No: E1 B
			Date: 10/24/11 Rev:
			Chk By: Date:

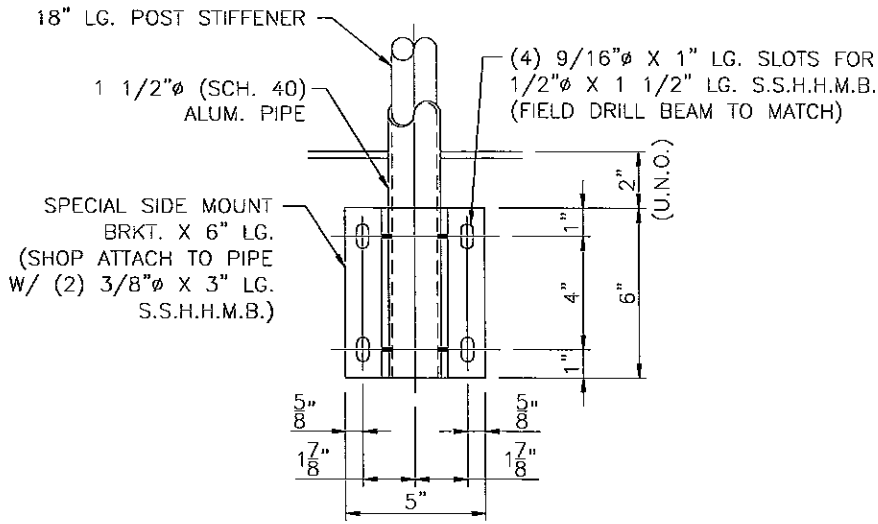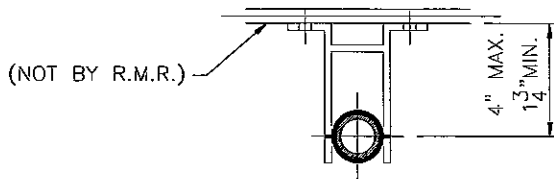

SPECIAL SIDE MOUNT 4-HOLE

80KD-19D

Side Mount Anchorage	SHT E2
----------------------	--------

$R_{max} := 300 \text{ lb}$

$M_{max} := 13950 + R_{max} \cdot 3 = 14850 \text{ lb}\cdot\text{in}$

$L1 := 6 \text{ in}$

$L2 := 5 \text{ in}$

Use Halfen Slip Resistant Flange Nuts or Equal

Chk Post Attachment to Bracket:

$V := \frac{M_{max}}{4 \cdot (1)} + \frac{R_{max}}{(2)} \quad V = 3863 \text{ lb}$

$V_{all} := 0.110 \cdot 23000 \cdot (2) \quad V_{all} = 5060 \text{ lb}$

Use (2) - 3/8" Dia. S.S. Thru-Bolts @ 4" O.C. 300 Series S.S.

Chk Extruded Aluminum Bracket:

$P := \frac{M_{max}}{L1} + R_{max} \quad P = 2775 \text{ lb}$

$M_{pl} := \frac{P}{2} \cdot 0.8125 \quad M_{pl} = 1127 \text{ in}\cdot\text{lb}$

$t_{req} := \sqrt{\frac{6 \cdot M_{pl}}{28000 \cdot L1}} \quad t_{req} = 0.2 \text{ in}$

$I := \frac{t_{req}}{0.25} \quad I = 0.8$

Use Side Mount Bracket, As Shown 6105-T5 alloy

Chk Anchor Bolts:

$V_b := \frac{R_{max}}{4} \quad V_b = 75 \text{ lb}$

$T_b := \frac{M_{max}}{L2 \cdot 2} + \frac{R_{max}}{4} \quad T_b = 1560 \text{ lb}$

$V_{all} := 0.196 \cdot 23000 \quad V_{all} = 4508 \text{ lb}$

$T_{all} := 0.142 \cdot 40000 \cdot \frac{0.1875}{0.456} \quad T_{all} = 2336 \text{ lb}$

$I := \left(\frac{V_b}{V_{all}} \right)^2 + \left(\frac{T_b}{T_{all}} \right)^2 \quad I = 0.45 < 1.0$

Use (4) - 1/2" Dia. S.S. Thru Bolts (or Drill & Tap - 3/16" Min. Thread Engagement) Cond "CW", Fy= 65 ksi minimum Steel Stringers Designed By Others

RICE ENGINEERING Template: REI-MC-5741	105 School Creek Trail Luxemburg, WI 54217 Phone: (920)845-1042 Fax: (920)845-1048 www.rice-inc.com	Project Description: RMR 80KD System	Job No: R11-10-240
			Engineer: JDB Sheet No: E2
			Date: 10/24/11 Rev:
			Chk By: Date:

Reactions:

$R_{max} := 300 \text{ lb}$ $L1 := 5 \text{ in}$

$M_{max} := 13950 + R_{max} \cdot 3 = 14850 \text{ lb-in}$ $L2 := 4 \text{ in}$

Side Mount Anchor	SHT E3
-------------------	-----------

Chk Extruded Aluminum Bracket:

$P := \frac{M_{max}}{L1} + R_{max}$ $P = 3270 \text{ lb}$

$M_{pl} := \frac{P \cdot 3}{4}$ $M_{pl} = 2453 \text{ in-lb}$

$t_{req} := \sqrt{\frac{6 \cdot M_{pl}}{28000 \cdot 0.85 \cdot L1}}$ $t_{req} = 0.35 \text{ in}$

$I := \frac{t_{req}}{0.375}$ $I = 0.94$

**Use Extruded Bracket as shown
(6105-T5)**

Chk Anchor Bolts (Structural Steel By Others):

$V_b := \frac{R_{max}}{4}$ $V_b = 75 \text{ lb}$

$T_b := \frac{M_{max}}{L2 \cdot 2} + \frac{R_{max}}{4}$ $T_b = 1931 \text{ lb}$

$V_{all} := 0.196 \cdot 23000$ $V_{all} = 4508 \text{ lb}$

$T_{all} := 0.142 \cdot 40000 \cdot \frac{0.1875}{0.456}$ $T_{all} = 2336 \text{ lb}$


$I := \left(\frac{V_b}{V_{all}}\right)^2 + \left(\frac{T_b}{T_{all}}\right)^2$ $I = 0.68 < 1.0$

**Use (4) - 1/2-13 S.S. Bolts
Drill & Tap or Thru-Bolt
Min. Thread Engagement = 3/16"
(300 Series S.S., Cond. CW, Fy = 65 ksi)**

Chk Fasteners:

$V := \frac{R_{max}}{2}$ $V = 150 \text{ lb}$ (upward)


**Use (2) - 3/8" Dia. S.S. Set Screws
OK By Inspection**

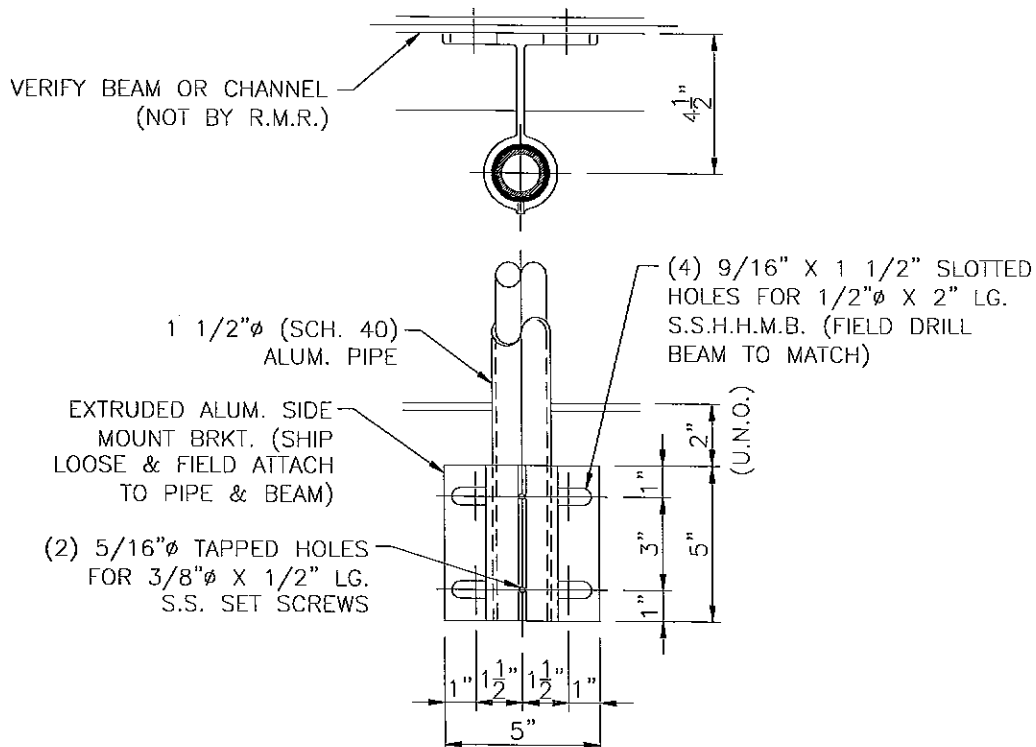

STL. SIDE MOUNT 4-SLOT

80KD-19H

RICE ENGINEERING Template:	105 School Creek Trail Luxemburg, WI 54217 Phone: (920)845-1042 Fax: (920)845-1048 www.rice-inc.com	Project Description: RMR 80KD System	Job No: R11-10-240 Engineer: JDB Date: 10/24/11 Chk By:	Sheet No: E3 Rev: Date:
---	---	--	--	-------------------------------

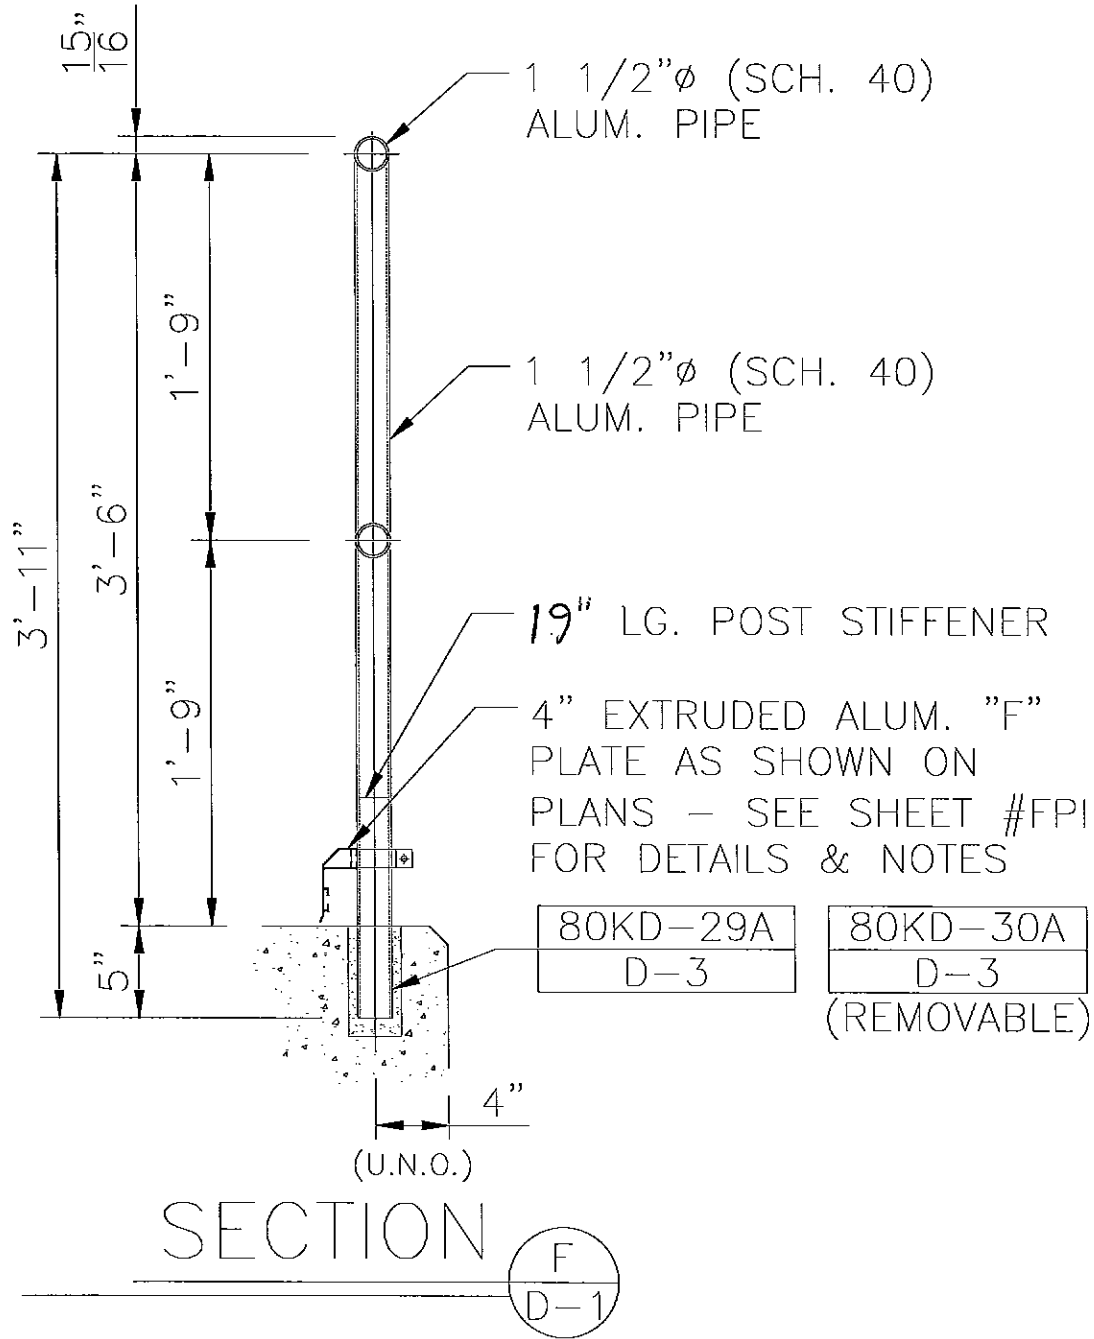

Note: Structural steel, Concrete, CMU and all other anchorage substrates designed by others



ROCKY MOUNTAIN RAILINGS

RICE ENGINEERING Template: REI-MC-5707	105 School Creek Trail Luxemburg, WI 54217 Phone: (920)845-1042 Fax: (920)845-1048 www.rice-inc.com	Project Description: RMR 80KD System	Job No: R11-10-240	
			Engineer: JDB	Sheet No: F
			Date: 10/24/11	Rev:
			Chk By:	Date:

Pipe Railing & Post

These calculations are based on empirical test data performed by Julius Blum & Co., Inc.

Guardrail "F" Analysis

SHT
F1

Input Variables:

$F_H := 50$ plf Load Case 1 (Uniform Load)
 $F_V := 0$ plf Simultaneous Vertical Uniform Load
 $P := 200$ lb Load Case 2 (Point Load)
 $L_{bp} := 21$ in Unbraced Length of Post
 $h := 42$ in Railing Height Above Anchor Bracket
 $L := 72$ in **6'-0" MAX POST SPACING**

Number of Railing Spans:

1 span
 2 span
 3 or more spans

Railing Section:

1 1/4" Schd. 40
 1 1/4" Schd. 80
 1 1/2" Schd. 40
 1 1/2" Schd. 80
 1 1/2" tube
 2" Schd. 40
 2" Schd. 80

Railing Temper:


6063-T5
 6063-T6
 6061-T6 or 6105-T5
 4/3 increase allowed

Post Section:

1 1/4" Schd. 40
 1 1/4" Schd. 80
 1 1/2" Schd. 40
 1 1/2" Schd. 80
 1 1/2" tube
 2" Schd. 40
 2" Schd. 80

Post Temper:

6063-T6
 6005-T5
 6061-T6 or 6105-T5
 Post Welded to Base Plate

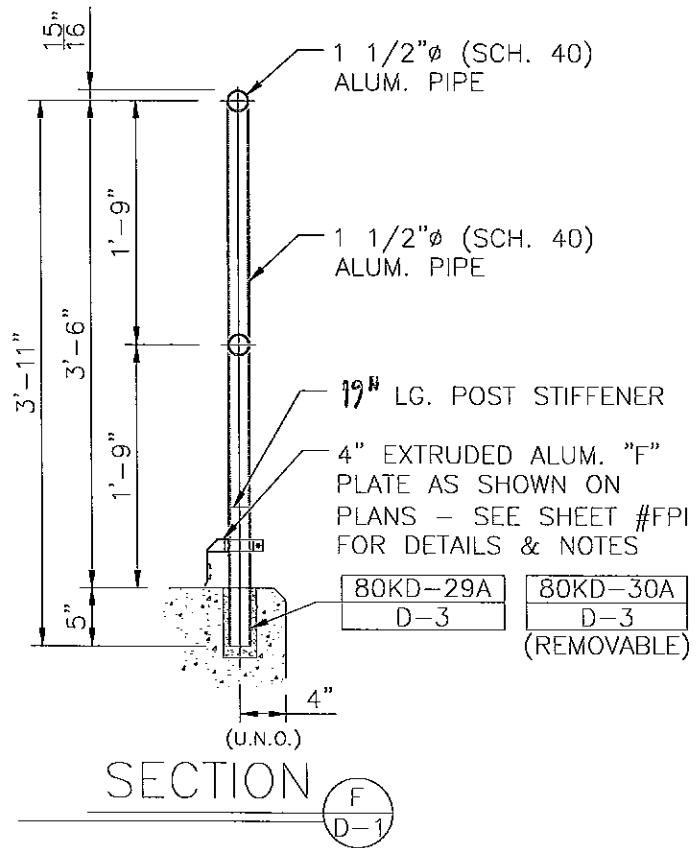

All calculations below this line are automatic

Railing Properties

$I_{xr} = 0.31$
 $I_{yr} = 0.31$
 $S_{xr} = 0.326$
 $S_{yr} = 0.326$
 $R = 0.95$
 $t = 0.145$

$E_r := 10100000$ psi

$I_{xtotr} := I_{xr}$ $I_{xtotr} = 0.31$ in⁴

$I_{ytotr} := I_{yr}$ $I_{ytotr} = 0.31$ in⁴

Post Properties

$I_{xp} = 0.31$
 $I_{yp} = 0.31$
 $S_{xp} = 0.326$
 $S_{yp} = 0.326$
 $R = 0.95$
 $t = 0.145$

$I_{xtotp} := I_{xp}$ $I_{xtotp} = 0.31$ in⁴

$I_{ytop} := I_{yp}$ $I_{ytop} = 0.31$ in⁴

Computational Factors

$SR_1 := \frac{R_r}{t_r}$ $SR_1 = 6.55$ $K_1 := (8 \cdot q_1) + (8 \cdot q_2) + (9.5 \cdot q_3)$ $K_1 = 8$
 $SR_3 := \frac{R_p}{t_p}$ $SR_3 = 6.55$ $K_2 := (4 \cdot q_1) + (5 \cdot q_2) + (5 \cdot q_3)$ $K_2 = 5$
 $K_3 := (48 \cdot q_1) + (66 \cdot q_2) + (87 \cdot q_3)$ $K_3 = 66$

19" Min. Length AL. Ribbed Tube Stub

$I_{st} := 0.174$ in⁴ $L_{st} := 14$ in
 $S_{st} := 0.224$ in³ $F_{bst} := 25000$ psi

RICE ENGINEERING Template: REL-MC-5707	105 School Creek Trail Luxemburg, WI 54217 Phone: (920)845-1042 Fax: (920)845-1048 www.rice-inc.com	Project Description: RMR 80KD System	Job No: R11-10-240 Engineer: JDB Date: 10/24/11 Chk By:	Sheet No: F1 Rev: Date:
--	---	--	--	-------------------------------

Railing Analysis:

$$W_h := \frac{F_H}{12}$$

$$W_v := \frac{F_V}{12}$$

Guardrail "F" Analysis

SHT
F1 A

Case 1 Uniform Load:

$$\Delta_{yr1} := \frac{5 \cdot W_h \cdot L^4}{384 \cdot E_r \cdot I_{ytotr}}$$

$$\Delta_{yr1} = 0.466 \quad \text{in} \quad \text{Modeled as a simple span}$$

$$\Delta_{xr1} := \frac{5 \cdot W_v \cdot L^4}{384 \cdot E_r \cdot I_{xtotr}}$$

$$\Delta_{xr1} = 0 \quad \text{in}$$

$$\Delta_{allr} := \frac{L}{96}$$

$$\Delta_{allr} = 0.75 \quad \text{in} \quad \text{Per ASTM Specification E985}$$

$$M_{yrmax} := \frac{W_h \cdot L^2}{K_1}$$

$$M_{yrmax} = 2700 \quad \text{lb-in}$$

$$M_{xrmax} := \frac{W_v \cdot L^2}{K_1}$$

$$M_{xrmax} = 0 \quad \text{lb-in}$$

$$f_{bry1} := \frac{M_{yrmax}}{S_{yr}}$$

$$f_{bry1} = 8282 \quad \text{psi}$$

$$f_{brx1} := \frac{M_{xrmax}}{S_{xr}}$$

$$f_{brx1} = 0 \quad \text{psi}$$

Case 2 - Point Load:

$$\Delta_{yr2} := \frac{P \cdot L^3}{K_3 \cdot E_r \cdot I_{ytotr}}$$

$$\Delta_{yr2} = 0.361 \quad \text{in}$$

$$M_{yrmax2} := \frac{P \cdot L}{K_2}$$

$$M_{yrmax2} = 2880 \quad \text{lb-in}$$

$$f_{bry2} := \frac{M_{yrmax2}}{S_{yr}}$$

$$f_{bry2} = 8834 \quad \text{psi}$$

$$F_{bry} := \begin{cases} (f_{bry1} \cdot 1.33) & \text{if IBC} = 1 \\ f_{bry1} & \text{otherwise} \end{cases}$$

$$F_{bry} = 25000 \quad \text{psi}$$

Calculation Results:

$$Int_{r1} := \left(\frac{f_{brx1}}{F_{bry}} \right) + \left(\frac{f_{bry1}}{F_{bry}} \right) \quad Int_{r1} = 0.33$$

$$Int_{r2} := \frac{f_{bry2}}{F_{bry}} \quad Int_{r2} = 0.35$$

$$RAILS := \begin{cases} \text{"OK"} & \text{if } \frac{\max(\Delta_{yr1}, \Delta_{xr1}, \Delta_{yr2})}{\Delta_{allr}} \leq 1 \wedge \left(\frac{f_{brx1}}{F_{bry}} \right) + \left(\frac{f_{bry1}}{F_{bry}} \right) \leq 1 \wedge \frac{f_{bry2}}{F_{bry}} \leq 1 \\ \text{"FAIL"} & \text{otherwise} \end{cases}$$

RAILS = "OK"

RICE ENGINEERING Template: REI-MC-5707	105 School Creek Trail Luxemburg, WI 54217 Phone: (920)845-1042 Fax: (920)845-1048 www.rice-inc.com	Project Description: RMR 80KD System	Job No: R11-10-240 Engineer: JDB Date: 10/24/11 Chk By:	Sheet No: F1 A Rev: Date:
--	---	---	--	---------------------------------

Post Analysis:

$E_p := E_r$

Guardrail "F" Analysis	SHT F1 B
------------------------	-------------

$$\Delta_{xp1} := \frac{W_h \cdot L \cdot (h - L_{st})^3}{3 \cdot E_p \cdot (I_{xp})}$$

$\Delta_{xp1} = 0.701$ in

$$\Delta_{xp2} := \frac{P \cdot 0.85 \cdot (h - L_{st})^3}{3 \cdot E_p \cdot (I_{xp})}$$

$\Delta_{xp2} = 0.397$ in

Max Deflection:

$$\Delta_{tot} := \frac{W_h \cdot L \cdot (h - L_{st})^3}{3 \cdot E_p \cdot I_{xp}} + \frac{W_h \cdot L \cdot [h^3 - (h - L_{st})^3]}{3 \cdot [(E_p \cdot I_{xp}) + (E_p \cdot I_{st})]}$$

$\Delta_{tot} = 1.768$ in

$$\Delta_{allp} := \frac{h}{12}$$

$\Delta_{allp} = 3.5$ in Per ASTM E985

Case 1 - Uniform Load:

$$M_{xp} := (W_h \cdot L \cdot h) + W_v \cdot L \cdot \Delta_{tot}$$

$$M_{xpmax} := 0.5 \cdot M_{xp} \cdot q1 + M_{xp} \cdot q2 + M_{xp} \cdot q3$$

$M_{xpmax} = 12600$ lb-in

$$M_{xp2} := W_h \cdot L \cdot (h - L_{st}) + W_v \cdot L \cdot \Delta_{xp1}$$

$$M_{xpmax2} := 0.5 \cdot M_{xp2} \cdot q1 + M_{xp2} \cdot q2 + M_{xp2} \cdot q3$$

$M_{xpmax2} = 8400$ lb-in

Case 2 - Point Load:



$$M_{xpmax4} := P \cdot (h - L_{st}) \cdot 0.85$$

$M_{xpmax4} = 4760$ lb-in

$$M_{xpmax3} := (P \cdot h \cdot 0.85)$$

$M_{xpmax3} = 7140$ lb-in

Max Post Stress:

$$f_{bpx} := \frac{\max(M_{xpmax2}, M_{xpmax4})}{S_{xp}}$$

$f_{bpx} = 25767$ psi

$$F_{bpx} := \begin{cases} (F_{bpx1} \cdot 1.33) & \text{if } IBC = 1 \\ F_{bpx1} & \text{otherwise} \end{cases}$$

$F_{bpx} = 25000$ psi

Max Post/Stub Combined Stress:

$$f_{bpx2} := \max(M_{xpmax}, M_{xpmax3}) \cdot \frac{I_{xp}}{(I_{xp} + I_{st}) \cdot S_{xp}}$$

$f_{bpx2} = 24755$ psi

$F_{bpx} = 25000$ psi

Max Stub Stress:

$$f_{bst} := \max(M_{xpmax}, M_{xpmax3}) \cdot \frac{I_{st}}{(I_{xp} + I_{st}) \cdot S_{st}}$$

$f_{bst} = 20222$ psi

$F_{bst} = 25000$ psi

Calculation Results:

$$Int_{p1} := \max\left(\frac{f_{bpx}}{F_{bpx}}, \frac{f_{bpx2}}{F_{bpx}}, \frac{f_{bst}}{F_{bst}}\right)$$

$Int_{p1} = 1.03$ 3% Over OK

$$POSTS := \begin{cases} \text{"OK"} & \text{if } Int_{p1} \leq 1.034 \wedge \frac{\max(\Delta_{xp1}, \Delta_{xp2}, \Delta_{tot})}{\Delta_{allp}} \leq 1 \\ \text{"FAIL"} & \text{otherwise} \end{cases}$$


$POSTS = \text{"OK"}$

RICE ENGINEERING Template: REI-MC-5707	105 School Creek Trail Luxemburg, WI 54217 Phone: (920)845-1042 Fax: (920)845-1048 www.rice-inc.com	Project Description:	Job No:	R11-10-240
		RMR 80KD System	Engineer:	JDB
			Date:	10/24/11
			Rev:	F1 B
		Chk By:	Date:	

Chk conc. grout:

$\phi := 0.65$
 $R_{max} := 300$ lb $f_{c1} := 6000$ psi *Grout Strength*
 $M := 12600$ lb-in $f_{c2} := 4000$ psi *Conc. Strength*
 $L := 5$ in $LF := 1.6$ (*Load Factor*)
 $D_1 := 1.9$ in (*Post Width*) $c := \frac{L}{2}$
 $D_2 := 3$ in (*Grout Pocket Width*)

Post Embedment in Grout	SHT F2
-------------------------	--------

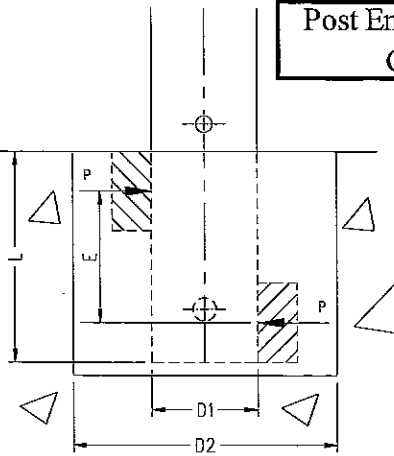

Assume Whitney stress block for bearing distribution:


$$\beta_1 := \max \left(\left(\frac{0.85 - .05 \cdot \frac{f_{c1} - 4000}{1000}}{0.65} \right) \right) \quad \beta_1 = 0.75 \quad a_1 := \beta_1 \cdot c \quad a_1 = 1.88$$

$A_1 := a_1 \cdot D_1 \quad A_1 = 3.56$ in (*Bearing Area*)
 $E_1 := L - a_1 \quad E_1 = 3.13$ in (*Load Eccentricity*)

$P_1 := \frac{M}{E_1} + \frac{R_{max}}{2} \quad P_1 = 4182$ lb (*Bearing Load*)

$\phi F_{p1} := \phi \cdot 0.85 \cdot A_1 \cdot f_{c1} \quad \phi F_{p1} = 11810$ lb (*Allowable Bearing Load*)

$I_1 := \frac{LF \cdot P_1}{\phi F_{p1}} \quad I_1 = 0.57$

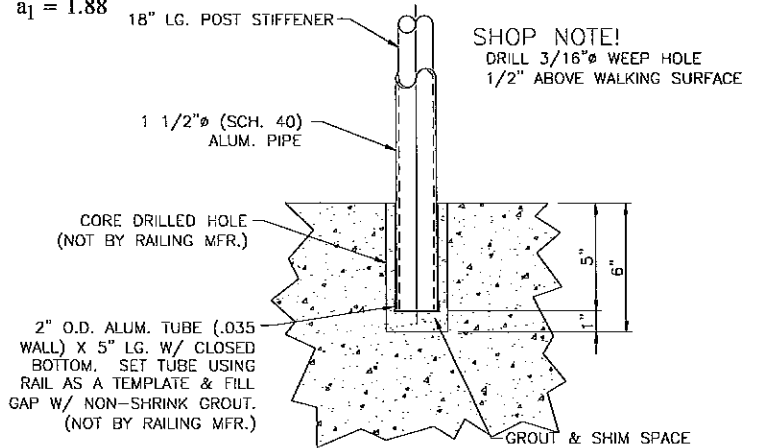

REMOVABLE SLEEVE

80KD-30A

Chk concrete (for reference only):


$$\beta_2 := \max \left(\left(\frac{0.85 - .05 \cdot \frac{f_{c2} - 4000}{1000}}{0.65} \right) \right) \quad \beta_2 = 0.85 \quad a_2 := \beta_2 \cdot c \quad a_2 = 2.13$$

$A_2 := a_2 \cdot D_2 \quad A_2 = 6.38$ in (*Bearing Area*)
 $E_2 := L - a_2 \quad E_2 = 2.88$ in (*Load Eccentricity*)

$P_2 := \frac{M}{E_2} + \frac{R_{max}}{2} \quad P_2 = 4533$ lb (*Bearing Load*)

$\phi F_{p2} := \phi \cdot 0.85 \cdot A_2 \cdot f_{c2} \quad \phi F_{p2} = 14089$ lb (*Allowable Bearing Load*)

$I_2 := \frac{LF \cdot P_2}{\phi F_{p2}} \quad I_2 = 0.51$

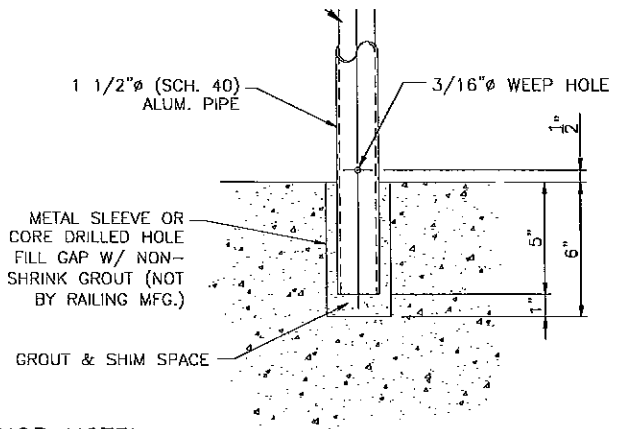


SHOP NOTE!
 DRILL 3/16" WEEP HOLE
 1/2" ABOVE WALKING SURFACE

FIXED SLEEVE

80KD-29A


Use 6,000 psi, non-shrink Grout
-Design of Bearing on Concrete by others
-Design of Concrete Breakout and point loads
By others

RICE ENGINEERING Template: REL-MC-5740	105 School Creek Trail Luxemburg, WI 54217 Phone: (920)845-1042 Fax: (920)845-1048 www.rice-inc.com	Project Description: RMR 80KD System	Job No: R11-10-240
			Engineer: JDB Sheet No: F2
			Date: 10/24/11 Rev:
			Chk By: Date:

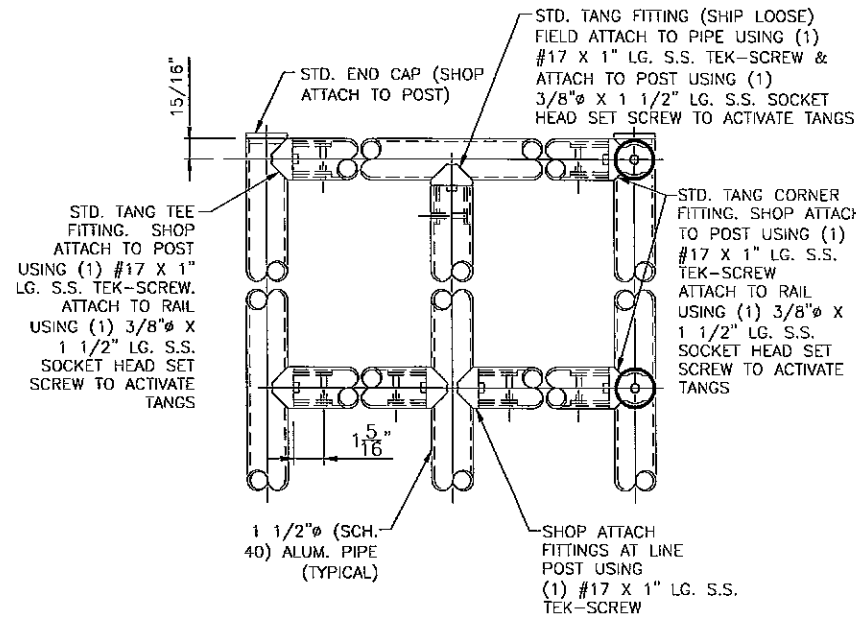

END POST LINE POST CORNER POST
 TYPICAL LEVEL RAIL CONNECTIONS

80KD-2

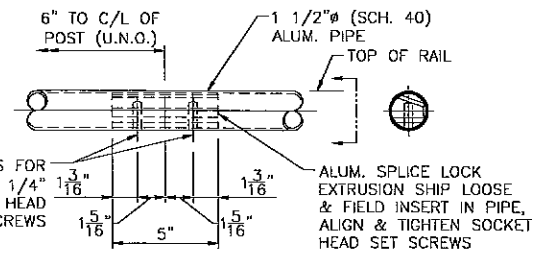

Miscellaneous Connections	SHT M1
---------------------------	--------

$R_{max} := 300 \text{ lb}$

$V_{splice} := 200 \text{ lb}$

Chk 3/8" Dia. Set Screws @ Splice:

Use (2) - 3/8" Dia. S.S. Set Screws per Splice
 Cond "CW", $F_y = 65 \text{ ksi}$
 Ok By Inspection - Shear Loads at Splice Only

Chk 3/8" Dia. Set Screws @ Tang/Rail:

$T := R_{max}$ $T = 300 \text{ lb}$

$T_{all} := 3100 \cdot \frac{0.145}{0.341}$ $T_{all} = 1318 \text{ lb}$

Use (1) - 3/8" Dia. S.S. Set Screws per "Tang"
 Cond "CW", $F_y = 65 \text{ ksi}$

Chk Splice Piece: $A := 0.035 \text{ in}^2$

$f_v := \frac{V_{splice}}{A}$ $f_v = 5714 \text{ psi}$

$F_v := 12000 \text{ psi}$

Chk Screw @ Tang/Post :



$V := R_{max}$ $V = 300 \text{ lb}$

$V_{all2} := 2148 \cdot 0.333$ $V_{all2} = 715 \text{ lb}$

Use Aluminum Splice Piece, As Shown
 6105-T5 or 6061-T6 Alloy

Use (1) - #17 S.S. TEK Screw
 300 Series S.S.
 ITW Buildex or Better

RICE ENGINEERING Template: REL-MC-5741	105 School Creek Trail Luxemburg, WI 54217 Phone: (920)845-1042 Fax: (920)845-1048 www.rice-inc.com	Project Description: RMR 80KD System	Job No: R11-10-240
			Engineer: JDB Sheet No: M1
			Date: 10/24/11 Rev:
			Chk By: Date:

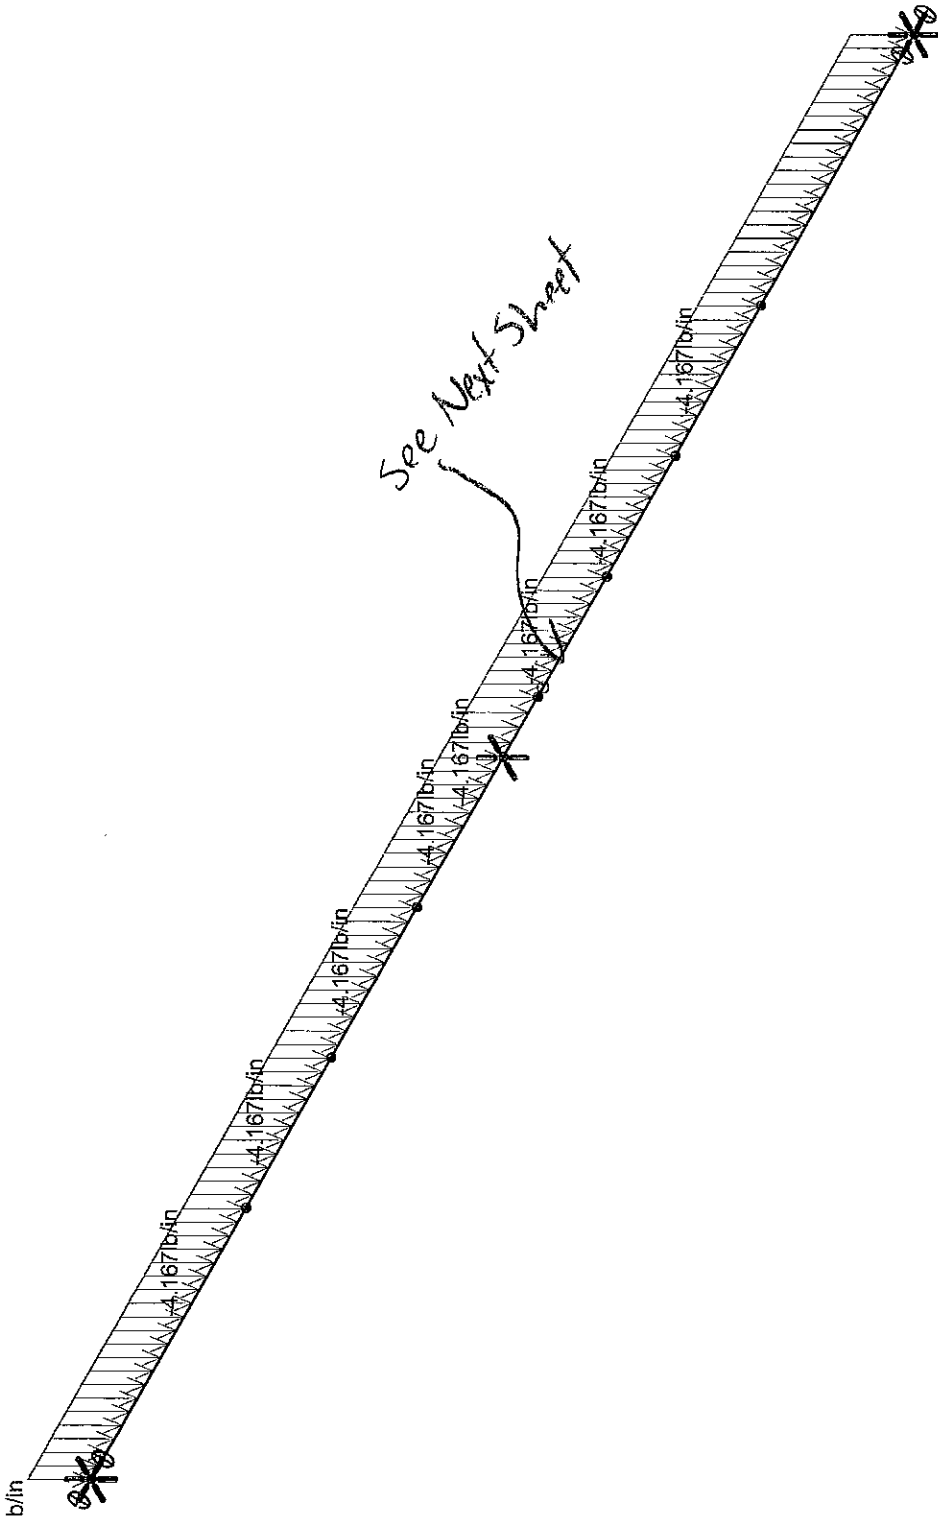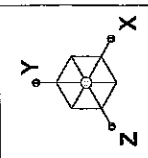

Loads: BLC 1, 50 PLF
 Results for LC 1, 50 PLF

Rice Engineering
 Joe Bauer

6 ft Rail Lengths

SK - 1

Oct 25, 2011 at 3:13 PM

6 ft Splice Loads.r3d

Member: **M5**

Shape: **1.9" OD x 0.145" Wall**

Material: **ALUM**

Length: **12 in**





I Joint: **N2**

J Joint: **N7**

LC 1: **50 PLF**

Code Check: **0.426 (bending)**

Report Based On 97 Sections

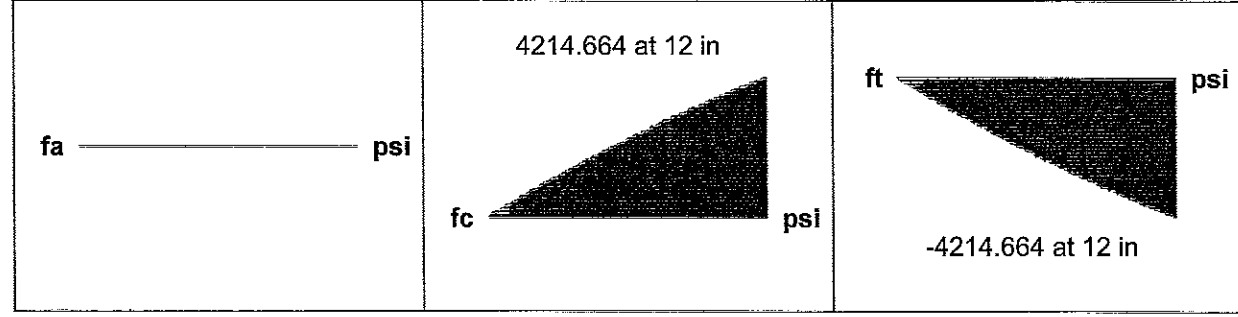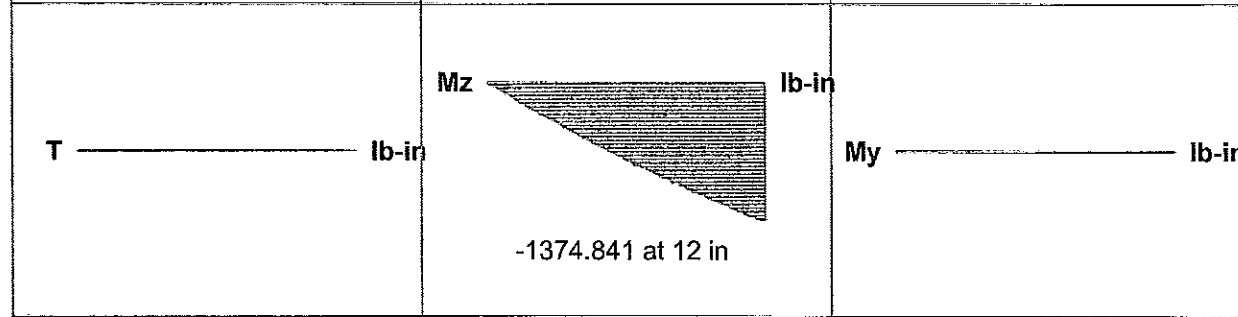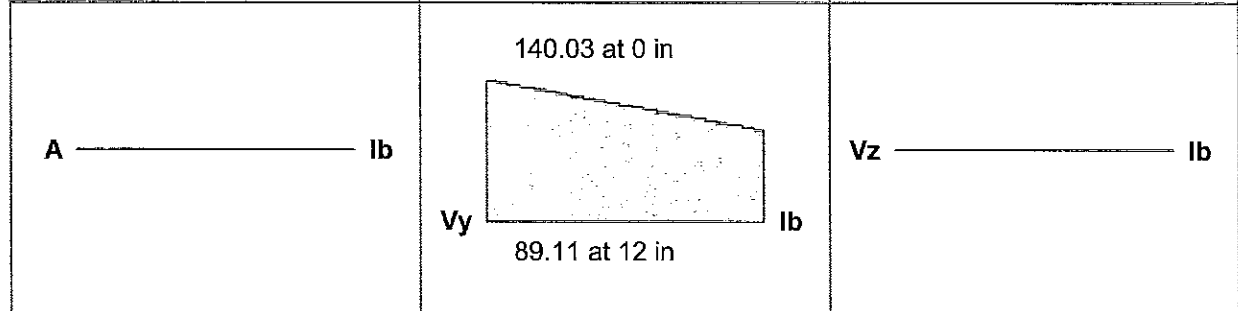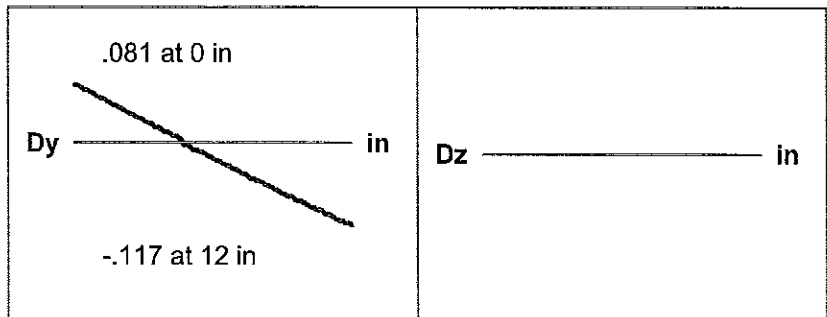

AISC 9th: ASD Code Check

Max Bending Check **0.426**
 Location **12 in**
 Equation **H1-1**

Max Shear Check **0.058 (s)**
 Location **0 in**
 Max Defl Ratio **L/2719**

Compact

Fy **15000 psi**
 Fa **8555.401 psi**
 Ft **9000 psi**
 Fby **9900 psi**
 Fbz **9900 psi**
 Fvy **6000 psi**
 Fvz **6000 psi**
 Cb **1.75**

	y-y	z-z
Cm	1	1
Lb	12 in	12 in
KL/r	19.274	19.274
Sway	No	No
L Comp Flange	12 in	
Torque Length	NC	

**ASSUME GROUT FILLED CMU
DESIGNED BY OTHERS**


**Wall Rail Post Bracket
Analysis**

**SHT
M2**

(Reaction From RISA Model)

$R_{max} := 113 \text{ lb}$

$M_{max} := 2287 \text{ lb-in}$

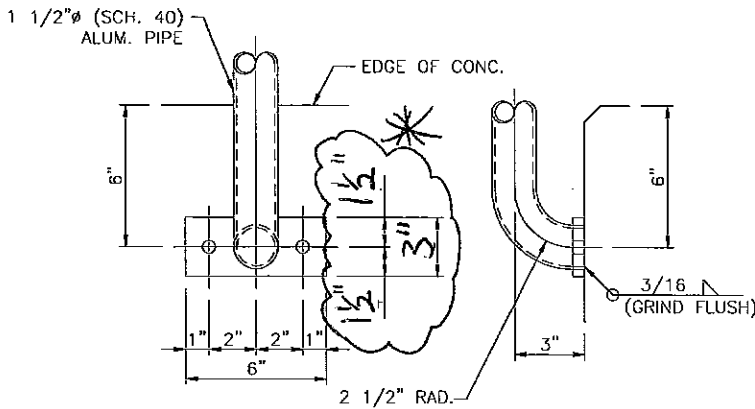

CUSTOMER NOTE!
FILL VOID CAVITY IN CMU WITH
GROUT @ ALL RAIL MOUNTING
LOCATIONS.

WALL RAIL LINE POST

80KD-35A

Chk weld to base plate:

$t_w := 0.1875 \text{ in (thickness of weld)}$

$d := 1.9 \text{ in (stub depth)}$

$A_w := t_w (\pi \cdot 0.5 \cdot d) \quad A_w = 0.56 \text{ in}^2$

$T := \frac{M_{max}}{d} \quad T = 1204 \text{ lb}$

$f_w := \frac{T}{A_w} \quad f_w = 2151 \text{ psi}$

$F_w := 6500 \text{ psi}$

**Use 3/16" weld all around as noted
5356 filler alloy**

Chk Aluminum Base Plate:

$L1 := 6 \text{ in} \quad D1 := 1 \text{ in}$

$L2 := 3 \text{ in} \quad D2 := 3 \text{ in}$

$t := 0.5 \text{ in}$

$L := L1 - (2 \cdot D1) \quad L = 4 \text{ in}$

$P := \frac{M_{max}}{d} \quad P = 1204 \text{ lb}$

$M_{pl1} := 0.5 \cdot P \cdot L \quad M_{pl1} = 602 \text{ in-lb}$

$M_{pl2} := 0.5 \cdot P \cdot (1.05) \quad M_{pl2} = 632 \text{ in-lb}$

$t_{req1} := \sqrt{\frac{M_{pl1} \cdot 6}{(12000) \cdot L2}} \quad t_{req1} = 0.317 \text{ in}$

$t_{req2} := \sqrt{\frac{M_{pl2} \cdot 6}{(28000) \cdot L2}} \quad t_{req2} = 0.212 \text{ in}$

$l_2 := \frac{\max(t_{req1}, t_{req2})}{t} \quad l_2 = 0.63$

**Use 1/2" x 6" x 3" AL Plate
6061-T6 alloy**

Note:
Anchor
Size

Chk Bolts to Grout Filled CMU:

$V_b := \frac{R_{max}}{2} \quad V_b = 57 \text{ lb}$

$T_b := \frac{M_{max}}{2 \cdot (0.5 \cdot D2) \cdot 0.85} + \frac{R_{max}}{(2)} \quad T_b = 953 \text{ lb}$

$T_{all} := \min(1100, 1975 \cdot 0.5) \quad T_{all} = 988 \text{ lb}$

$V_{all} := \min(1419, 2756 \cdot 0.5) \quad V_{all} = 1378 \text{ lb}$

$I_b := \left(\frac{T_b}{T_{all}}\right)^{1.67} + \left(\frac{V_b}{V_{all}}\right)^{1.67} \quad I_b = 0.95$

**Use (2) - 3/8" Dia. S.S. Threaded Rods
W/ Hilti HIT-RE 500 SD or HIT-HY 150 MAX SD Adhesive
Edge Distance: 4"
End Distance: 4"
Embedment: 4-1/2"**

**RICE
ENGINEERING**

Template:

105 School Creek Trail
Luxemburg, WI 54217
Phone: (920)845-1042
Fax: (920)845-1048
www.rice-inc.com

Project Description:



RMR 80KD System

Job No: R11-10-240

Engineer: JDB Sheet No: M2

Date: 10/24/11 Rev:

Chk By: Date:

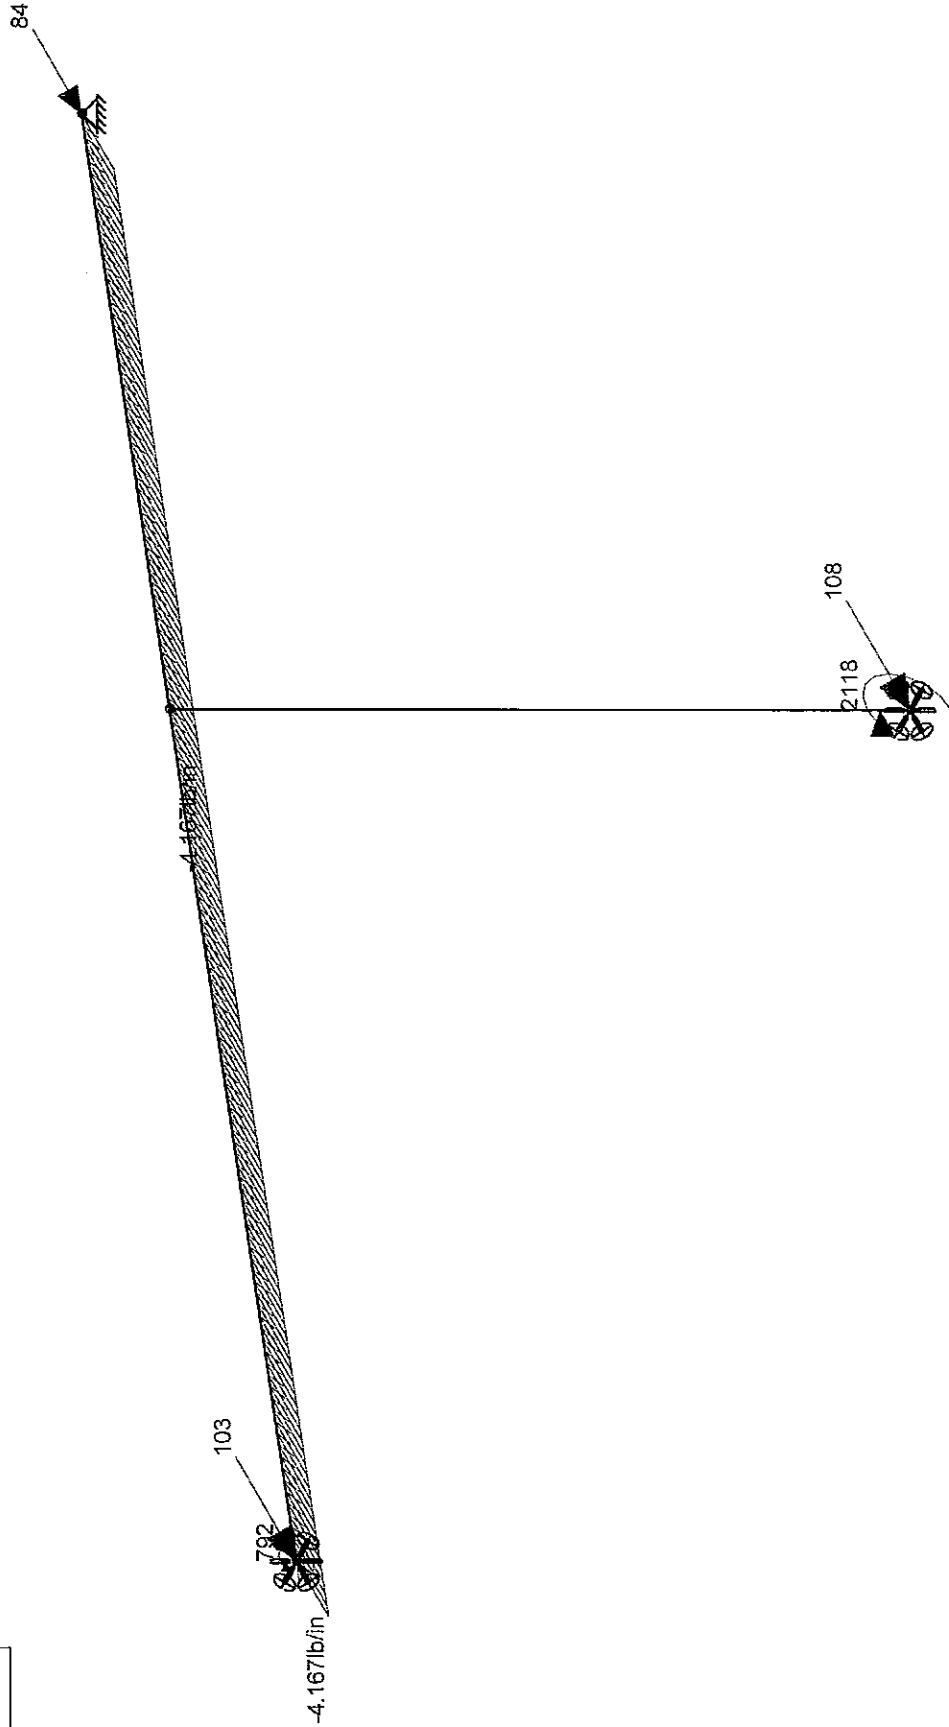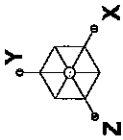

Loads: BLC 1,
 Results for LC 1, Dist 1
 Z-moment Reaction units are lb and lb-in

Rice Engineering



Joe Bauer

SK - 2

Feb 23, 2011 at 3:23 PM

Handrail Post Bracket.r3d

M2A

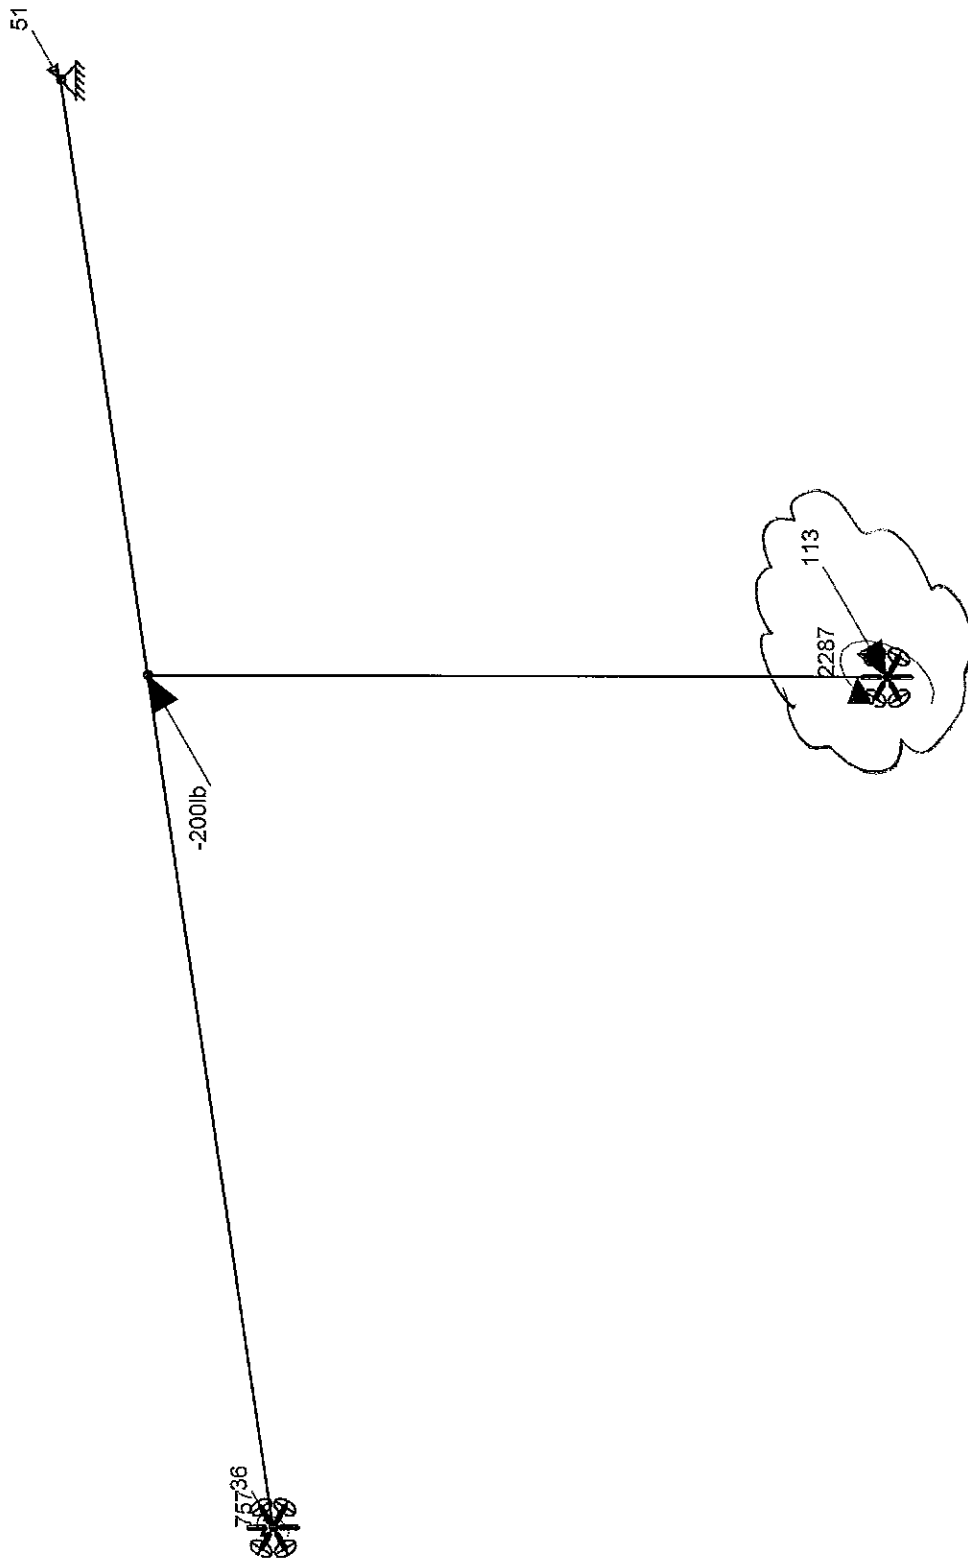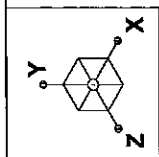

Loads: BLC 2,
 Results for LC 2, Point
 Z-moment Reaction units are lb and lb-in

Rice Engineering

Joe Bauer

SK - 3

Feb 23, 2011 at 3:24 PM

Handrail Post Bracket.r3d

Pipe Handrail

These calculations are based on empirical test data performed by Julius Blum & Co., Inc.

Wall or Grab Rail Analysis	SHT M3
----------------------------	-----------

Input Variables:

$F_H := 50 \frac{\text{lb}}{\text{ft}}$ Load Case 1 (Uniform Load)
 $F_V := 0 \frac{\text{lb}}{\text{ft}}$ Simultaneous Vertical Uniform Load
 $P := 200 \text{ lb}$ Load Case 2 (Point Load)
 $L := 72 \text{ in}$ **MAX BRACKET SPACING (cl to cl)**


(Note: Bracket Spacing is limited to 5'0" and is not governed by the rail.)

Number of Railing Spans:

1 span
 2 span
 3 or more spans

Railing Section:

1 1/4" Schd. 40
 1 1/4" Schd. 80
 1 1/2" Schd. 40
 1 1/2" Schd. 80
 1 1/2" tube
 2" Schd. 40
 2" Schd. 80

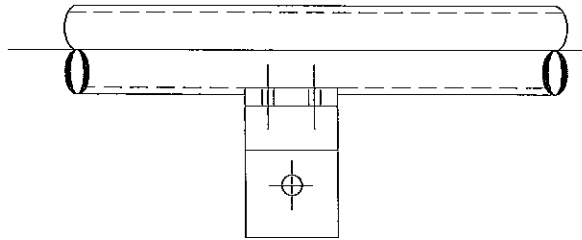

Railing Temper:

6105-T5 or 6061-T6
 6063-T5
 4/3 increase allowed

All calculations below this line are automatic

Railing Properties

$I_{xr} =$	0.31
$I_{yr} =$	0.31
$S_{xr} =$	0.326
$S_{yr} =$	0.326
$R =$	0.95
$t =$	0.145

Computational Factors

$K_1 := (8 \cdot q_1) + (8 \cdot q_2) + (9.5 \cdot q_3) \quad K_1 = 8$
 $K_2 := (4 \cdot q_1) + (5 \cdot q_2) + (5 \cdot q_3) \quad K_2 = 5$
 $K_3 := (48 \cdot q_1) + (66 \cdot q_2) + (87 \cdot q_3) \quad K_3 = 66$

$E_r := 10100000 \text{ psi}$

$I_{xtotr} := I_{xr} \quad I_{xtotr} = 0.31 \text{ in}^4$

$I_{ytotr} := I_{yr} \quad I_{ytotr} = 0.31 \text{ in}^4 \quad S_{R1} := \frac{R_r}{t_r} \quad S_{R1} = 6.55$

RICE ENGINEERING Template: REI-MC-5702	105 School Creek Trail Luxemburg, WI 54217 Phone: (920)845-1042 Fax: (920)845-1048 www.rice-inc.com	Project Description: RMR 80KD System	Job No: R11-10-240
			Engineer: JDB Sheet No: M3
			Date: 10/24/11 Rev:
			Chk By: Date:

Railing Analysis:

$$W_h := \frac{F_H}{12}$$

$$W_v := \frac{F_V}{12}$$

Wall or Grab Rail Analysis	SHT M3 A
-------------------------------	-------------

Case 1 Uniform Load:

$$\Delta_{yr1} := \frac{5 \cdot W_h \cdot L^4}{384 \cdot E_r \cdot I_{ytotr}}$$

$$\Delta_{yr1} = 0.466 \quad \text{in} \quad \text{Modeled as a simple span}$$

$$\Delta_{xr1} := \frac{5 \cdot W_v \cdot L^4}{384 \cdot E_r \cdot I_{xtotr}}$$

$$\Delta_{xr1} = 0 \quad \text{in}$$

$$\Delta_{allr} := \frac{L}{96}$$

$$\Delta_{allr} = 0.75 \quad \text{in} \quad \text{Per ASTM E985}$$

$$M_{yrmax} := \frac{W_h \cdot L^2}{K_1}$$

$$M_{yrmax} = 2700 \quad \text{lb-in}$$

$$M_{xrmax} := \frac{W_v \cdot L^2}{K_1}$$

$$M_{xrmax} = 0 \quad \text{lb-in}$$



$$f_{bry1} := \frac{M_{yrmax}}{S_{yr}}$$

$$f_{bry1} = 8282 \quad \text{psi}$$

$$f_{brx1} := \frac{M_{xrmax}}{S_{xr}}$$

$$f_{brx1} = 0 \quad \text{psi}$$

Case 1 Point Load:

$$\Delta_{yr2} := \frac{P \cdot L^3}{K_3 \cdot E_r \cdot I_{ytotr}}$$

$$\Delta_{yr2} = 0.361 \quad \text{in}$$

$$M_{yrmax2} := \frac{P \cdot L}{K_2}$$

$$M_{yrmax2} = 2880 \quad \text{lb-in}$$

$$f_{bry2} := \frac{M_{yrmax2}}{S_{yr}}$$

$$f_{bry2} = 8834 \quad \text{psi}$$

$$F_{bry} := \begin{cases} (f_{bry1} \cdot 1.34) & \text{if IBC} = 1 \\ f_{bry1} & \text{otherwise} \end{cases}$$

$$F_{bry} = 25000 \quad \text{psi}$$

Calculation Results:

$$Int_1 := \left(\frac{f_{brx1}}{F_{bry}} \right) + \left(\frac{f_{bry1}}{F_{bry}} \right)$$

$$Int_1 = 0.33$$

$$Int_2 := \frac{f_{bry2}}{F_{bry}}$$

$$Int_2 = 0.35$$


$$RAILS := \begin{cases} \text{"OK"} & \text{if } \frac{\max(\Delta_{yr1}, \Delta_{xr1}, \Delta_{yr2})}{\Delta_{allr}} \leq 1 \wedge \left(\frac{f_{brx1}}{F_{bry}} \right) + \left(\frac{f_{bry1}}{F_{bry}} \right) \leq 1 \wedge \frac{f_{bry2}}{F_{bry}} \leq 1 \\ \text{"FAIL"} & \text{otherwise} \end{cases}$$

$$RAILS = \text{"OK"}$$

RICE ENGINEERING Template: REI-MC-5702	105 School Creek Trail Luxemburg, WI 54217 Phone: (920)845-1042 Fax: (920)845-1048 www.rice-inc.com	Project Description:	Job No: R11-10-240
		RMR 80KD System	Engineer: JDB Sheet No: M3 A
			Date: 10/24/11 Rev:
			Chk By: Date:

Inputs:

$L_s := 60$ in (bracket span) $A := 3.0$ in
 $w_h := 0$ plf (horiz uniform load) $B := 2.125$ in
 $w_v := 50$ plf (vert uniform load) $C := 2.5$ in
 $P := 200$ lb (conc. load) $D := 1.0$ in
 $F_b := 28000$ psi (Allowable Stress) $H := 4.25$ in
 $L := 2$ in
 $t := 0.25$ in
 $\sqrt{4/3}$ Stress Increase Allowed

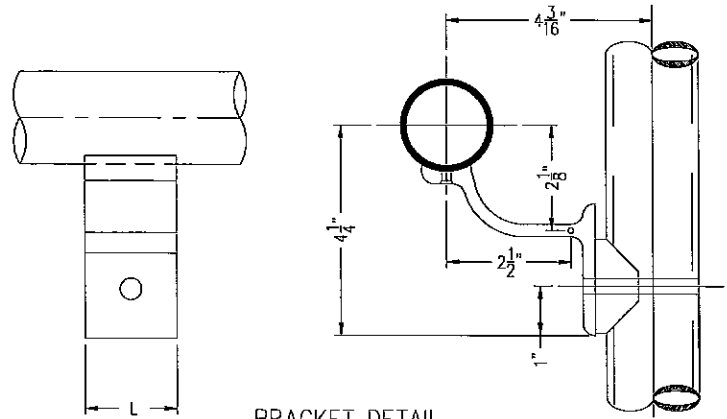

BRACKET DETAIL

Horizontal Uniform Loading:

$R_1 := \frac{w_h \cdot L_s}{12}$ $R_1 = 0$ lbs
 $M_1 := B \cdot R_1$ $M_1 = 0$ in-lb

Vertical Uniform Loading:

$R_2 := \frac{w_v \cdot L_s}{12}$ $R_2 = 250$ lbs
 $M_2 := C \cdot R_2$ $M_2 = 625$ in-lb
 $M_{b1} := M_1 + M_2$ $M_{b1} = 625$ in-lb

Concentrated Loading:

$M_{b2} := P \cdot B$ $M_{b2} = 425$ in-lb
 $M_b := \max(M_{b1}, M_{b2})$ $M_b = 625$ in-lb

$F_{b1} := \begin{cases} (F_b \cdot 1.34) & \text{if IBC} = 1 \\ F_b & \text{otherwise} \end{cases}$

$t_{req} := \sqrt{\frac{6M_b}{F_{b1} \cdot L}}$ $t_{req} = 0.26$ in

Interaction:

$I := \frac{t_{req}}{t}$ $I = 1.04 < 5\% \text{ Over OK}$

**Use Aluminum Rail Bracket,
6105-T5 or 6061-T6 Alloy, 2" Long**

Anchorage to Post (Horizontal Load Case):

$M_3 := H \cdot P$ $M_3 = 850$ in-lb
 $T_p := \frac{M_3}{0.85D} + P$ $T_p = 1200$ lbs
 $V := \max(R_2, 200)$ $V = 250$ lbs
 $T_{all} := 3100 \cdot \frac{0.145}{0.341}$ $T_{all} = 1318$ lbs
 $V_{all} := 1614$ lbs
 $I_b := \left(\frac{T_p}{T_{all}}\right)^2 + \left(\frac{V}{V_{all}}\right)^2$ $I_b = 0.85$

**Use (1) - 3/8" Dia. S.S. Thru Bolts
Cond "CW", Fy= 65 ksi**

Bracket to Grab Rail Screws:

**Use (2) #1/4-20 S.S. Fasteners
"OK" per inspection**

RICE ENGINEERING Template:	105 School Creek Trail Luxemburg, WI 54217 Phone: (920)845-1042 Fax: (920)845-1048 www.rice-inc.com	Project Description: RMR 80KD System	Job No: R11-10-240
			Engineer: JDB Sheet No: M4
			Date: 10/24/11 Rev:
			Chk By: Date:


Inputs:

$L_s := 60$ in (bracket span) $A := 2.5$ in
 $w_h := 0$ plf (horiz uniform load) $B := 2.125$ in
 $w_v := 50$ plf (vert uniform load) $C := 2.5$ in
 $P := 200$ lb (conc. load) $D := 1.0$ in
 $F_b := 28000$ psi (Allowable Stress) $H := 4.313$ in

 $L := 2$ in
 $t := 0.25$ in

 $\sqrt{4/3}$ Stress Increase Allowed

**ASSUME GROUT FILLED CMU
DESIGNED BY OTHERS**

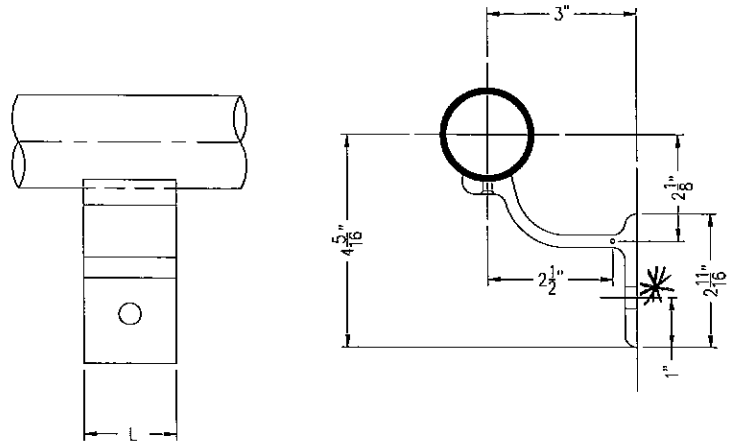

BRACKET DETAIL

Horizontal Uniform Loading:

$R_1 := \frac{w_h \cdot L_s}{12}$ $R_1 = 0$ lbs
 $M_1 := B \cdot R_1$ $M_1 = 0$ in-lb

Vertical Uniform Loading:

$R_2 := \frac{w_v \cdot L_s}{12}$ $R_2 = 250$ lbs
 $M_2 := C \cdot R_2$ $M_2 = 625$ in-lb

Concentrated Loading:

$M_3 := P \cdot \max(B, C)$ $M_3 = 500$ in-lb
 $M_b := \max(M_1, M_2, M_3)$ $M_b = 625$ in-lb

Wall Anchorage (Horizontal Load Case):

$M_4 := \max(P \cdot H, R_1 \cdot H, R_2 \cdot A)$ $M_4 = 863$ in-lb
 $T_p := \frac{M_4}{D \cdot 0.85} + P$ $T_p = 1215$ lbs
 $V := \max(R_2, 200)$ $V = 250$ lbs
 $T_{all} := 1319$ lbs
 $V_{all} := 2181$ lbs

$F_{b1} := \begin{cases} (F_b \cdot 1.34) & \text{if IBC} = 1 \\ F_b & \text{otherwise} \end{cases}$

$I_b := \left(\frac{T_p}{T_{all}} \right)^{1.67} + \left(\frac{V}{V_{all}} \right)^{1.67}$ $I_b = 0.9$

$t_{req} := \sqrt{\frac{6 \cdot M_b}{F_{b1} \cdot L}}$ $t_{req} = 0.26$ in

Note:
Anchor
Size

**Use (1) - 1/2" Dia. S.S. Threaded Rod
W/ Hilti HIT-RE 500 SD or HIT-HY 150 MAX SD Adhesive**
 Edge Distance: 4"
 End Distance: 4"
 Embedment: 4-1/2"

Interaction:

$I := \frac{t_{req}}{t}$ $I = 1.04 < 5\% \text{ OK}$

Bracket to Grab Rail Screws:

**Use Aluminum Wall Bracket,
6105-T5 or 6061-T6 Alloy, 2" Long**

**Use (2) #1/4-20 S.S. Fasteners
"OK" per inspection**


RICE ENGINEERING Template:	105 School Creek Trail Luxemburg, WI 54217 Phone: (920)845-1042 Fax: (920)845-1048 www.rice-inc.com	Project Description: RMR 80KD System	Job No: R11-10-240
			Engineer: JDB Sheet No: M5
			Date: 10/24/11 Rev:
			Chk By: Date:

ARCH/ENG NOTE:
 HANG-OFF RAIL CORNER NEEDS TO BE
 ATTACHED WITH A (SCH. 80) TEE FITTING
 RATHER THAN A (SCH. 40) TEE FITTING
 TO PROVIDE AMPLE SPACE FOR
 CONNECTION TO P-END.

Offset Rail Connections	SHT M6
----------------------------	-----------

$$R_{max} := 200 \text{ lb}$$

$$M_{max} := R_{max} \cdot 3.25 = 650 \text{ lb}\cdot\text{in}$$

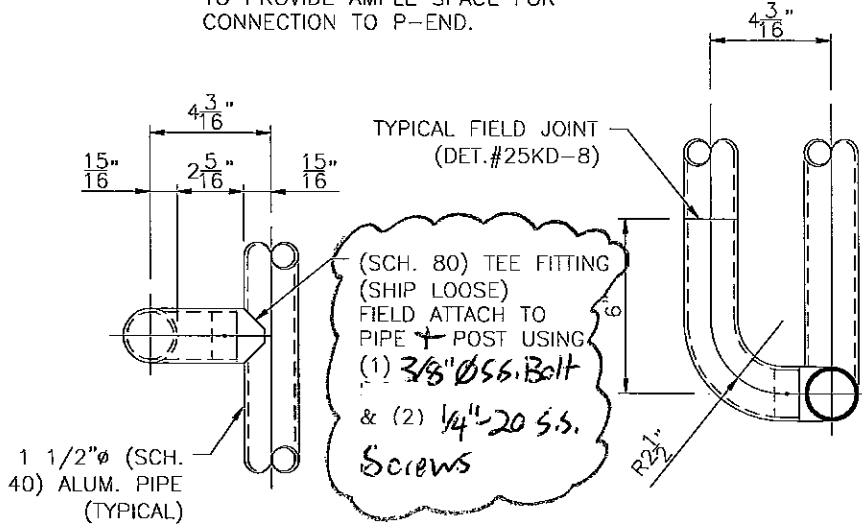

SPECIAL OFFSET RAIL CONNECTION

80KD-35E

Chk 1/4- 20 Screws @ Tee:

$$V := \frac{M_{max}}{1.9 \cdot 0.5 \cdot (2)}$$

$$V = 342 \text{ lb}$$

$$V_{all} := 647 \text{ lb}$$

Chk Thru-Bolts @ Tee:

$$T := \frac{M_{max}}{1.9 \cdot 0.5}$$

$$T = 684 \text{ lb}$$

$$T_{all} := 3100 \cdot \frac{0.2}{0.553}$$


$$T_{all} = 1121 \text{ lb}$$

Use (2) - 1/4- 20 S.S. Screws per "Tee"
 Cond "CW", Fy= 65 ksi

*
 *
 Note:
 Anchors

Use (1) - 3/8" Dia. S.S. Bolt
Drill & Tap or Thru-Bolt
 Cond "CW", Fy= 65 ksi
 0.200" min. Thread Engagement

RICE ENGINEERING Template:	105 School Creek Trail Luxemburg, WI 54217 Phone: (920)845-1042 Fax: (920)845-1048 www.rice-inc.com	Project Description: RMR 80KD System	Job No: R11-10-240 Engineer: JDB Date: 10/24/11 Chk By:	Sheet No: M6 Rev: Date:
--	---	---	--	-------------------------------

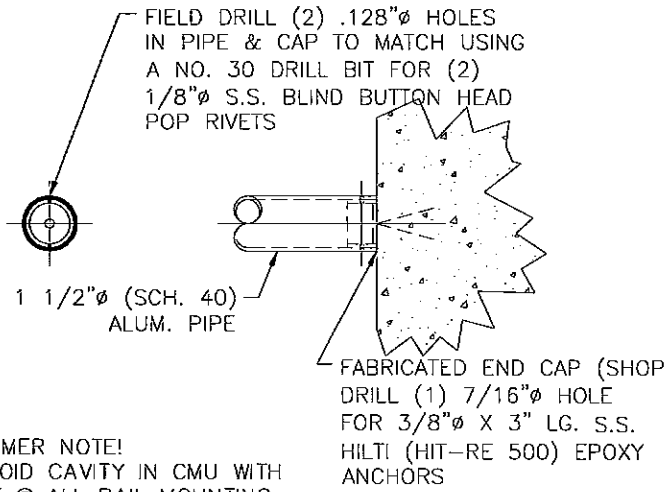

WALL MOUNT END CAP

80KD-33

Chk Fasteners:

Use (2) 1/8" Dia. S.S. Blind Button Head Pop Rivets
(OK By Inspection)

Chk End Cap:

Use End Cap as shown
(OK By Inspection)

Chk Anchors: (Assume Grout Filled CMU)

$R_{max} := 200 \quad lb$

$V := \frac{R_{max}}{1} \quad \boxed{V = 200} \quad lb$

$V_{all} := 1419 \quad \boxed{V_{all} = 1419} \quad lb \quad \boxed{V_{all2} := 380} \quad lb$


**Use (1) - 3/8" Dia. S.S. Threaded Rod w/
Hilti HIT-RE 500 MAX SD or HIT-HY 150 MAX Adhesive**
3-3/8" Min. Embedment
4" Min. Edge Distance

OR

Use (1) 1/4" Dia. S.S. Hilti Kwik Bolt 3
(300 Series S.S.)
1-1/8" Min. Embedment
4" Min. Edge Distance

RICE ENGINEERING Template:	105 School Creek Trail Luxemburg, WI 54217 Phone: (920)845-1042 Fax: (920)845-1048 www.rice-inc.com	Project Description: RMR 80KD System	Job No: R11-10-240
			Engineer: JDB Sheet No: M7
			Date: 10/24/11 Rev:
			Chk By: Date:

2 Bolt Raked Base Plate	SHT M8
----------------------------	-----------

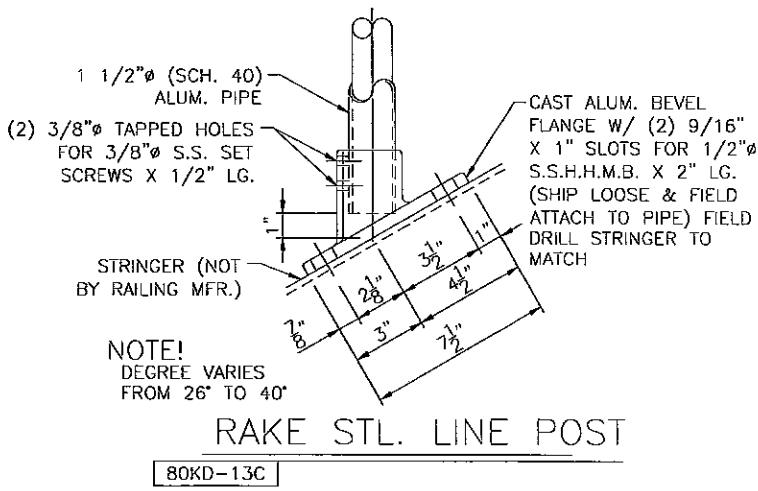

Actual Loads:

$L_r := 60$ in Rail Length

$h := 42$ in Rail Height

$R_1 := 4.17 \cdot (L_r) = 250$ lb

$M_1 := \max(R_1 \cdot h, 200 \cdot 0.85 \cdot h) = 10508$ in-lb

$M_{max1} := \cos(32deg) \cdot M_1 = 8912$ in-lb

$d := 2.5$ in (sleeve dia.)

Maximum Loads:

$R_{max} := 250$ lb

$M := R_{max} \cdot 42 = 10500$ in-lb

$M_{max} := \cos(32deg) \cdot M = 8905$ in-lb

$\sigma_{max} := 14182$ psi Based on Algor Model

$S_{eff} := \frac{M_{max}}{\sigma_{max}} = 0.63$ in³ Based on Algor Model

Chk shear on shoe wall:

$P := \frac{M_{max1}}{0.67 \cdot (2.375)}$ P = 5600 lb

$f_v := \frac{(P + R_{max})}{2 \cdot (0.315) \cdot (2)}$ $f_v = 4643$ psi

$F_v := \frac{0.57 \cdot (18000)}{1.65}$ $F_v = 6218$ psi

$I := \frac{f_v}{F_v}$ I = 0.75 Shear Stress "OK"

Chk Bolts to Steel Stringer:

$V_b := \frac{R_{max}}{2}$ $V_b = 125$ lb

$T_b := \frac{M_{max1}}{2 \cdot (0.5 \cdot L_2)}$ $T_b = 3565$ lb

$V_{all} := 0.196 \cdot 23094$ $V_{all} = 4526$ lb

$T_{all} := 0.142 \cdot 40000 \cdot \frac{0.3125}{0.456}$ $T_{all} = 3893$ lb

$I_3 := \left(\frac{V_b}{V_{all}}\right)^2 + \left(\frac{T_b}{T_{all}}\right)^2$ $I_3 = 0.84$

Chk Aluminum Base Plate:

$L_1 := 7.5$ in $D_1 := 1$ in

$L_2 := 2.5$ in $D_2 := 1.25$ in

$t := 0.5$ in

$\sigma_{actual} := \frac{M_{max1}}{S_{eff}}$ $\sigma_{actual} = 14193$ psi

$\sigma_{all} := \frac{1.3 \cdot (18000)}{1.65}$ $\sigma_{all} = 14182$ psi


$I_2 := \frac{\sigma_{actual}}{\sigma_{all}}$ $I_2 = 1$

Use Cast Aluminum Base, as shown
535 casting alloy, $F_u = 35$ ksi min.

Use (2) - 1/2" Dia. S.S. Thru-Bolts
or Drill & Tap w/ 5/16" Min. Thread Engagement
300 Series, $F_y = 65$ ksi Minimum


Note: Model based on 5'-0" max post spacing measured along rail and a post height of 3'-6"
See next page for worst case Algor model results

RICE ENGINEERING Template:	105 School Creek Trail Luxemburg, WI 54217 Phone: (920)845-1042 Fax: (920)845-1048 www.rice-inc.com	Project Description: RMR 80KD System	Job No: R11-10-240
			Engineer: JDB Sheet No: M8
			Date: 10/24/11 Rev:
			Chk By: Date:

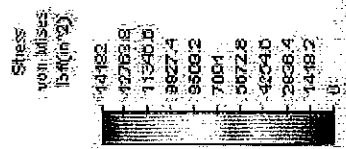

R = 250 lb

Rail Height = 3'-6"

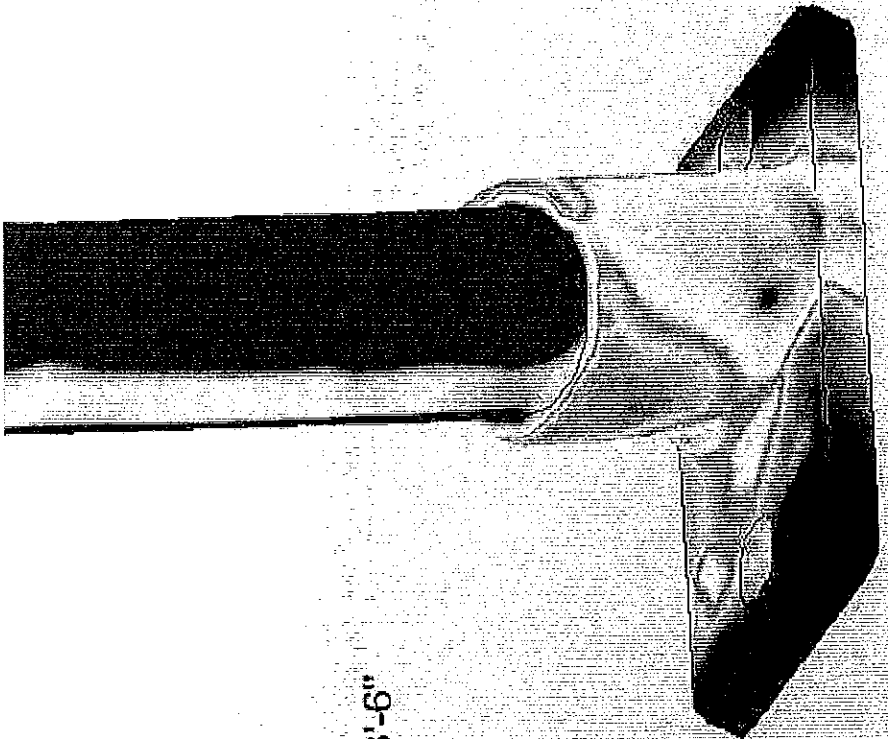

MBA

TABLE 11

STAINLESS STEEL - Alloy Groups 1, 2 and 3, Condition CW												
Nominal Thread Diameter & Thread/inch	D Nominal Thread Diameter (inch)	A(S) Tensile Stress Area (Sq. In.)	A(F) Thread Root Area (Sq. In.)	Allowable Tension (Pounds)	Allowable Shear		Bearing (Pounds)			Minimum Material Thickness to Equal Tensile Capacity of Fastener (In.)		
					Single (Pounds)	Double (Pounds)	1/8" St. A36	1/8" Al. 6063-T5	1/8" Al. 6063-T6	A36	6063-T5	6063-T6
#6-32	0.1380	0.0091	0.0078	394	100	360	1201	270	414	0.128	0.274	0.190
#8-32	0.1640	0.0140	0.0124	560	286	573	1427	328	492	0.182	0.368	0.261
#10-24	0.1900	0.0175	0.0152	760	351	702	1853	390	570	0.170	0.372	0.287
#12-24	0.2160	0.0242	0.0214	1059	494	988	1879	432	648	0.200	0.450	0.321
1/4-20	0.2500	0.0318	0.0280	1273	617	1233	2175	500	750	0.226	0.541	0.380
5/16-18	0.3125	0.0524	0.0469	2098	1063	2166	2719	625	938	0.284	---	0.459
3/8-16	0.3750	0.0775	0.0699	3100	1614	3229	3262	750	1125	0.341	---	0.553
7/16-14	0.4375	0.1053	0.0961	4252	2219	4439	3606	874	1311	0.395	---	0.642
1/2-13	0.5000	0.1419	0.1292	5876	2964	5967	4350	1000	1500	0.496	---	0.745
9/16-12	0.5625	0.1819	0.1684	7270	3843	7688	4894	1125	1808	0.510	---	0.836
5/8-11	0.6250	0.2280	0.2071	9040	4783	9566	6437	1290	1875	0.563	---	0.923
3/4-10	0.7500	0.3345	0.3091	11289	6023	12046	6525	1500	2250	0.590	---	0.983
7/8-9	0.8750	0.4617	0.4286	16592	8352	16703	7612	1750	2625	0.688	---	1.123
1-8	1.0000	0.6357	0.5630	20442	10970	21941	8700	2000	3000	0.778	---	1.276

	<p>DIAMETER Up Thru 5/8" 3/4" and Over:</p>	
F_u (Min. Ultimate Tensile Strength)	100,000 psi 85,000 psi	$A(F) = 0.7854 \left(D - \frac{1.2289}{N} \right)^2$
F_y (Min. Tensile Yield Strength)	65,000 psi 45,000 psi	$A(S) = 0.7854 \left(D - \frac{0.8743}{N} \right)^2$
F_t (Allowable Tensile Stress)	40,000 psi 33,750 psi	<p>For Diameters Up Thru 5/8":</p> $F_t = 0.40 F_u$ Allowable tension = $0.40 F_u [A(S)]$ $F_v = \frac{0.40}{\sqrt{3}} F_u$ Allowable shear (Single) = $\frac{0.40}{\sqrt{3}} F_u [A(F)]$
F_s (Allowable Shear Stress)	25,000 psi 19,406 psi	<p>For Diameters 3/4" and Over:</p> $F_t = 0.75 F_y$ Allowable tension = $0.75 F_y [A(S)]$ $F_v = \frac{0.75}{\sqrt{3}} F_y$ Allowable shear (Single) = $\frac{0.75}{\sqrt{3}} F_y [A(F)]$

In Tables 9 thru 15, for Group Type and Condition Definitions see pages 22 and 23.

TABLE 27 TEKS

STAINLESS STEEL - Alloy Groups 1, 2 and 3, Condition CW												
Nominal Thread Diameter & Thread/inch	D Nominal Thread Diameter (inch)	K Basic Minor Diameter (inch)	A(F) Thread Root Area (Sq. In.)	Allowable Tension (Pounds)	Allowable Shear		Bearing (Pounds)			Minimum Material Thickness to Equal Tensile Capacity of Fastener (In.)		
					Single (Pounds)	Double (Pounds)	1/8" St. A36	1/8" Al. 6063-T5	1/8" Al. 6063-T6	A36	6063-T5	6063-T6
#8-20	0.1380	0.0997	0.0078	312	100	360	1201	270	414	0.112	0.240	0.174
#8-18	0.1640	0.1257	0.0124	496	293	573	1427	328	492	0.147	0.328	0.235
#10-16	0.1900	0.1399	0.0152	608	351	702	1853	390	570	0.153	0.328	0.238
#12-14	0.2160	0.1849	0.0214	856	494	988	1879	432	648	0.182	0.403	0.299
1/4-14	0.2500	0.1837	0.0280	1120	617	1233	2175	500	750	0.205	0.459	0.323
5/16-12	0.3125	0.2443	0.0469	1876	1063	2166	2719	625	938	0.250	0.627	0.416
3/8-12	0.3750	0.2943	0.0699	2798	1614	3229	3262	750	1125	0.313	0.783	0.598


F_u (Minimum Ultimate Tensile Strength)	100,000 psi	$A(F) = 7854 K^2$
F_y (Minimum Tensile Yield Strength)	65,000 psi	Allowable tension = $0.40 F_u [A(F)]$ $F_v = \frac{0.40}{\sqrt{3}} F_u$ Allowable shear (Single) = $\frac{0.40}{\sqrt{3}} F_u [A(F)]$
		Where: A(F) = Thread Root Area, sq. in. K = Basic Minor Diameter, in.

RICE <i>ENGINEERING</i>	105 School Creek Trail Luxemburg, WI 54217 Phone: (920)845-1042 Fax: (920)845-1048 www.rice-inc.com	Project Description: RMR 80KD System	Job No: R11-10-240
			Engineer: JDB Sheet No: S1
			Date: 10/24/11 Rev:
	Template: REI-MC-5200		Chk By:

304 SS & CARBON TAPPERS

PRODUCT REPORT No. 040601

Selector Guide

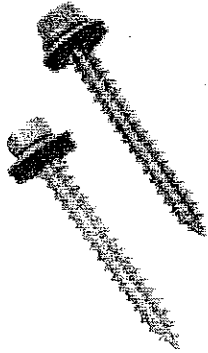

Carbon Steel Electro-Zinc Part #	304 Series Electro-Zinc Part #	Description	Carbon Steel Box Qty	304 SS Box Qty
1874200	1863000	14 x 3/4" HWH W/ BD Type A Tappers	2,500	2,500
1875200	1864000	14 x 1" HWH W/ BD Type A Tappers	2,500	2,500
1877200	1866000	14 x 1-1/2" HWH W/ BD Type A Tappers	2,000	2,000
1879200	--	14 x 2" HWH W/ BD Type A Tappers	1,500	1,500
1880200	--	14 x 2-1/2" HWH W/ BD Type A Tappers	1,000	1,000
1881200	--	14 x 3" HWH W/ BD Type A Tappers	1,000	750
1886200	--	17 x 3/4" HWH W/ BD Type A Tappers	2,500	2,000
1887200	--	17 x 1" HWH W/ BD Type A Tappers	--	2,000

Performance Data

with Bonded Washer		PULLOUT VALUES (avg. lbs. ultimate)							
Fastener		Gauge	26	24	22	20	18	16	14
14	Type A	Thickness	0.018	0.024	0.030	0.036	0.048	0.060	0.075
		Drill Size	1/8"	5/32"	5/32"	3/16"	3/16"	#7	#7
			191	252	336	371	545	694	884
Fastener		Gauge	26	24	22	20	18	16	14
17	Type A	Thickness	0.018	0.024	0.030	0.036	0.048	0.060	0.075
		Drill Size	1/8"	5/32"	5/32"	3/16"	#2	#2	1/4"
			263	307	425	475	559	791	

with Bonded Washer		SHEAR VALUES (avg. lbs. ultimate)					
Fastener		Gauge	26-14	24-14	22-14	20-14	18-14
14	Type A	Drill Size	#7	#5	#2	#2	0.234"
			534	704	863	1245	2120
Fastener		Gauge	26-18	24-18	22-14	20-14	18-14
17	Type A	Drill Size	#2	1/4"	1/4"	1/4"	1/4"
			454	1013	1264	1544	1294

with Bonded Washer		PULLOVER VALUES (avg. lbs. ultimate)							
Fastener		Gauge	26	24	22	20	18	16	14
14	Type A	Thickness	0.018	0.024	0.030	0.036	0.048	0.060	0.075
		Drill Size	1/8"	5/32"	5/32"	3/16"	3/16"	#7	#7
			595	827	1093	1341	1931	2229	2696
Fastener		Gauge	26	24	22	20	18	16	14
17	Type A	Thickness	0.018	0.024	0.030	0.036	0.048	0.060	0.075
		Drill Size	1/8"	5/32"	5/32"	3/16"	#2	#2	1/4"
			565	792	970	1100	1556	1813	2065

304 SS FASTENER VALUES (avg. lbs. ultimate)			
Fastener (dia-tpi)	Tensile (lbs min.)	Shear (avg. lbs ult.)	Torque (min. in lbs)
14-10	2684	2148	127
17-9	N/A	N/A	229

CARBON STEEL FASTENER VALUES (avg. lbs. ultimate)			
Fastener (dia-tpi)	Tensile (lbs min.)	Shear (avg. lbs ult.)	Torque (min. in lbs)
14-10	4060	2600	150
17-9	5000	2750	173

Tools and Techniques

- A standard screwgun with a depth sensitive nosepiece should be used to install Tappers. For optimal fastener performance, the screwgun should be a minimum of 6 amps and have an RPM range of 0-2500.
- Adjust the screwgun nosepiece to properly seat the fastener.
- New magnetic sockets must be correctly set before use. Remove chip build-up as needed.

- The fastener is fully seated when the head is flush with the work surface.
- Overdriving may result in torsional failure of the fastener or stripout of the substrate.
- The fastener must penetrate beyond the metal structure a minimum of 3 pitches of thread.



1349 West Bryn Mawr Avenue
Itasca, Illinois 60143
630-595-3500 Fax: 630-595-3549
www.itwbuildex.com

© 2007 ITW Buildex and Illinois Tool Works, Inc.

HIT-HY 150 MAX Adhesive Anchoring System 4.2.4

HIT-HY 150 MAX Allowable Loads for Threaded Rods in Grout-Filled Concrete Masonry Units (ASTM C 90 Block) 1, 2, 3, 4

Anchor Diameter in. (mm)	Embedment Depth in. (mm)	Distance from Edge in. (mm)	Tension ⁵ lb (kN)	Shear ⁵ lb (kN)
3/8 (9.5)	3-3/8 (86)	4 (101.6)	1100 (4.9)	1419 (6.3)
		≥ 20 (508)	1188 (5.3)	1419 (6.3)
1/2 (12.7)	4-1/2 (114)	4 (101.6)	1319 (5.9)	2181 (9.7)
		≥ 20 (508)	1581 (7.0)	2338 (10.4)
5/8 (15.9)	5-5/8 (143)	4 (101.6)	1713 (7.6)	2650 (11.8)
		≥ 20 (508)	2313 (10.3)	3238 (14.4)
3/4 (19.1)	6-3/4 (172)	4 (101.6)	1975 (8.8)	2756 (12.3)
		≥ 20 (508)	3050 (13.6)	3481 (15.5)

HIT-HY 150 MAX Ultimate Loads for Threaded Rods in Grout-Filled Concrete Masonry Units (ASTM C 90 Block) 1, 2, 3, 4

Anchor Diameter in. (mm)	Embedment Depth in. (mm)	Distance from Edge in. (mm)	Tension ⁵ lb (kN)	Shear ⁵ lb (kN)
3/8 (9.5)	3-3/8 (86)	4 (101.6)	4400 (19.6)	5675 (25.2)
		≥ 20 (508)	4750 (21.1)	5675 (25.2)
1/2 (12.7)	4-1/2 (114)	4 (101.6)	5275 (23.5)	8725 (38.8)
		≥ 20 (508)	6325 (28.1)	9350 (41.6)
5/8 (15.9)	5-5/8 (143)	4 (101.6)	6850 (30.5)	10600 (47.2)
		≥ 20 (508)	9250 (41.1)	12950 (57.6)
3/4 (19.1)	6-3/4 (172)	4 (101.6)	7900 (35.1)	11025 (49.0)
		≥ 20 (508)	12200 (54.3)	13925 (61.9)

1 Values are for lightweight, medium weight or normal weight concrete masonry units conforming to ASTM C 90 with 1500 psi grout conforming to ASTM C 476.

2 Embedment depth is measured from the outside face of the concrete masonry unit.

3 Values are for anchors located in the grouted cell, head joint, bed joint, "T" joint, cross web or any combination of the above.

4 Values for edge distance between 4 inches and 20 inches can be calculated by linear interpolation.


5 Loads are based on the lesser of bond strength, steel strength or base material strength.

Anchor Spacing and Edge Distance Guidelines for Grout-Filled Block

Influence of Anchor Spacing and Edge Distance

Anchor Size	in. (mm)	3/8 (9.5)	1/2 (12.7)	5/8 (15.8)	3/4 (19.1)
h_{min}	in. (mm)	3-3/8 (86)	4-1/2 (114)	5-5/8 (143)	6-3/4 (172)

h_{min} = standard embedment depth

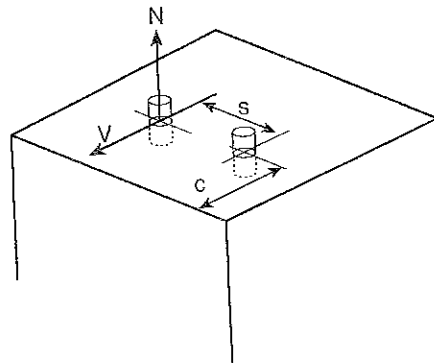


Edge Distance for Shear and Tension: Grout Filled, Normal Weight and Lightweight Block

$c_{s,t}$ = 20 in. (508 mm) minimum from free edge


$c_{s,t}$ = 4 in. (102 mm) minimum from free edge

Anchor Spacing for Shear and Tension: Grout Filled, Normal Weight and Lightweight Block


s_a = s_{min} = One (1) anchor per cell (max), and 8 in. (203mm) (min)

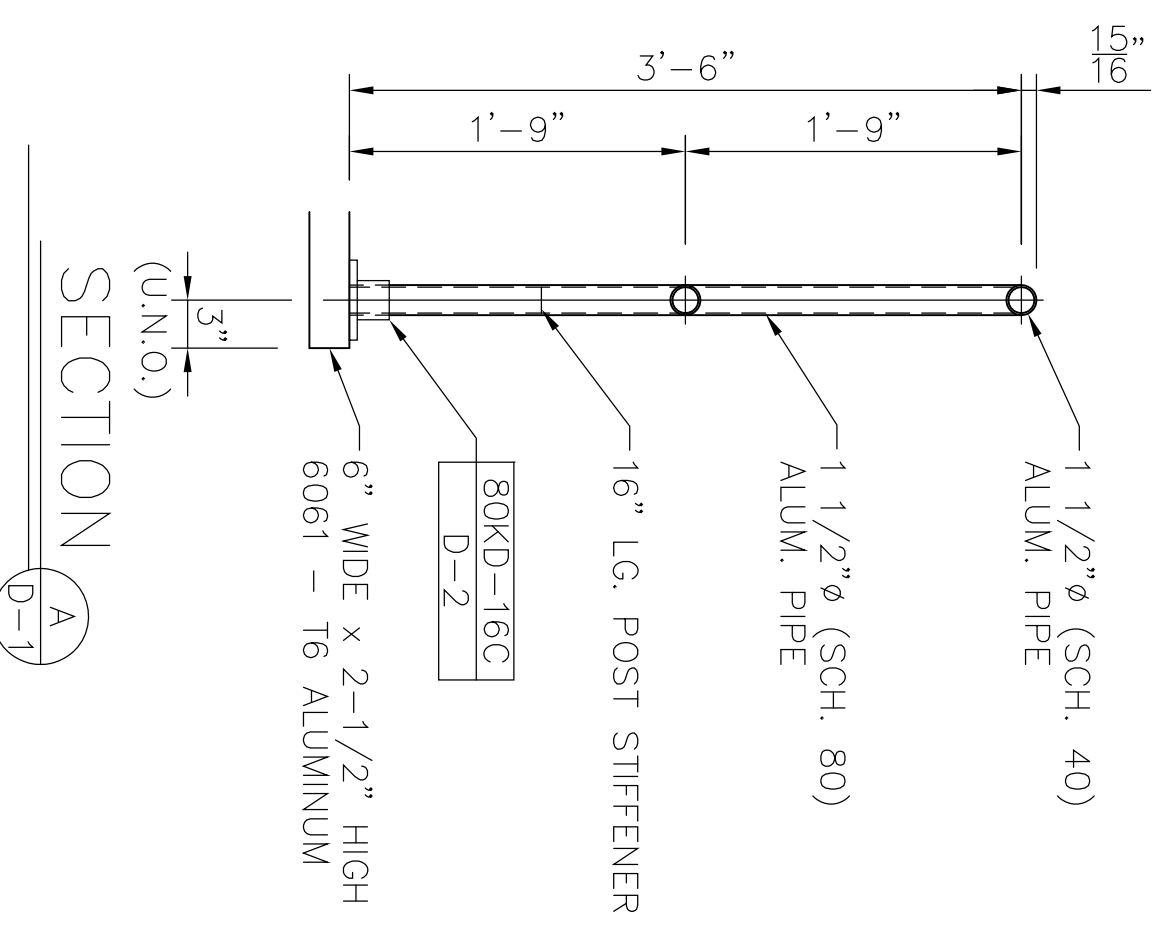


SECTION A
D-1

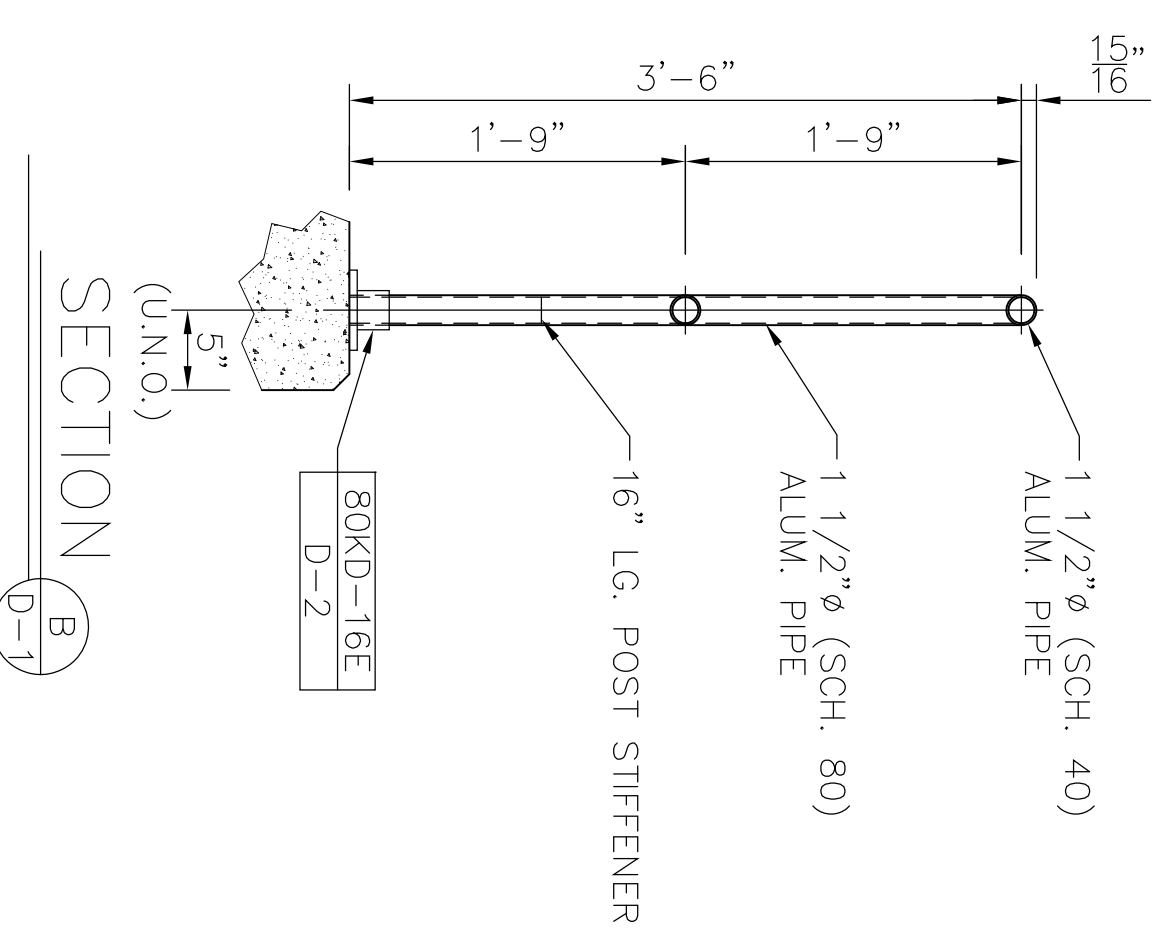


SECTION B
D-1

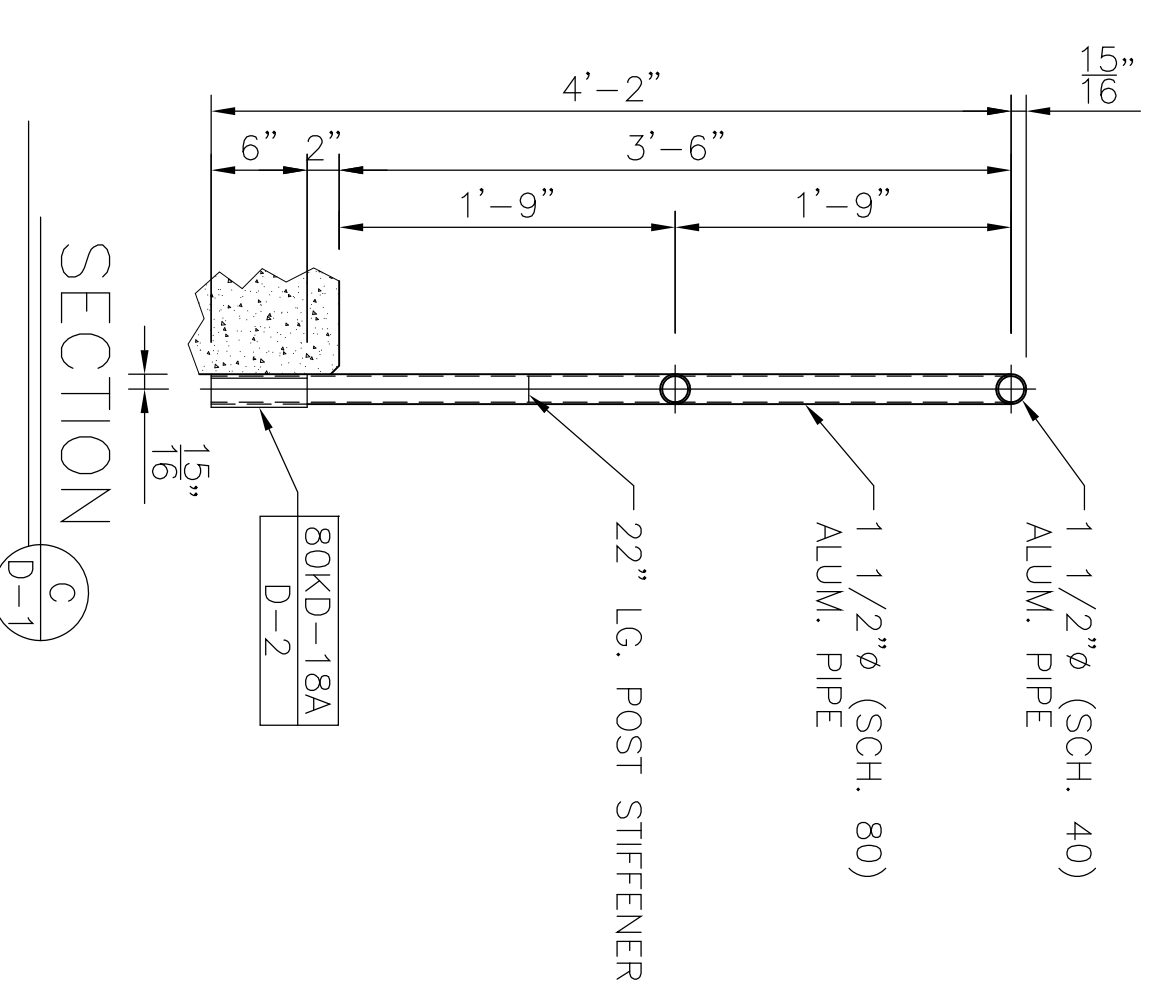


SECTION C
D-1

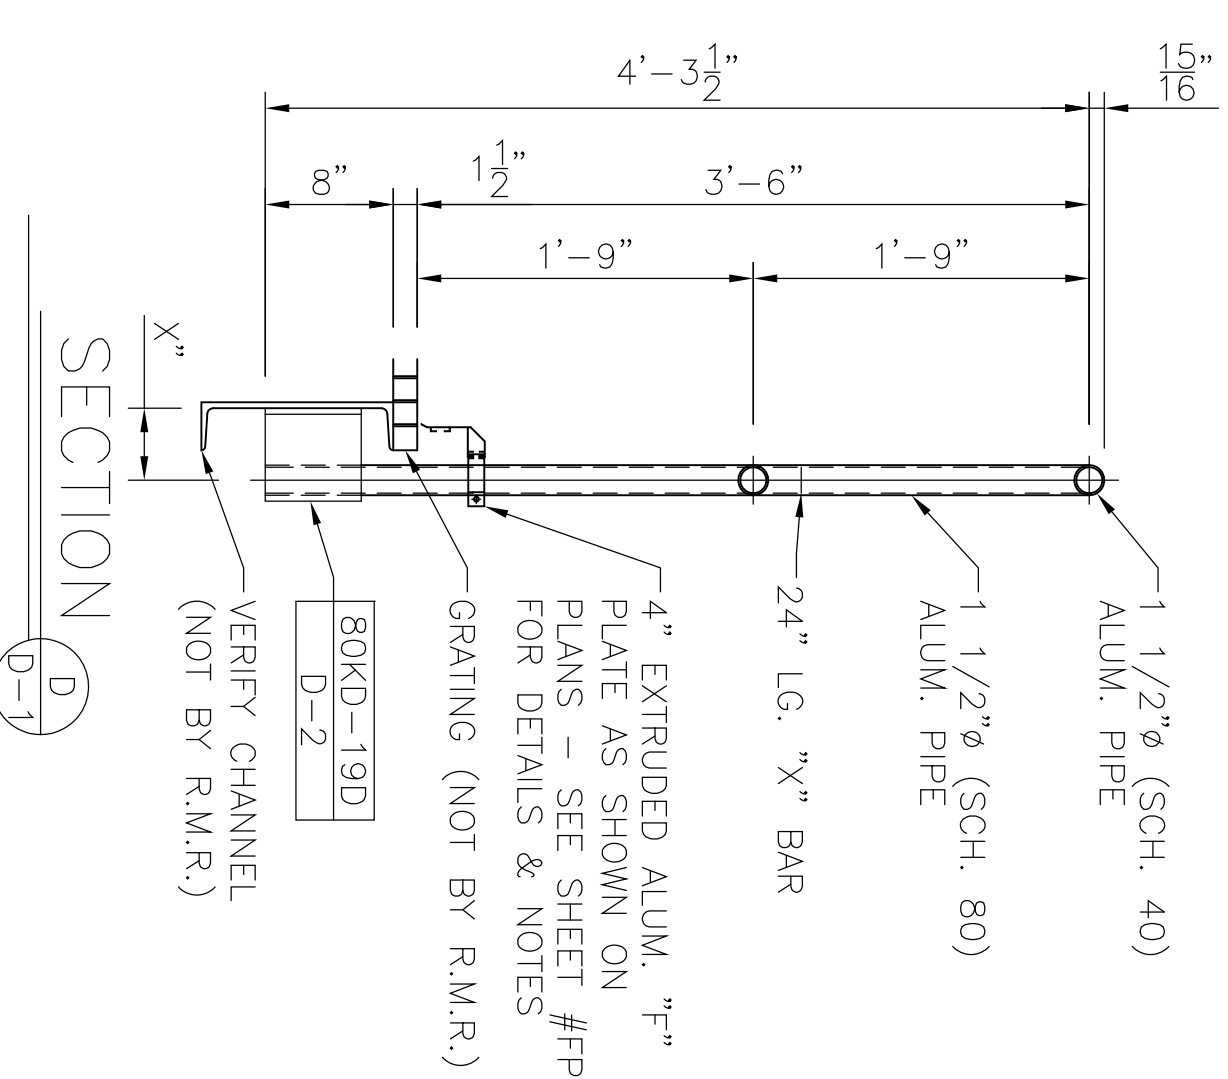


SECTION D
D-1

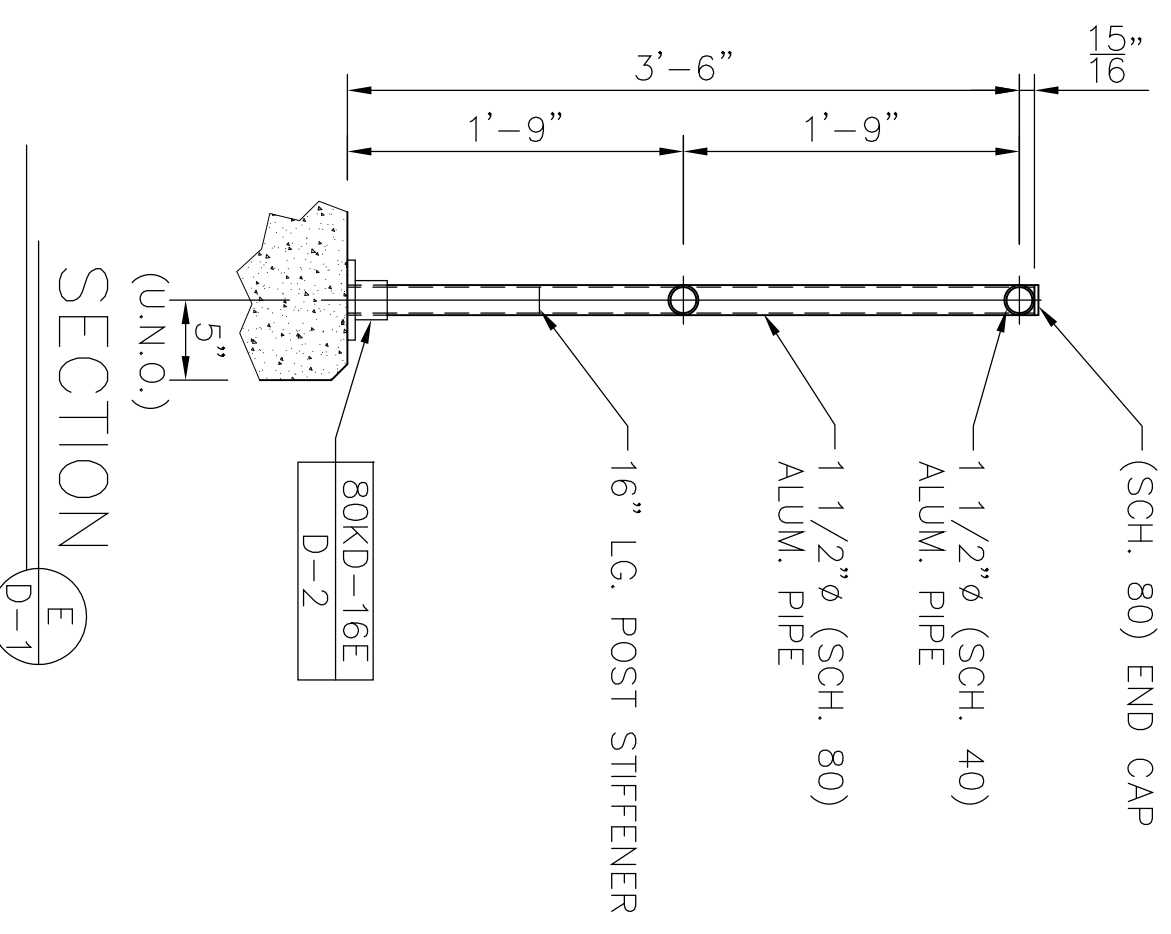

SECTION E
D-1

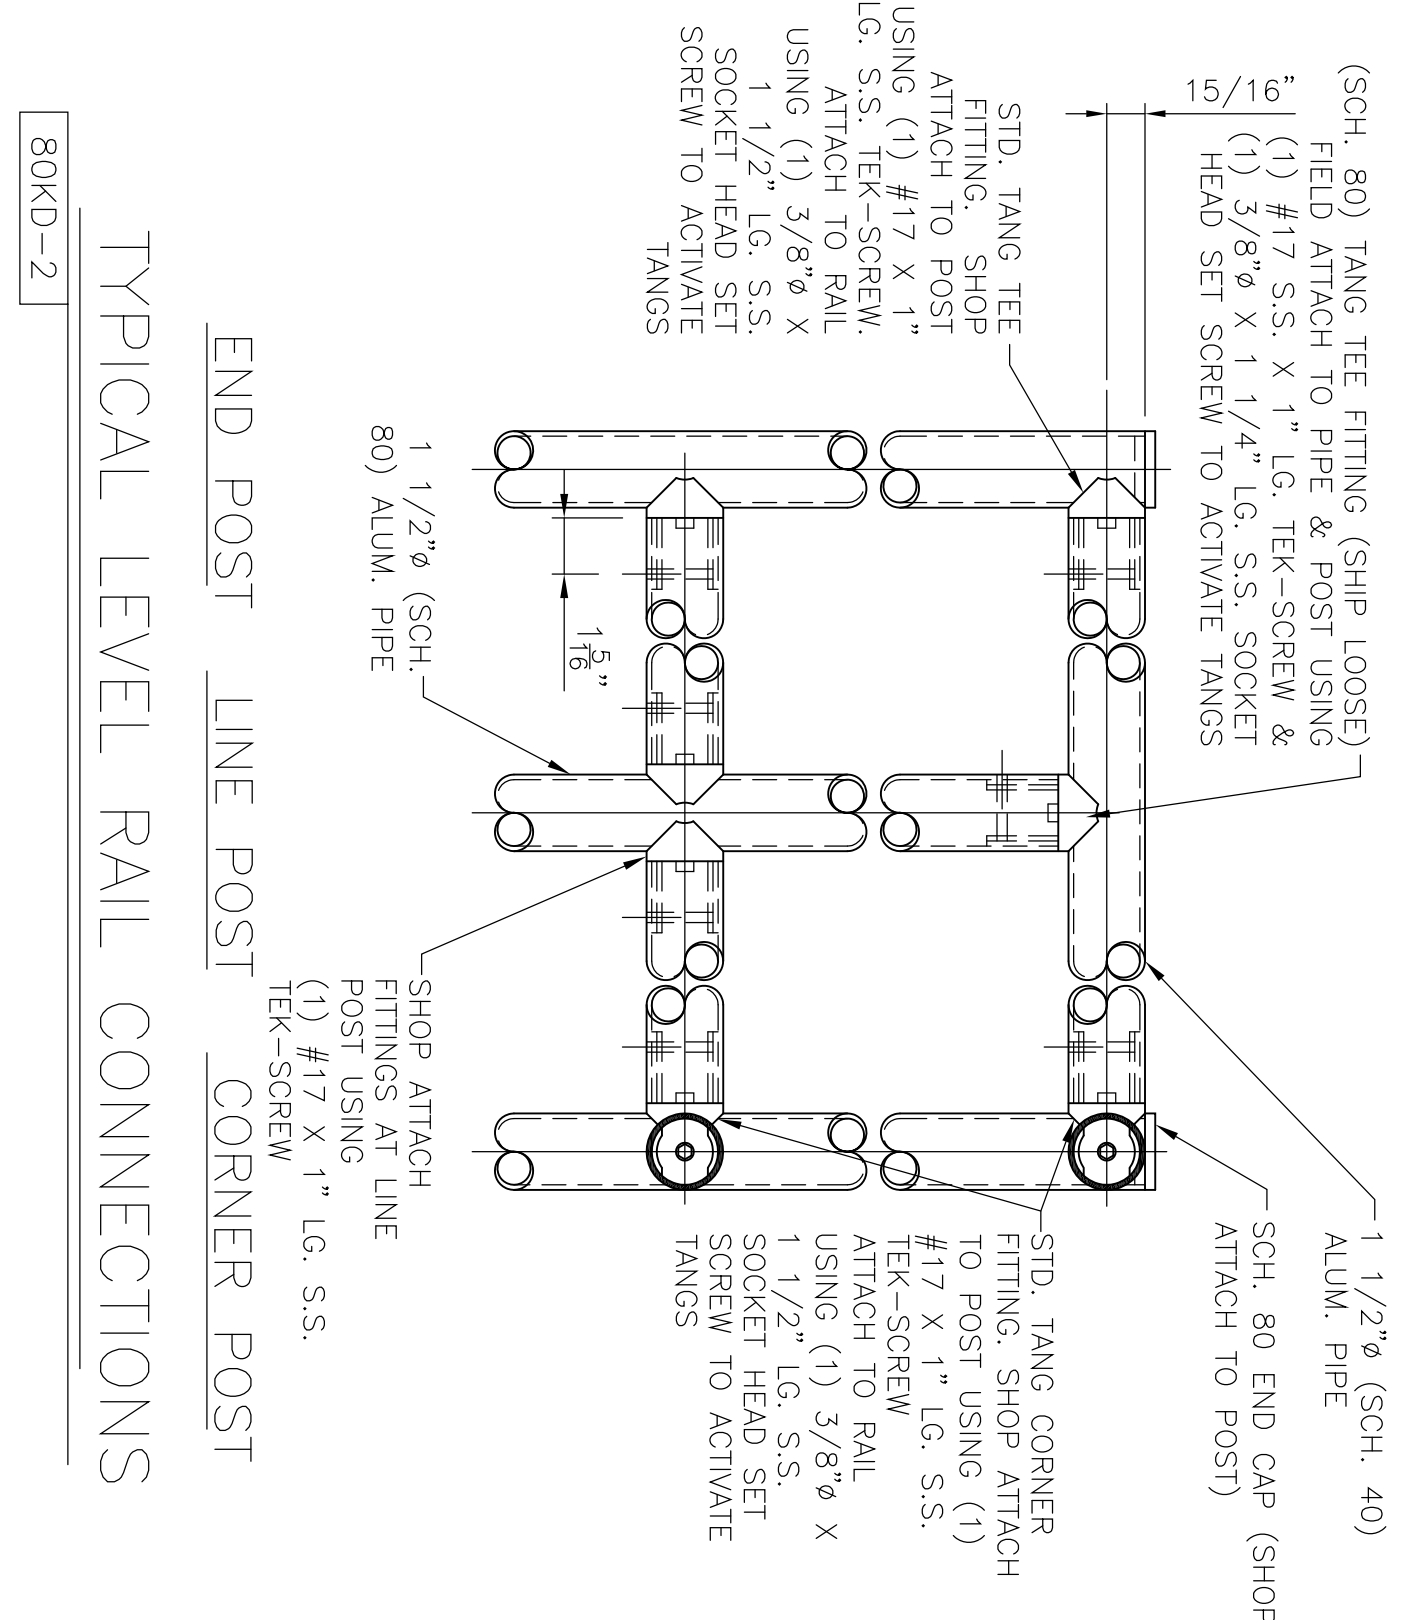


SECTION E
D-1

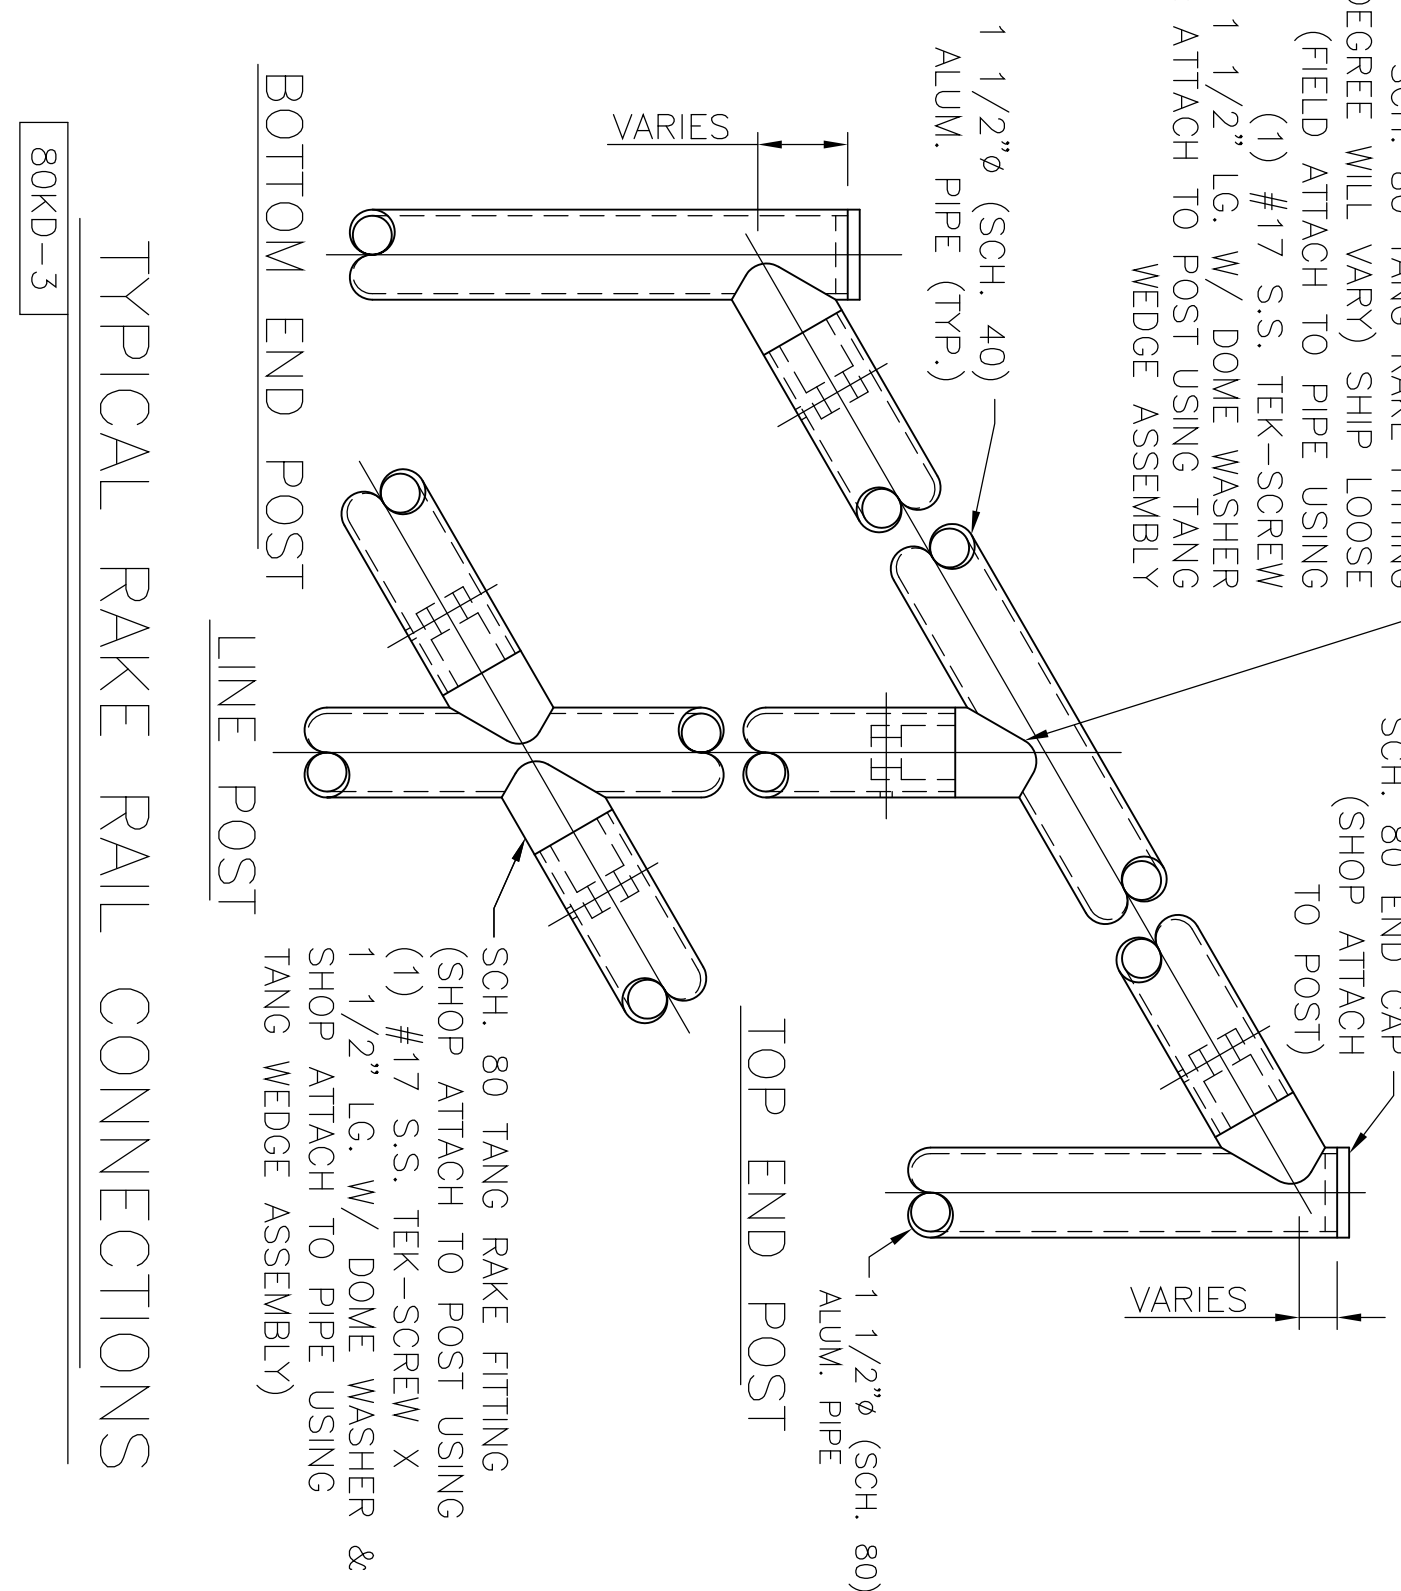


SECTION E
D-1

GENERAL NOTES:


- 1) ALL RAIL TO BE OF MECHANICAL CONSTRUCTION U.N.O.
- 2) ALL RAILS TO BE FABRICATED FROM 1 1/2" Ø (SCH. 40) ALUMINUM PIPE (6105-T5 ALLOY).
- 3) ALL POSTS TO BE FABRICATED FROM 1 1/2" Ø (SCH. 80) ALUMINUM PIPE (6105-T5 ALLOY).
- 4) ALL COMPONENTS TO BE 6105-T5 ALLOY.
- 5) ALL FASTENERS (SELF TAPPING SCREWS, MACHINE BOLTS, EXPANSION ANCHORS, ETC.) TO BE STAINLESS STEEL. (TYPE 304)
- 6) ALL RAILING SURFACES IN CONTACT WITH CONCRETE OR DISSIMILAR METALS SHALL RECEIVE ONE SHOP APPLIED COAT OF TMEGc SERIES 46-465.
- 7) ALL BOLTS USED TO MOUNT RAILINGS TO FLOORS, WALLS, STEEL, ETC. ARE BY RAILING MFR.
- 8) ALL KICK PLATES ("T" TYPE TOE BOARD) SHALL BE SHIPPED LOOSE IN 24"-0" LG. STOCK LENGTHS FOR FIELD CUTTING & DRILLING AS REQ'D.
- 9) ALL POSTS ARE FURNISHED CUT TO LENGTH WITH FITTINGS ATTACHED (EXCEPT FOR TOP FITTING AT LEVEL & RAKE LINE POSTS).
- 10) PIPE FOR STRAIGHT RAIL IS FURNISHED IN 24"-0" STOCK LENGTHS FOR CUTTING & DRILLING AS REQ'D.
- 11) ELBOWS W/ A 4" C/L RADIUS ARE FURNISHED AS REQ'D. & MUST BE FIELD CUT TO FIT FIELD CONDITIONS.
- 12) ALL RAILS WHEN PROPERLY INSTALLED SHALL MEET OR EXCEED OSHA REQUIREMENTS.
- 13) MAX. POST SPACING TO BE 6'-0" C/C.
- 14) ALL CURVED RAIL SHALL BE FABRICATED USING CURVED TOP & INTERMEDIATE RAILS.
- 15) ALL RAIL IS TO BE FINISHED IN ACCORDANCE WITH THE ALUMINUM ASSOCIATION'S DESIGNATION M10C22A41.

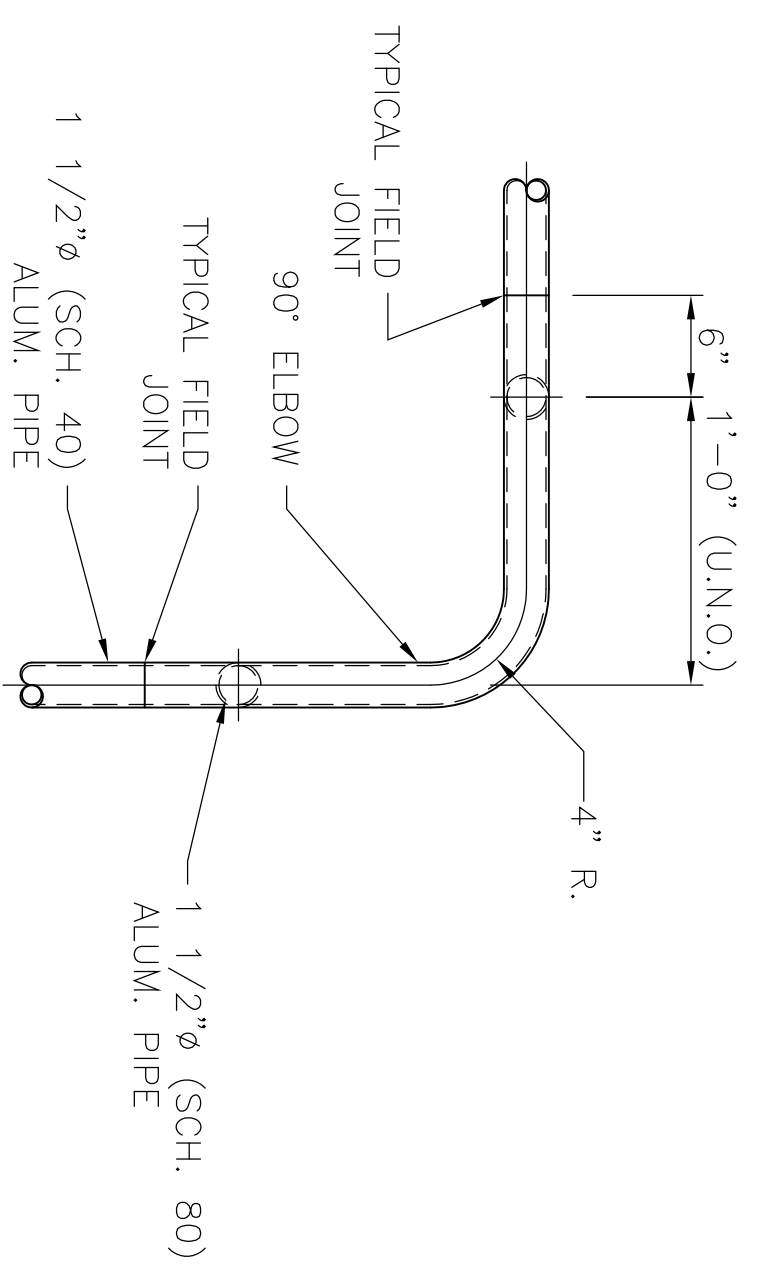

TYPICAL CORNER
BOKD-4

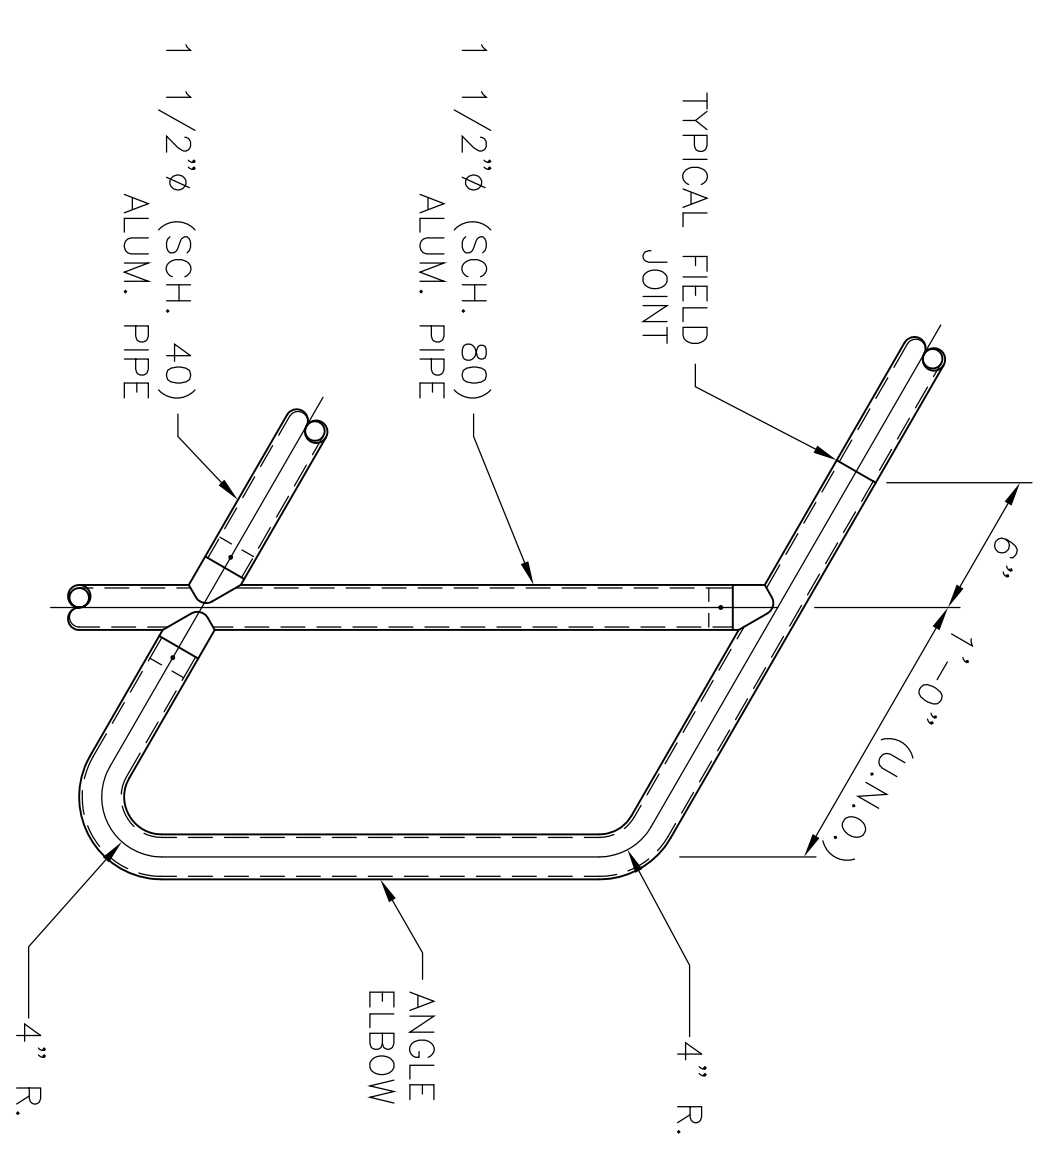

BOTTOM RAKE P-END
BOKD-5A

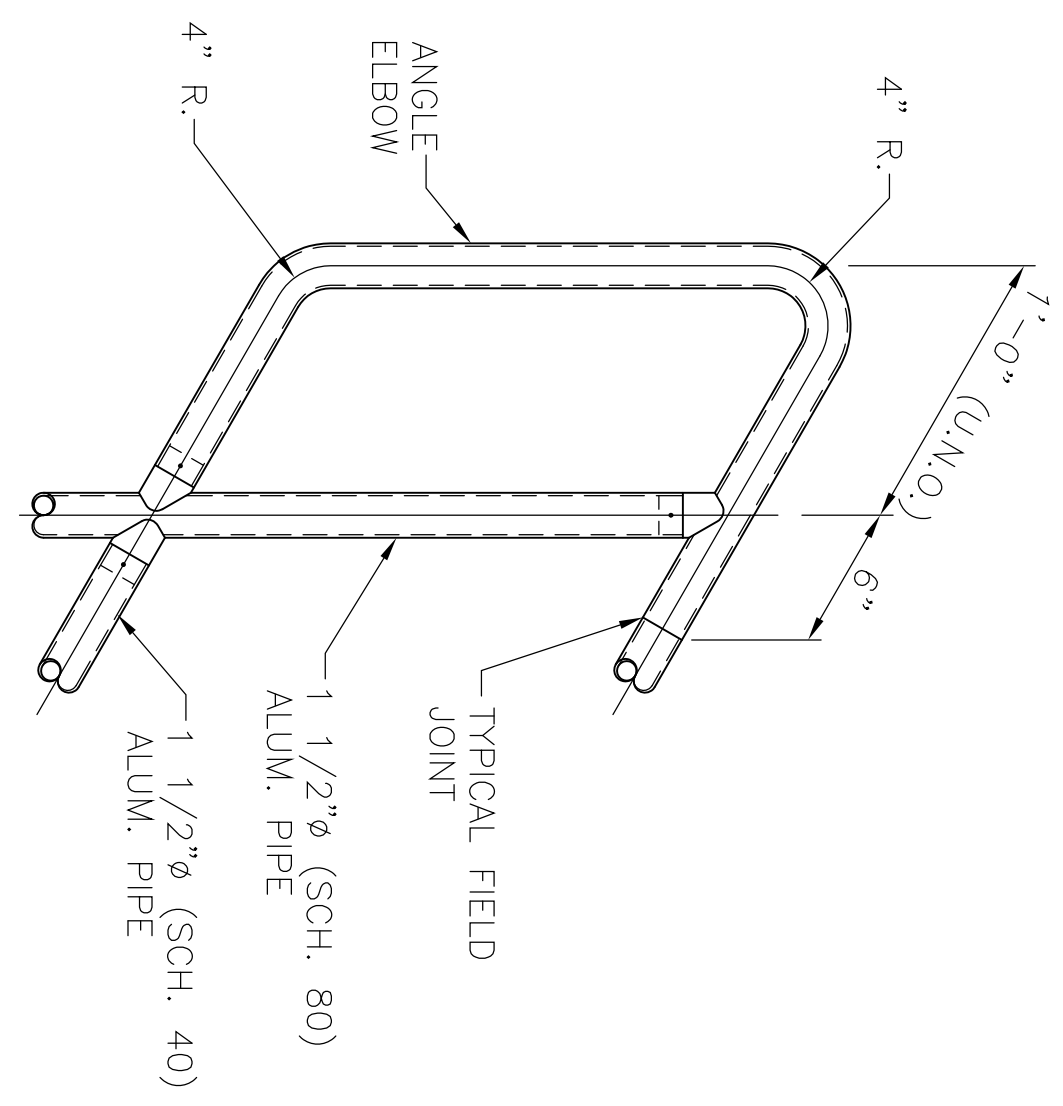


TOP RAKE P-END
BOKD-6A

ROCKY MOUNTAIN RAILINGS
11839 E 51st AVE DENVER, CO 80239 PHONE (303) 432-0033 FAX (303) 432-2038
HAROLD D. THOMPSON W.R.F. GSM, INC.
FOUNTAIN, CO. CUSTOMER: WEAYER CONSTRUCTION
DETAILS: 8000 KNOCK DOWN CONTRACTOR: M10C22A41
REVISION DATE 11/16/11 SCALE AS NOTED
BY DDB DATE 11/16/11 NO. 1
CHECKED BY OTHERS DATE 11/16/11 NO. 2
CUSTOMER P.O./JOB 2908-05470-C.O. #1


JOB NO. R2027
DRAWING NO. D-1

THESE DRAWINGS ARE THE PROPERTY OF TITLE ALUMINUM & BRONZE INC. THESE DRAWINGS AND SHALL NOT BE REPRODUCED OR COPIED OR USED AS THE BASIS FOR THE MANUFACTURE OF ANY OTHER STRUCTURE WITHOUT PERMISSION. THE CONTRACTOR ASSUMES FULL RESPONSIBILITY FOR THE PROTECTION AND MAINTENANCE OF THE DRAWINGS AND SPECIFICATIONS.

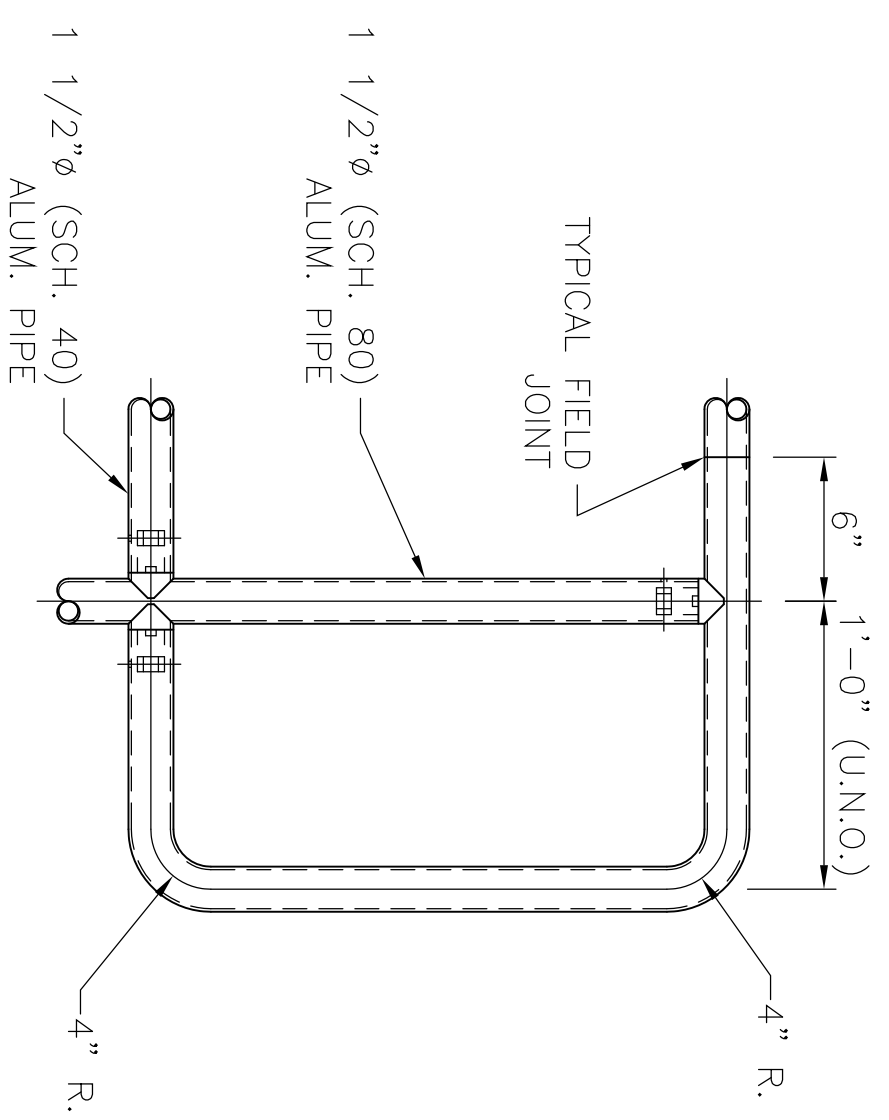


LEVEL P-END

80KD-7A

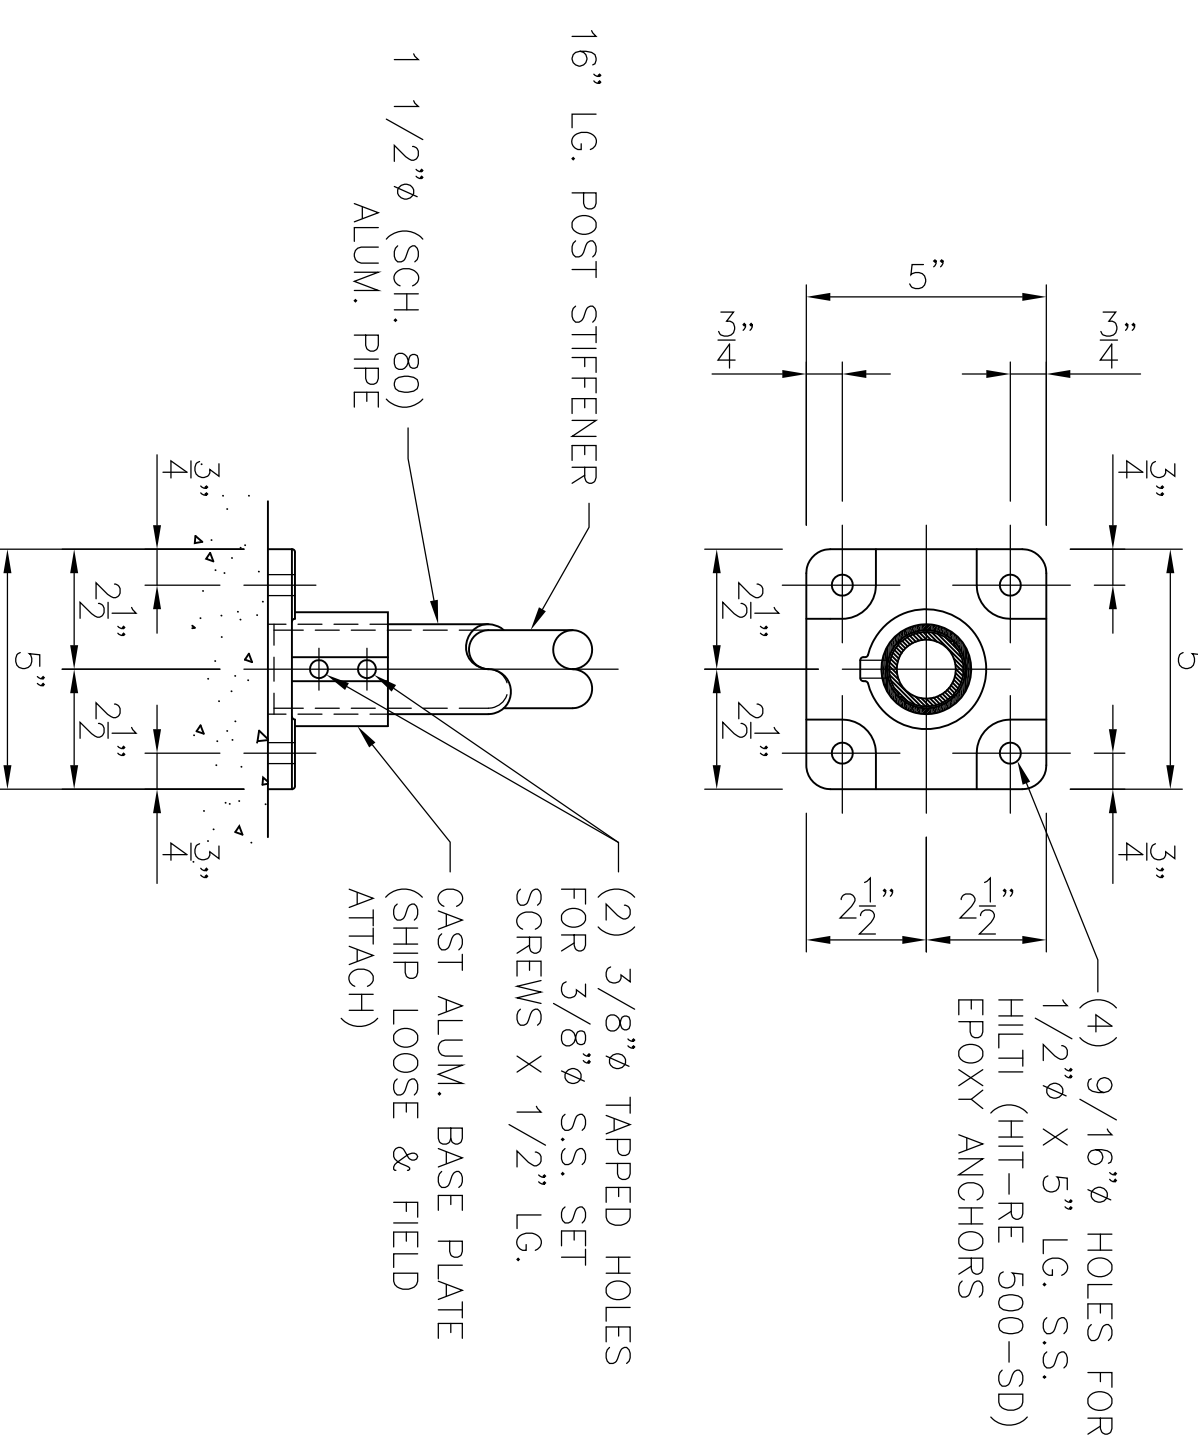


LEVEL CONC. LINE POST

80KD-16E

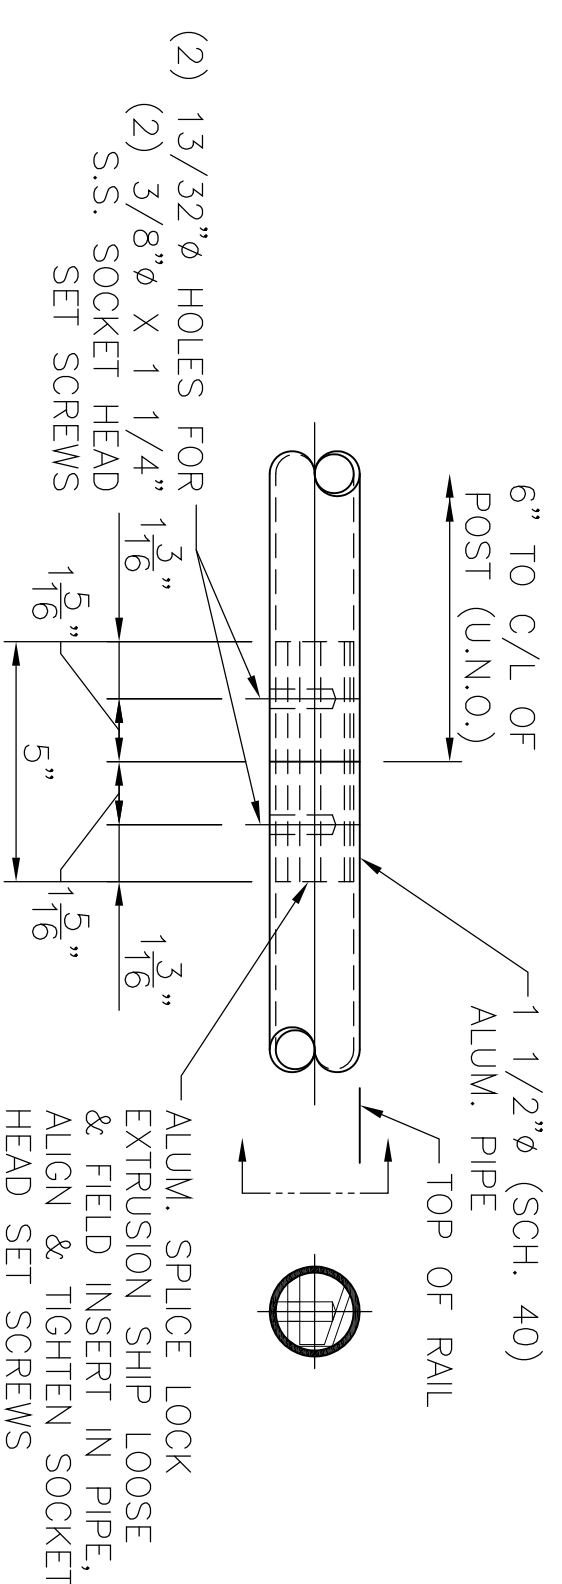


TYPICAL FIELD JOINT

80KD-8 (LOCATED ONLY WHERE NOTED)

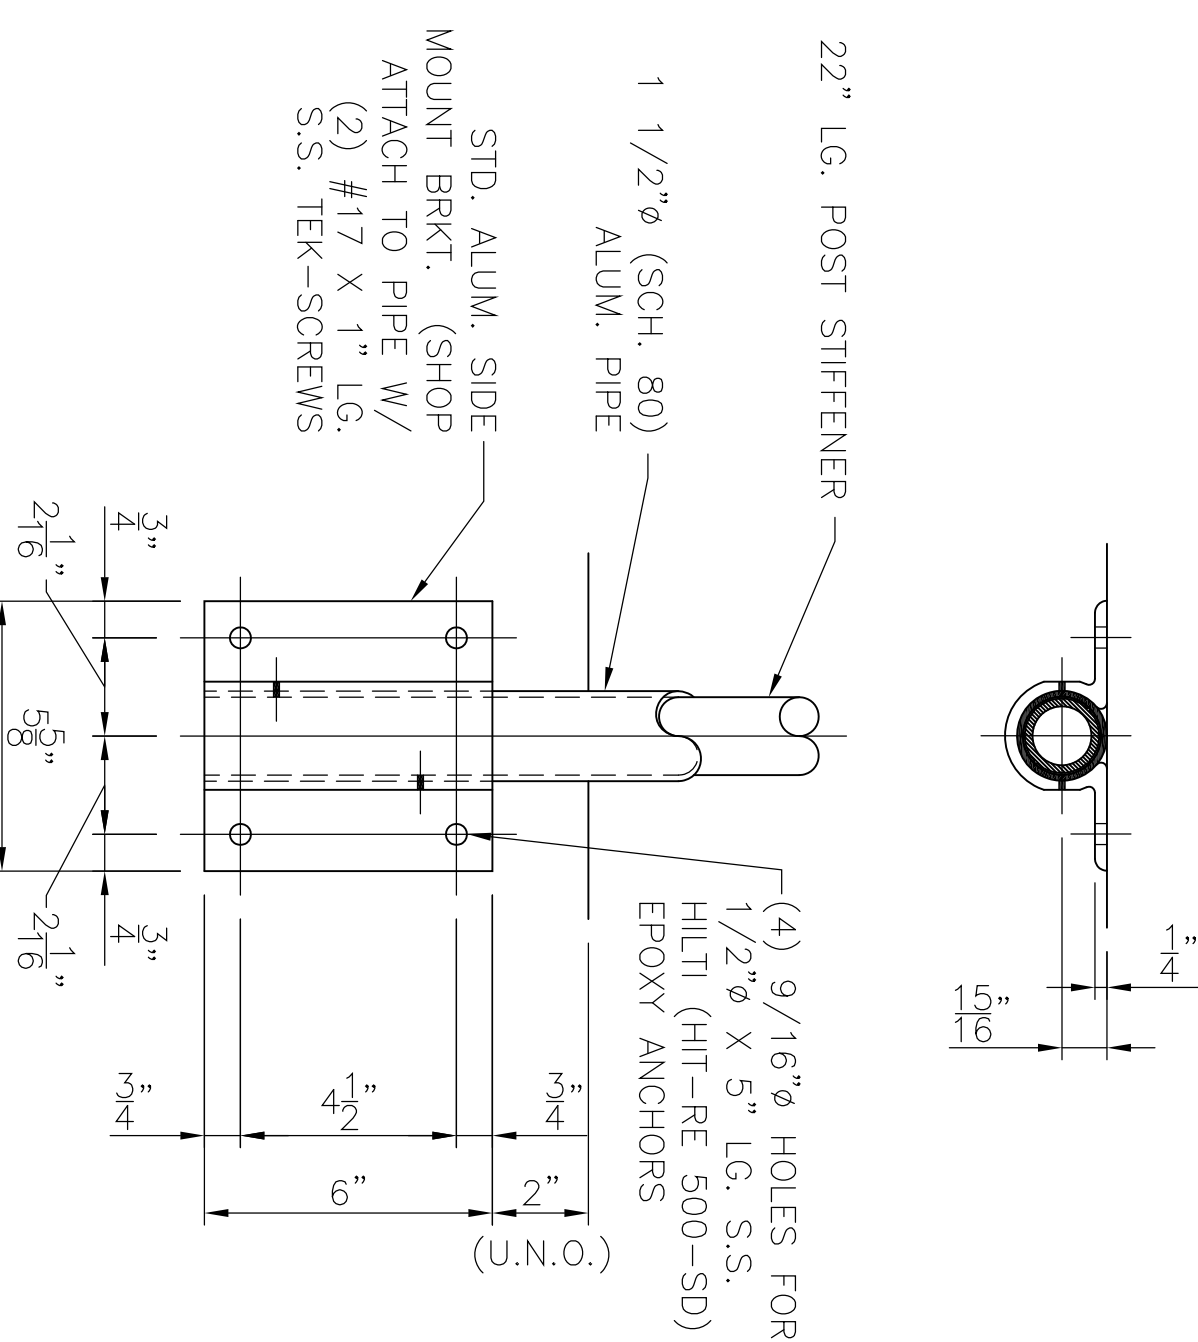


CONC. SIDE MOUNT 4-HOLE

80KD-18A

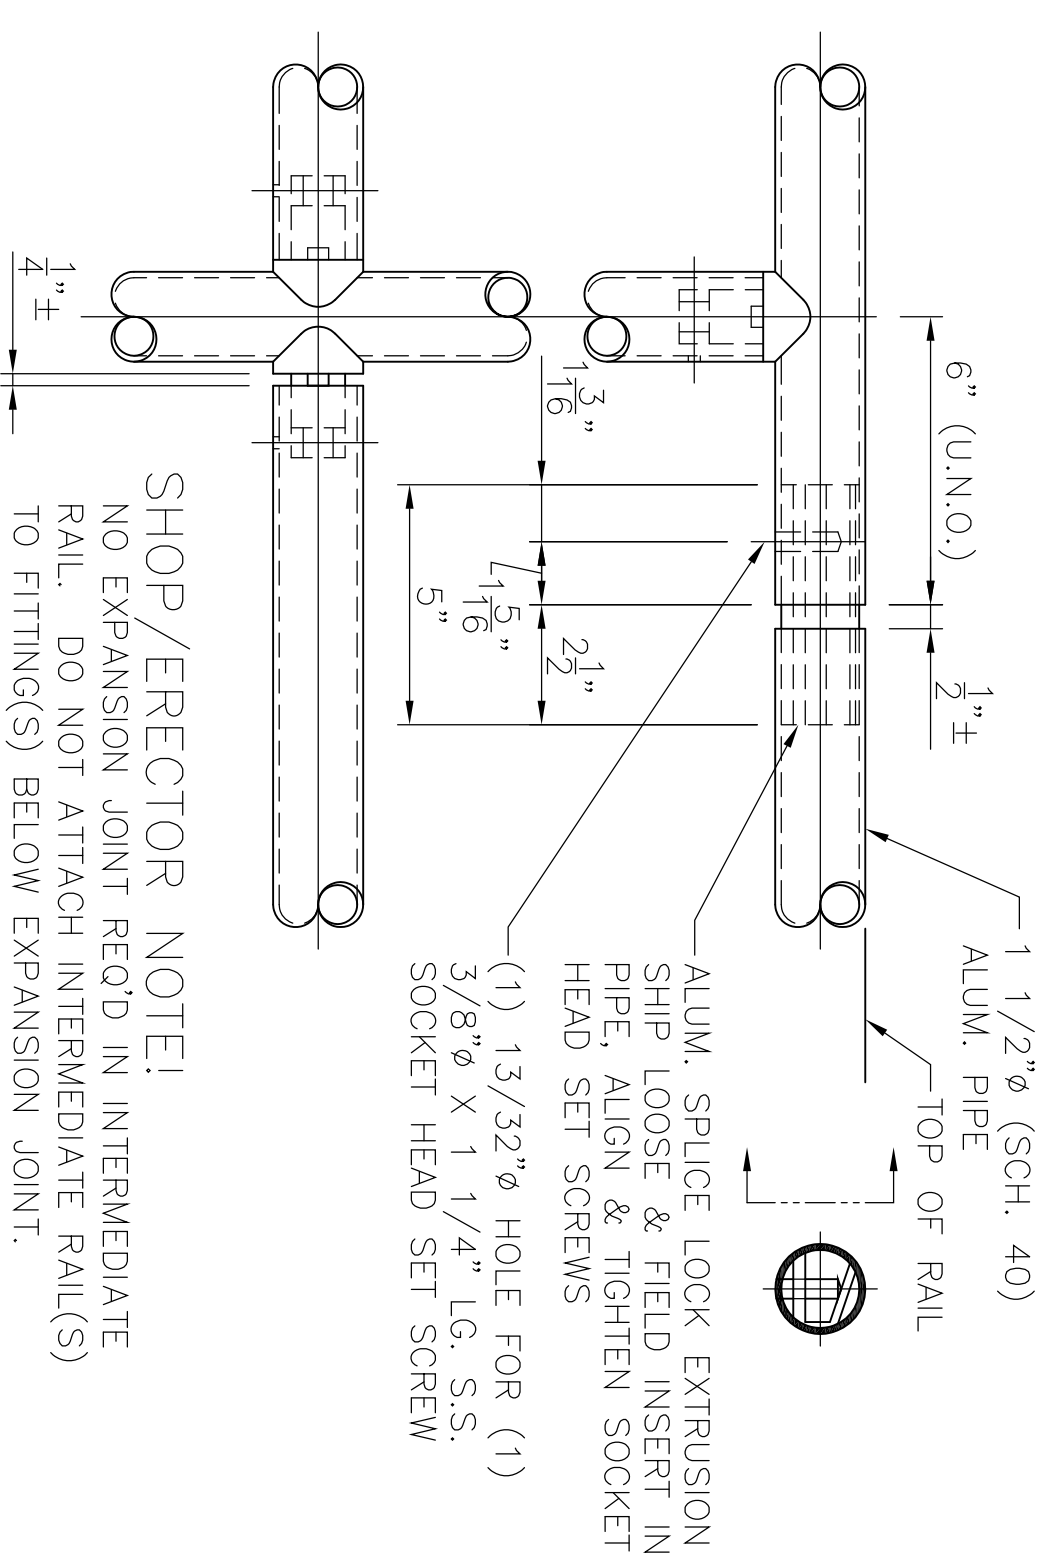


TYPICAL EXPANSION JOINT

80KD-9 (TYPICAL AT BUILDING EXPANSION JOINT & AT 24'-0" MAX. O/C)

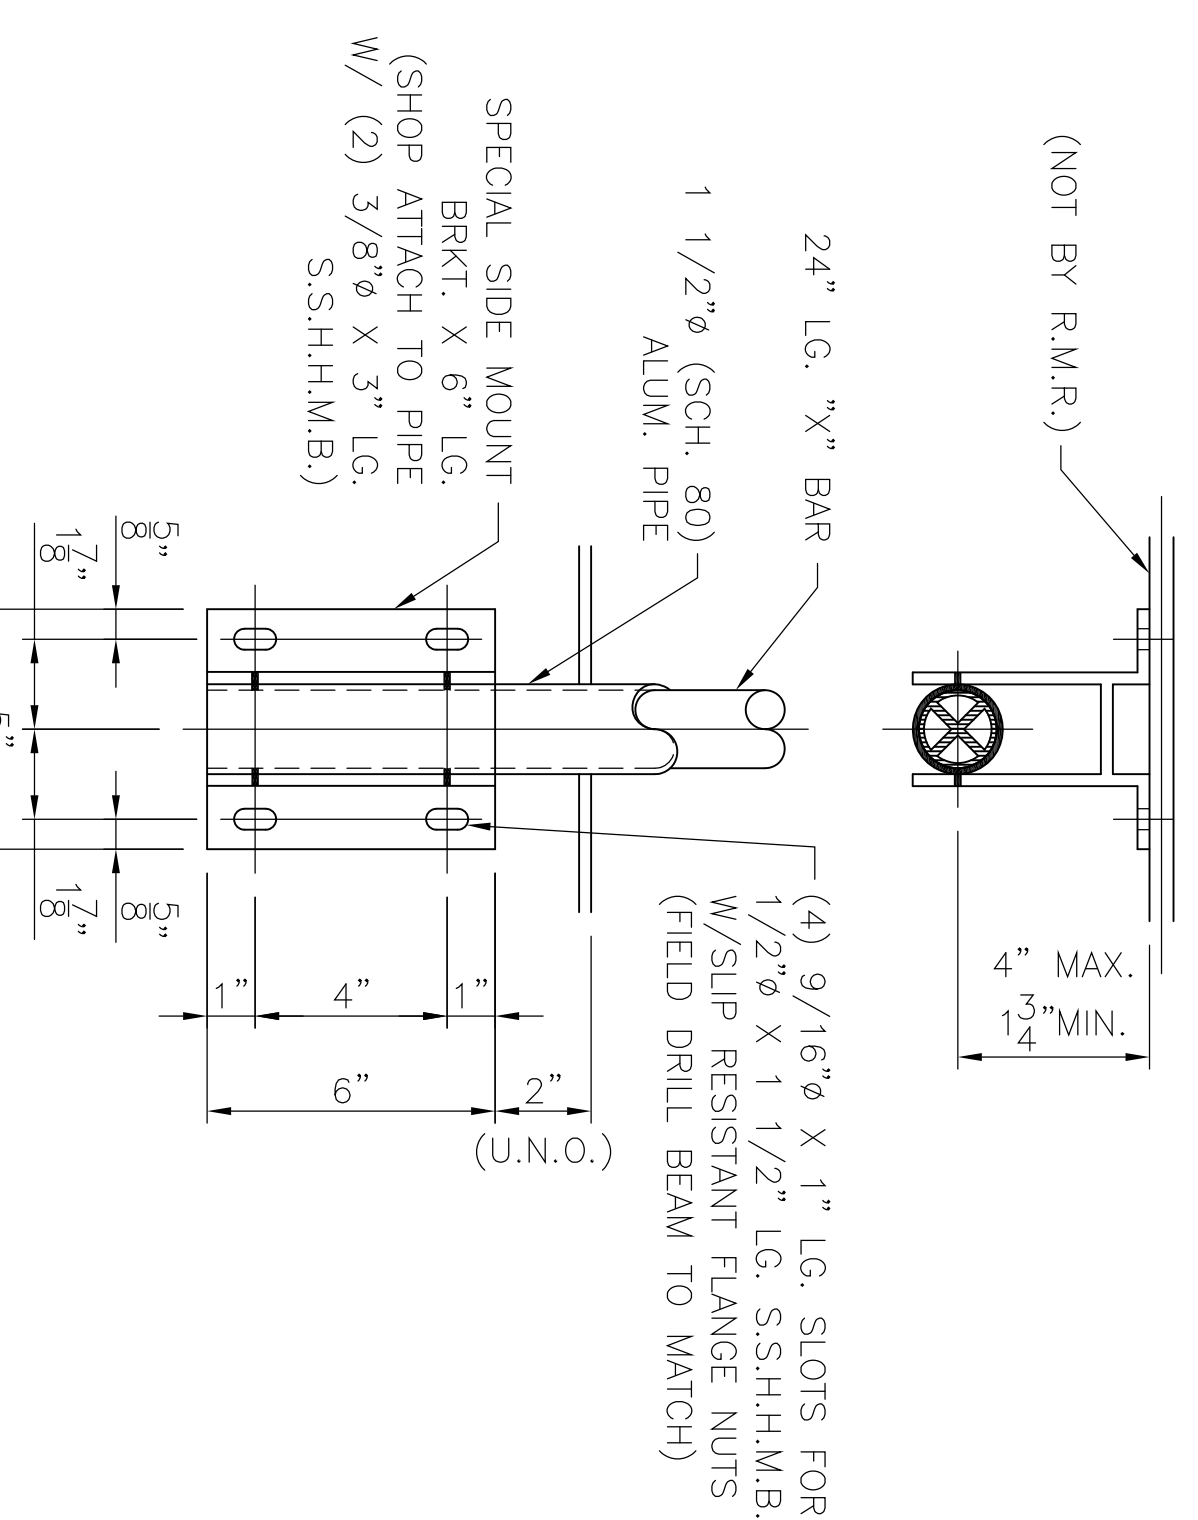


SPECIAL SIDE MOUNT 4-HOLE

80KD-19D

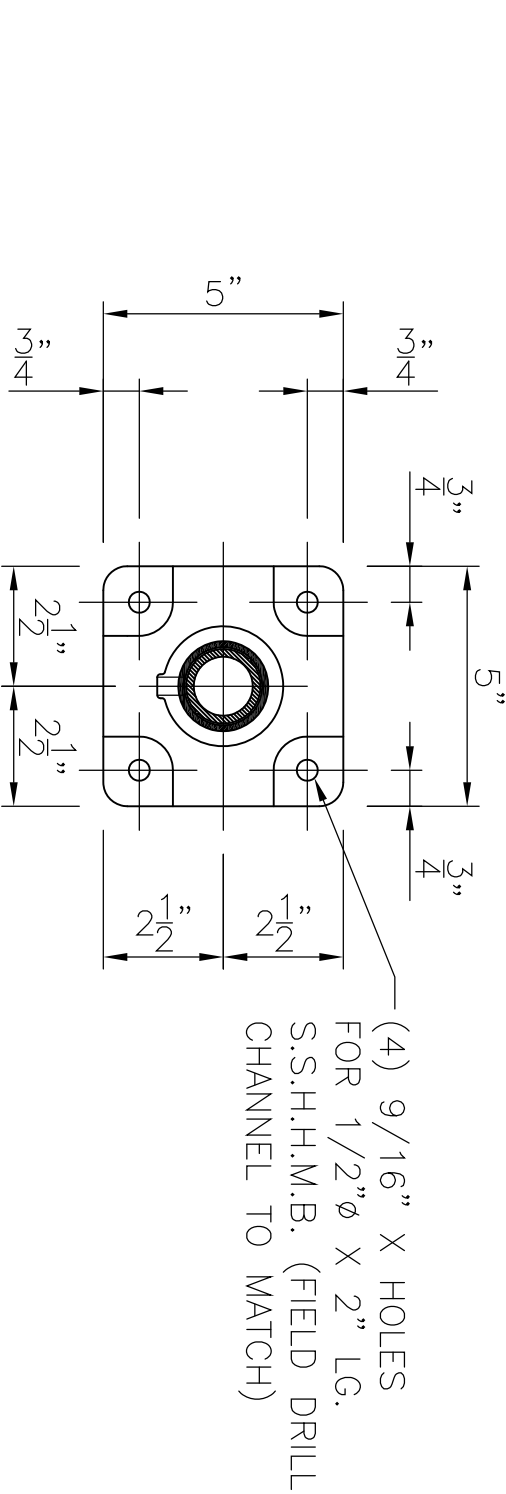


LEVEL METAL LINE POST

80KD-16C

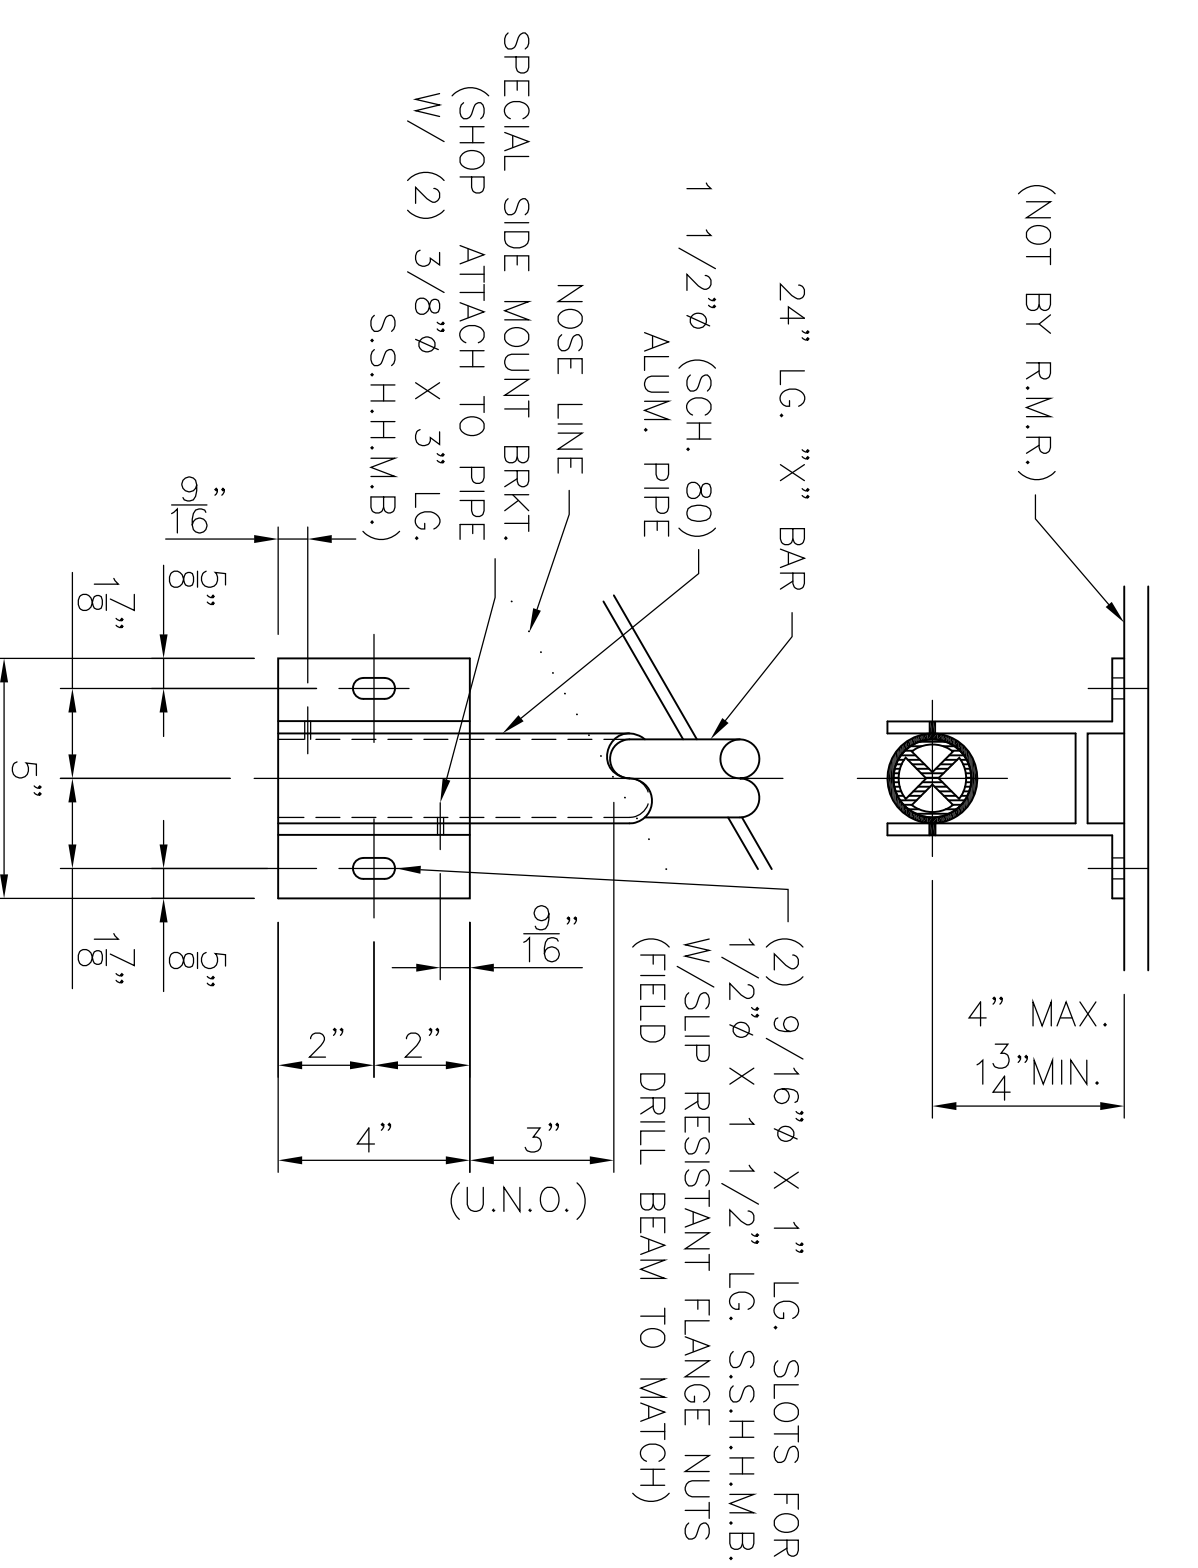

SPECIAL SIDE MOUNT 2-HOLE

80KD-19E

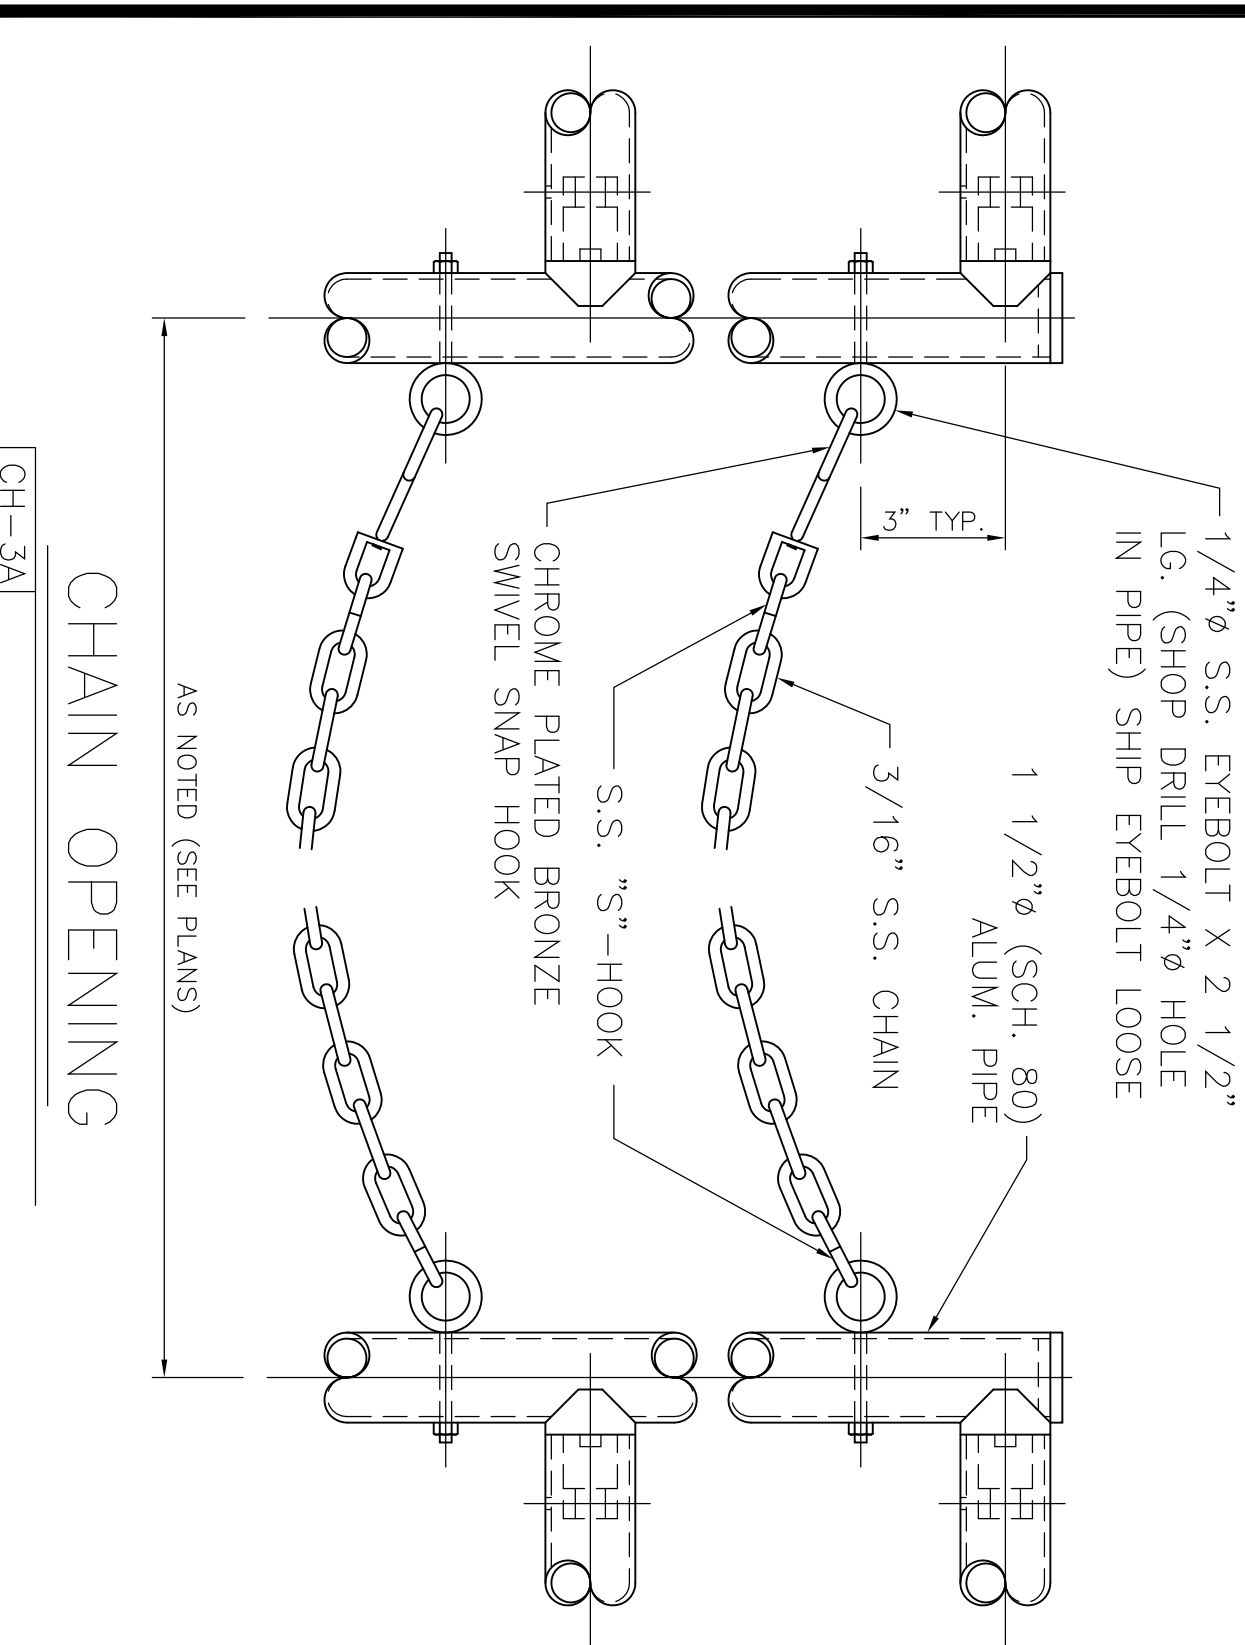

CHAIN OPENING

CH-3A

ROCKY MOUNTAIN RAILINGS
 11839 E 51st AVE DENVER, CO 80239
 HAROLD D. THOMPSON W.R.F.
 FOUNTAIN, CO.
 CUSTOMER: WEAYER CONSTRUCTION
 DESIGNER: GSM, INC.
 PHONE (303) 432-0033 FAX (303) 432-2038

REVISION	DATE	BY	DATE
1	11/16/11	AS	
2	NOTED	OTHERS	
3	NOTED	OTHERS	

JOB NO. R2027
 DRAWING NO. D-2


REFER TO CONTACT DRAWING FOR DIMENSIONS

THESE DRAWINGS ARE THE PROPERTY OF TITLE AIRWAY & RESOURCE INC. THESE DRAWINGS AND SHALL NOT BE REPRODUCED OR COPIED OR USED AS THE BASIS FOR THE MANUFACTURE OF ANY OTHER SIMILAR DRAWING WITHOUT PERMISSION OF THE ENGINEER/ARCHITECT. NO PART OF THIS DOCUMENT IS TO BE REPRODUCED OR TRANSMITTED IN ANY FORM OR BY ANY MEANS, ELECTRONIC OR MECHANICAL, INCLUDING PHOTOCOPYING, RECORDING, OR BY ANY INFORMATION STORAGE AND RETRIEVAL SYSTEM. THE ENGINEER/ARCHITECT DOES NOT ASSUME RESPONSIBILITY FOR THE DESIGN OF THE STRUCTURE OR THE PERFORMANCE OF THE STRUCTURE UNDER ANY CONDITIONS OTHER THAN THOSE SPECIFIED IN THESE DRAWINGS.


MATCH LINE X

MATCH LINE X

TOTAL POST	70
BASE MT.	59
EMBED	N/A
SIDE MT.	11

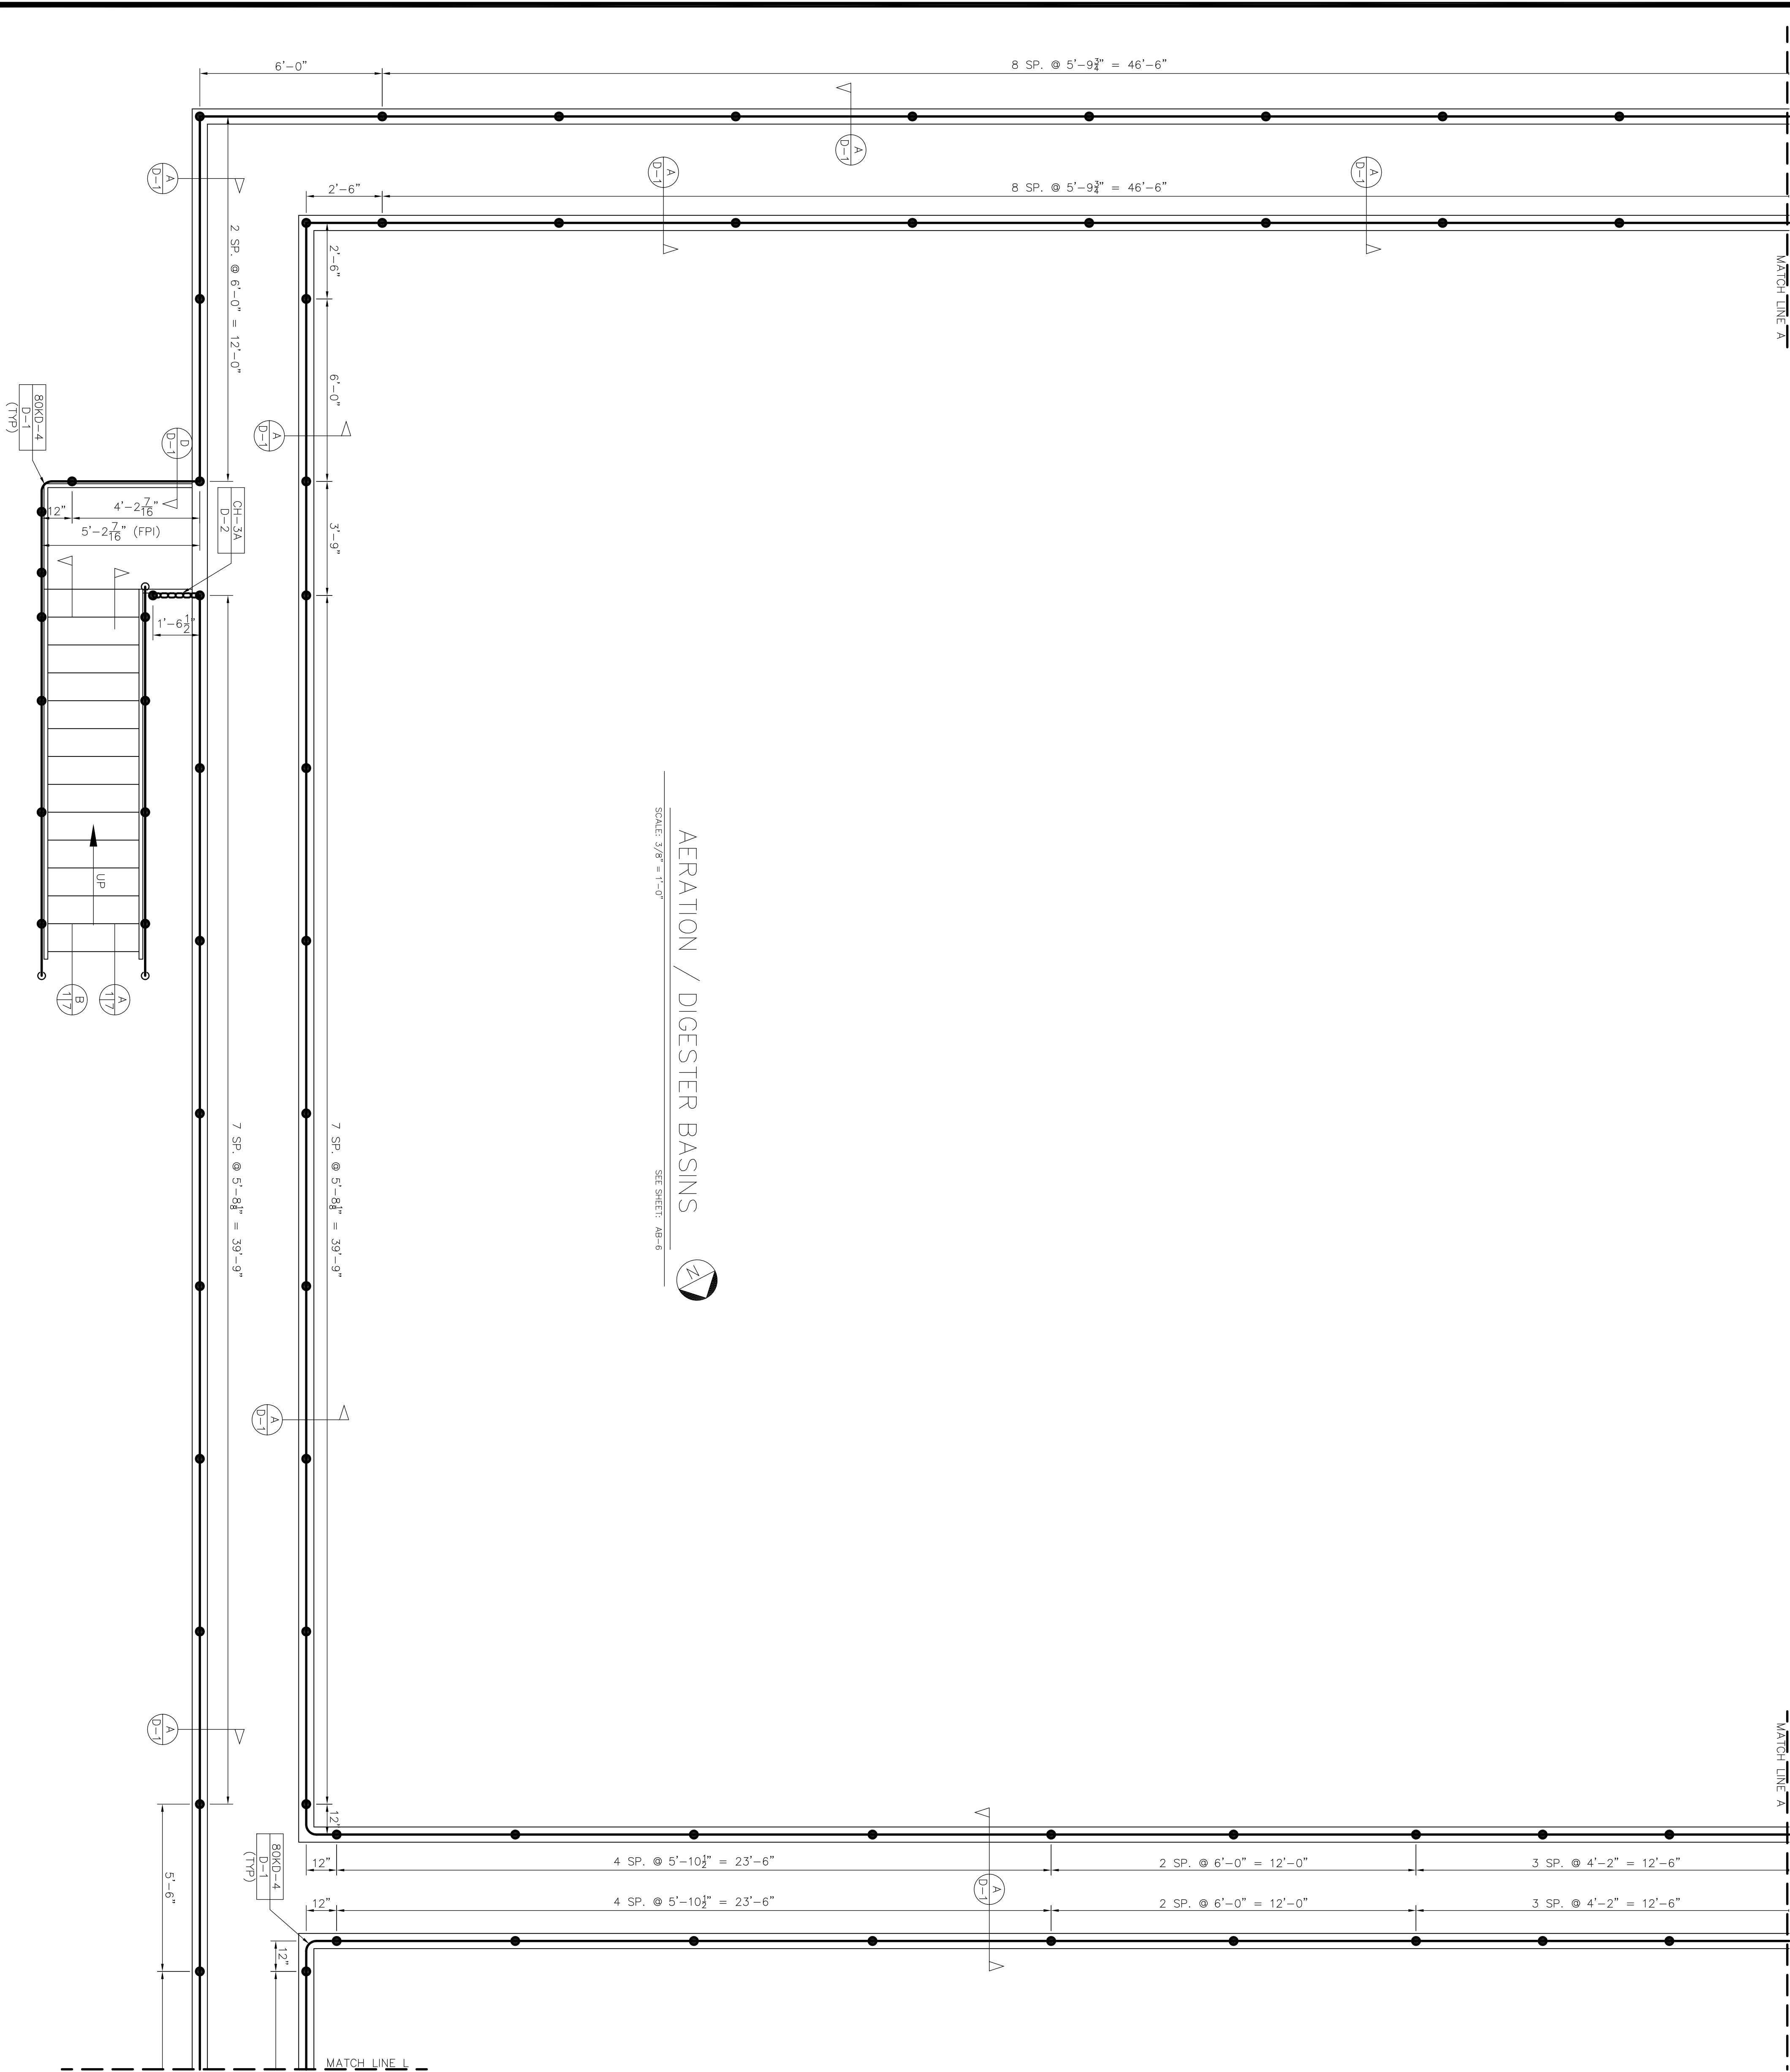

AERATION / DIGESTER BASINS
SCALE: 3/8" = 1'-0"
SEE SHEET AB-6

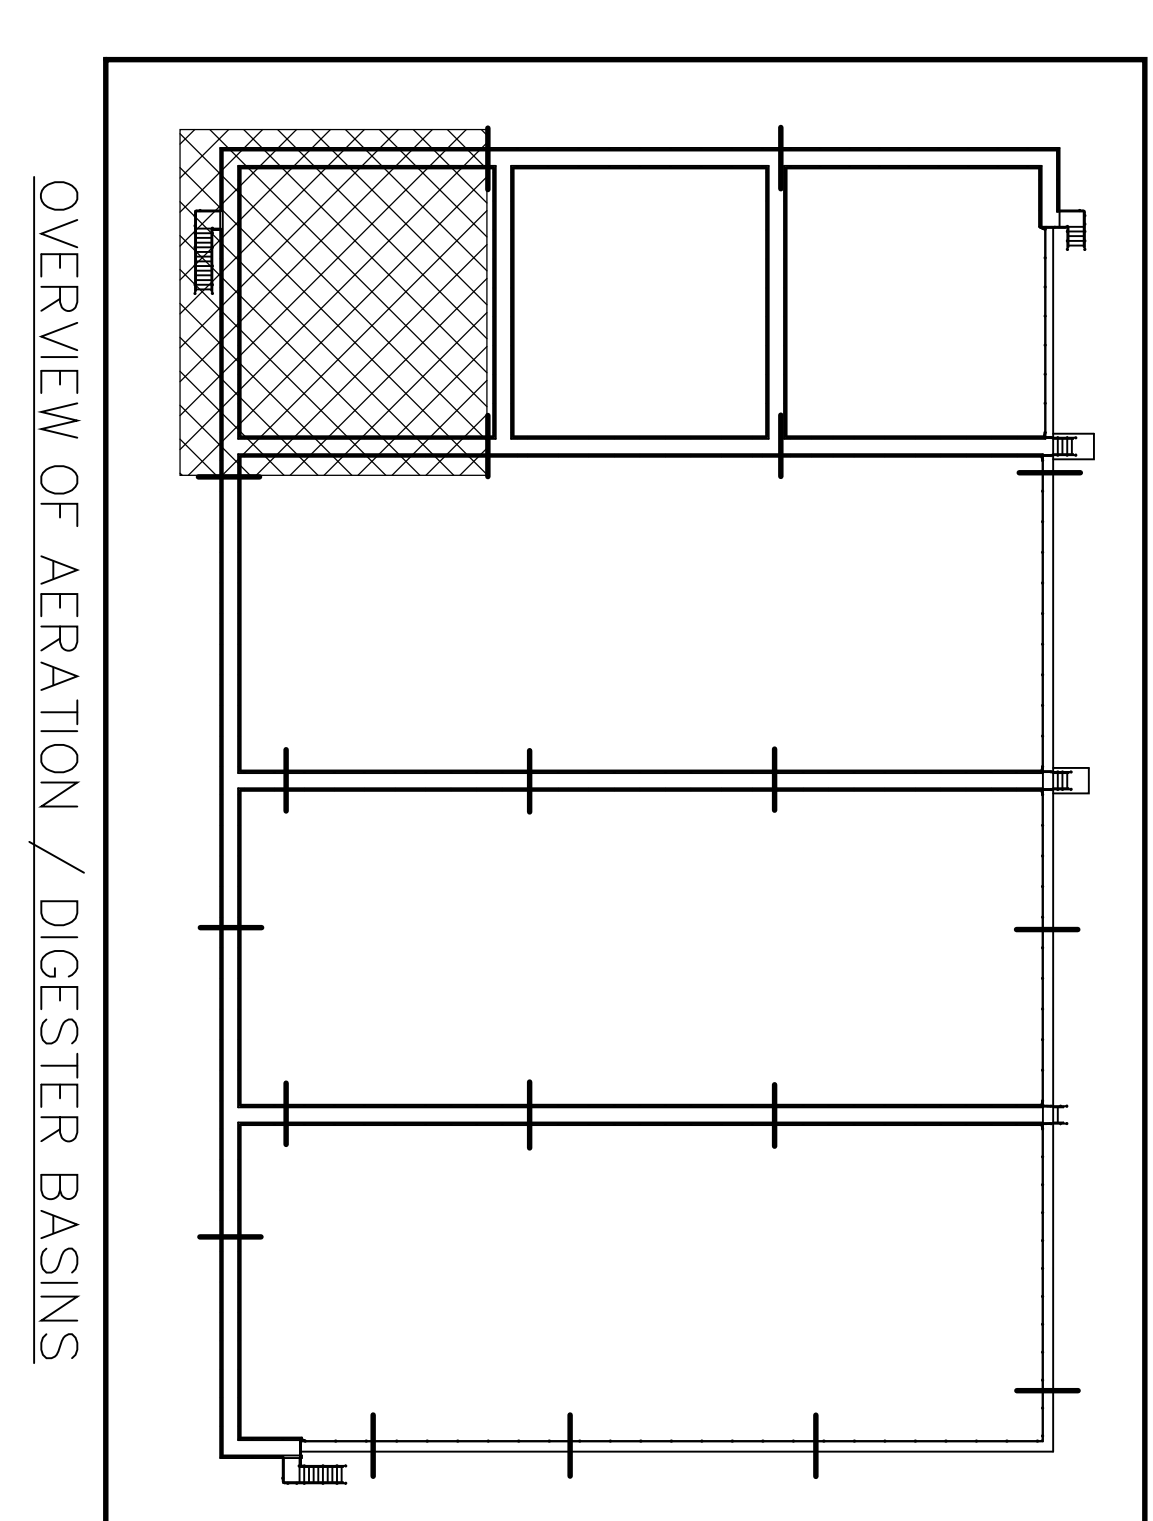


OVERVIEW OF AERATION / DIGESTER BASINS

ROCKY MOUNTAIN RAILINGS 11839 E 51st AVE DENVER, CO 80239 HAROLD D. THOMPSON W.R.F. FOUNTAIN, CO. PHONE (303) 432-0003 FAX (303) 432-2038	
CUSTOMER: WEAYER CONSTRUCTION CONTRACTOR: GSM, INC.	PROJECT: AERATION / DIGESTERS PT. 1 DATE: 11/16/11 DRAWN BY: DDB CHECKED BY: OTHERS FIELD CHECKED BY: OTHERS CUSTOMER P.O./JOB: 2908-05470-C.O. #1
NO. 1 DATE: 11/16/11 DRAWN BY: DDB CHECKED BY: OTHERS FIELD CHECKED BY: OTHERS CUSTOMER P.O./JOB: 2908-05470-C.O. #1	NO. 1 DATE: 11/16/11 DRAWN BY: DDB CHECKED BY: OTHERS FIELD CHECKED BY: OTHERS CUSTOMER P.O./JOB: 2908-05470-C.O. #1
JOB NO. R2027 DRAWING NO. 1	JOB NO. R2027 DRAWING NO. 1

REFER TO CONTRACT DWG. _____ DATE _____


THESE DRAWINGS ARE THE PROPERTY OF TITLE RAILINGS & ASSOCIATE INC. THESE DRAWINGS AND SHALL NOT BE REPRODUCED OR COPIED OR USED AS THE BASIS FOR THE MANUFACTURE OF ANY OTHER DRAWING WITHOUT PERMISSION OF THE ENGINEER/ARCHITECT. THE ENGINEER/ARCHITECT AND OWNER SHALL BE RESPONSIBLE FOR THE RESPONSIBILITY OF THE ENGINEER/ARCHITECT.

TOTAL POST _____ 74
 BASE MT. _____ 74
 EMBED _____ N/A
 SIDE MT. _____ N/A

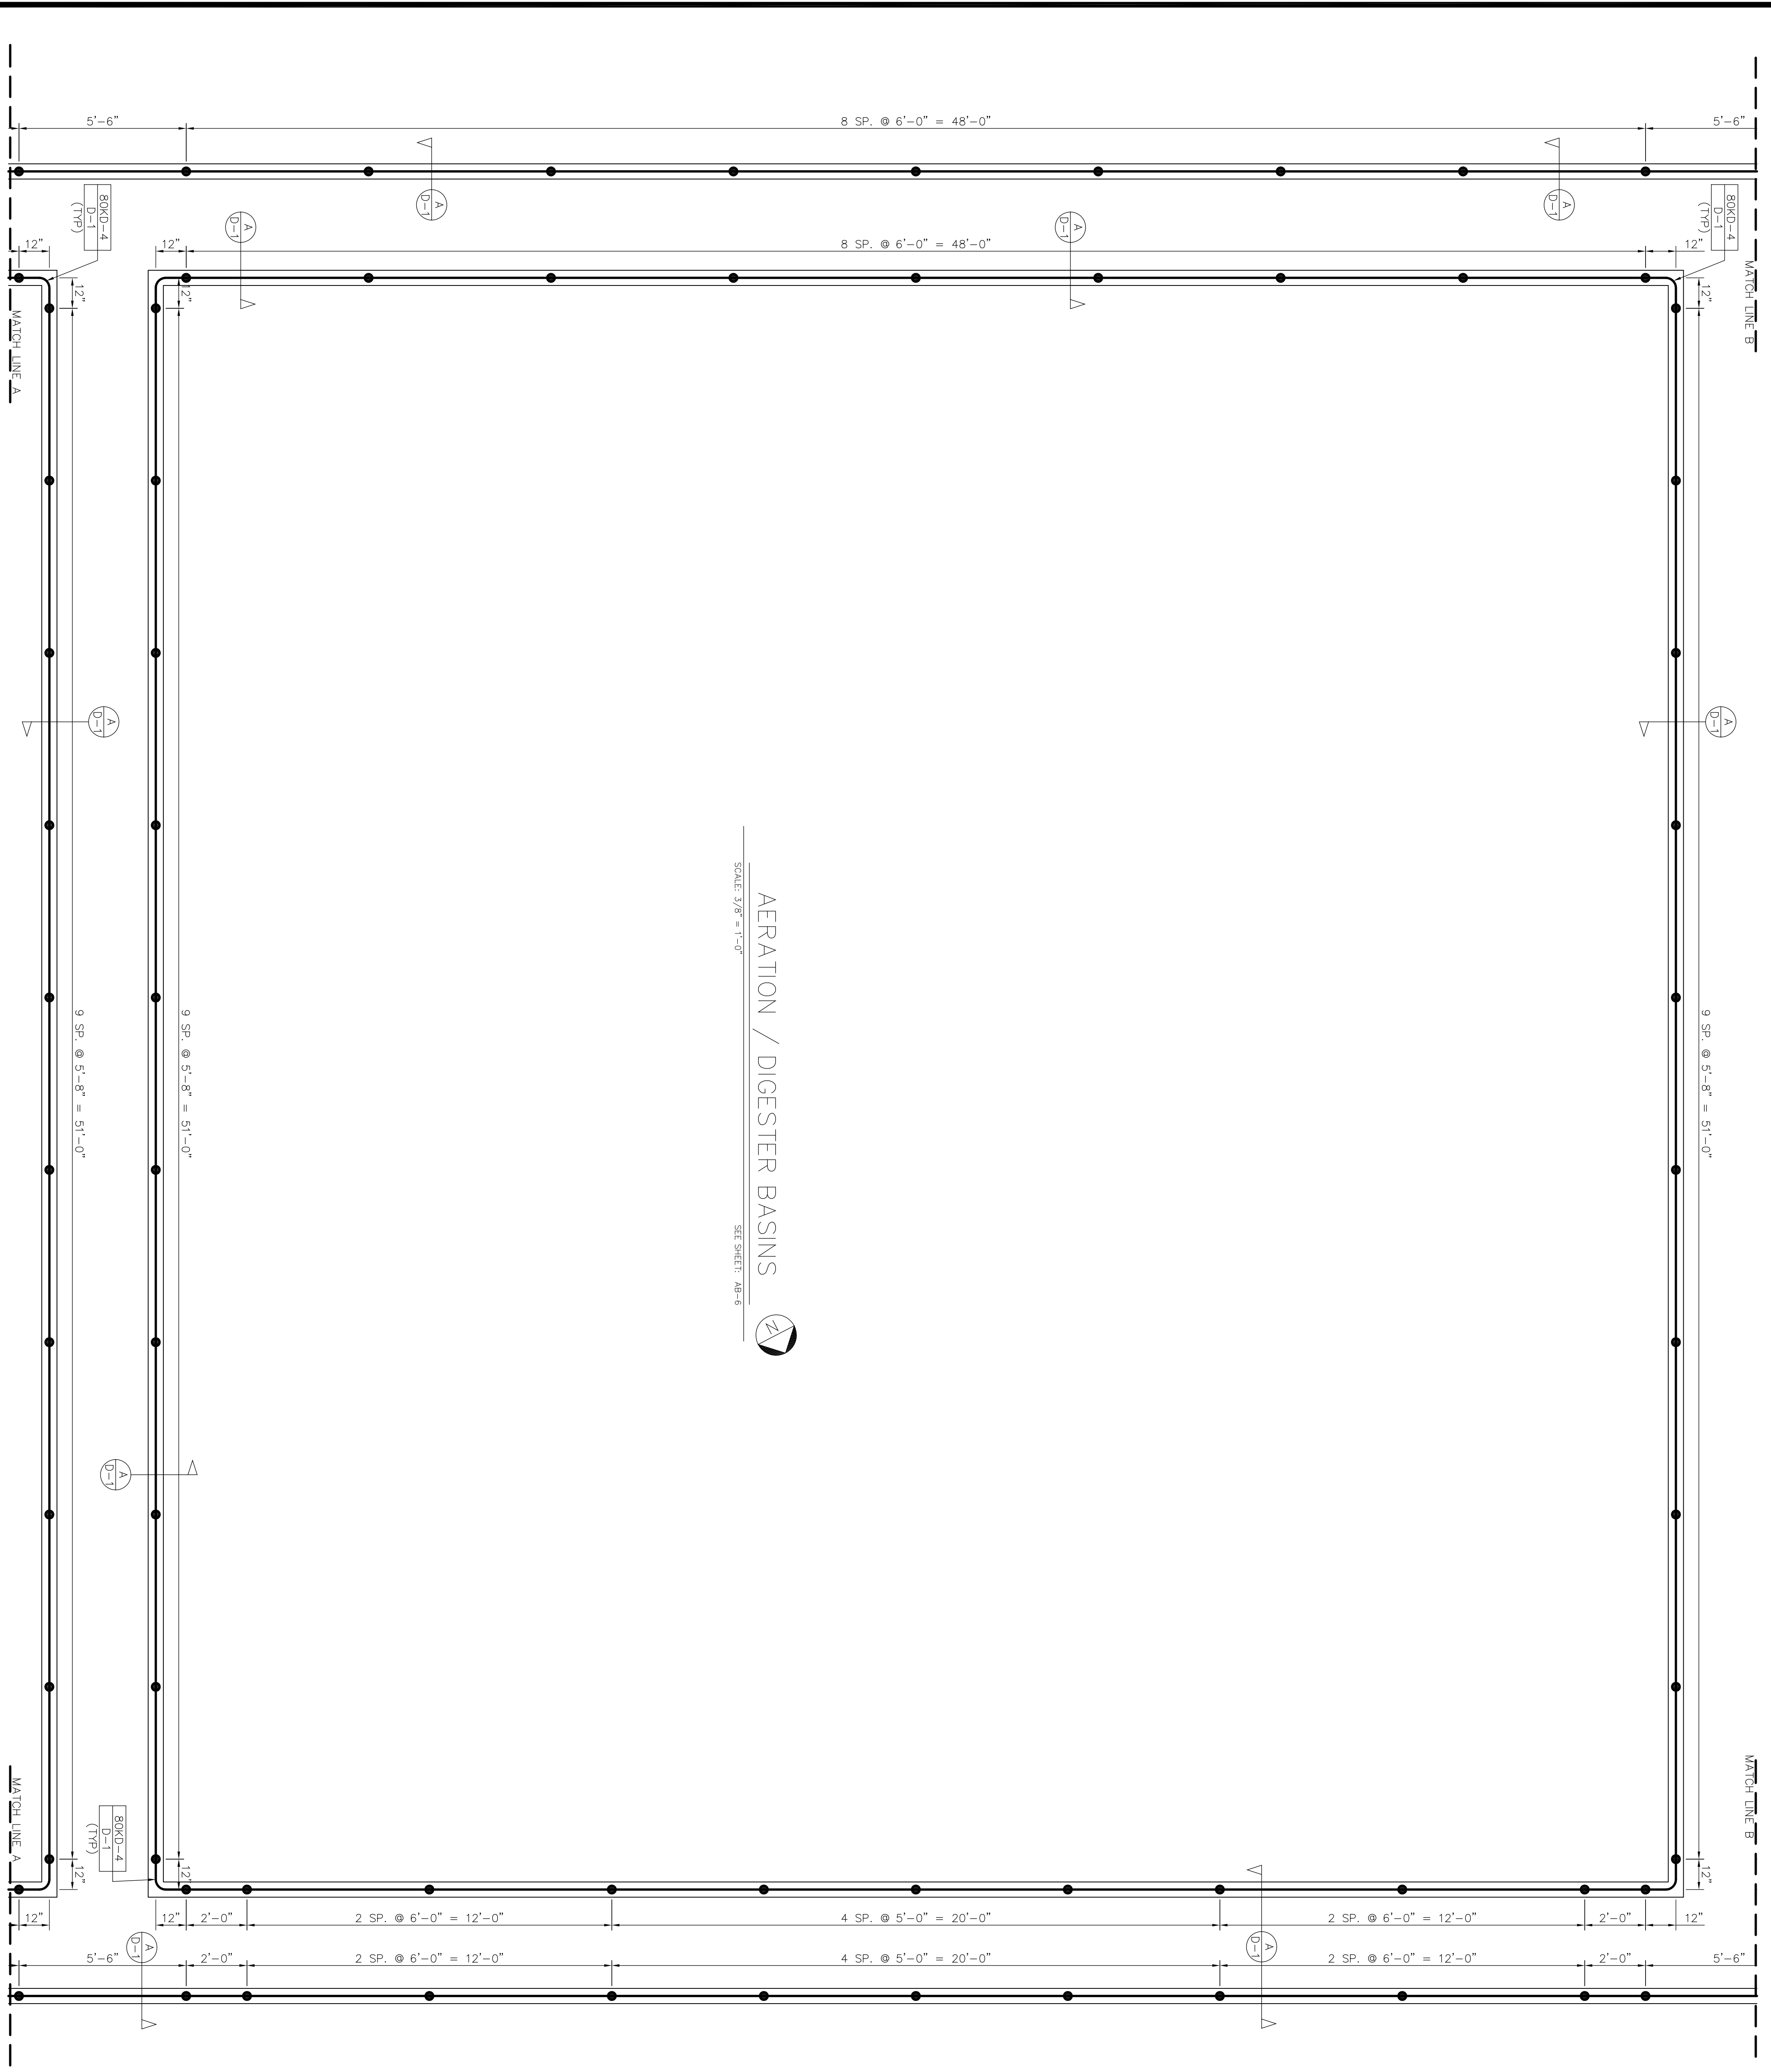

AERATION / DIGESTER BASINS
 SCALE: 3/8" = 1'-0"
 SEE SHEET: AB-6

OVERVIEW OF AERATION / DIGESTER BASINS

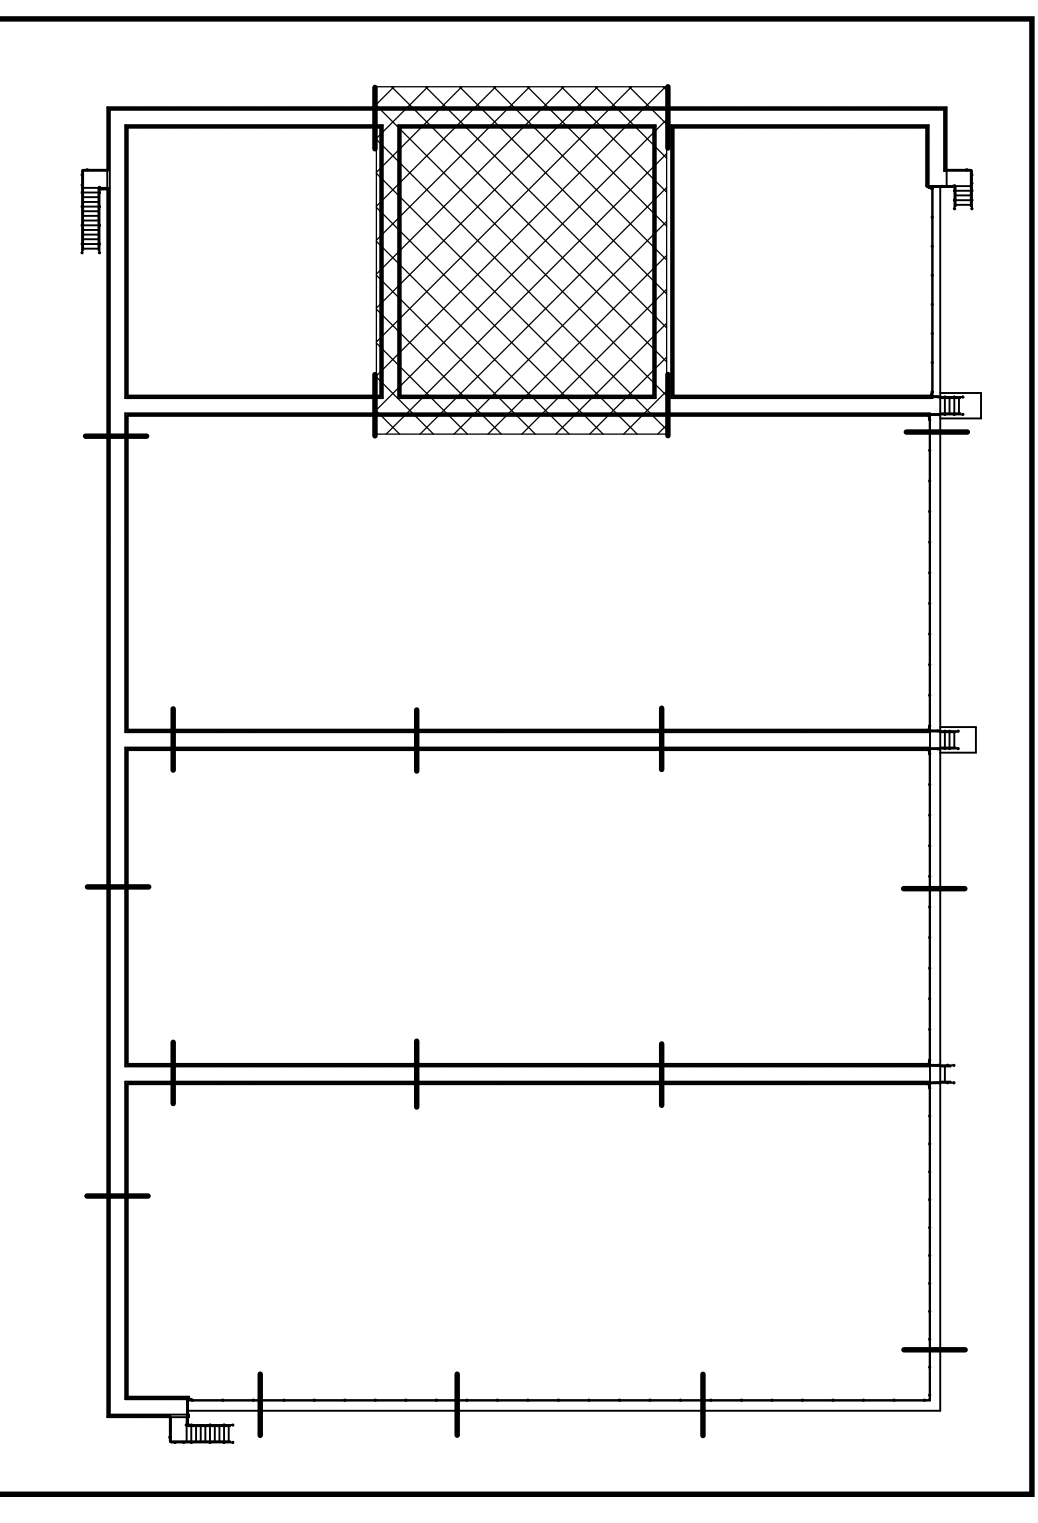

REVISION	BY	DATE
1	LJP	

ROCKY MOUNTAIN RAILINGS
 11839 E 51st AVE DENVER, CO 80239
 HAROLD D. THOMPSON W.R.F.
 FOUNTAIN, CO. PHONE (303) 432-0003 FAX (303) 432-2038


DETAILS: AERATION / DIGESTER PT. 2
 CUSTOMER: GSM, INC.
 CONTRACTOR: WEAYER CONSTRUCTION

DATE: 11/16/11
 DESIGNED BY: DDB
 CHECKED BY: OTHERS
 FIELD CHECKED BY: OTHERS
 CUSTOMER P.O./JOB: 2908-05470-C.O. #1


NO. _____
 CONTRACTOR: _____
 DATE: _____
 PRINTED FOR: _____
 APPROVAL: _____
 TH-BEH

JOB NO. **R2027**
 DRAWING NO. **2**

THESE DRAWINGS ARE THE PROPERTY OF TITLE RAILINGS & RESERVE INC. THESE DRAWINGS AND SHALL NOT BE REPRODUCED OR COPIED OR USED AS THE BASIS FOR THE MANUFACTURE OF ANY OTHER RAILINGS WITHOUT PERMISSION OF THE ENGINEER/ARCHITECT. NO PART OF THESE DRAWINGS SHALL BE REPRODUCED OR COPIED OR USED AS THE BASIS FOR THE MANUFACTURE OF ANY OTHER RAILINGS WITHOUT PERMISSION OF THE ENGINEER/ARCHITECT. THE ENGINEER/ARCHITECT DOES NOT ASSUME RESPONSIBILITY FOR THE RESPONSIBILITY OF THE ENGINEER/ARCHITECT.

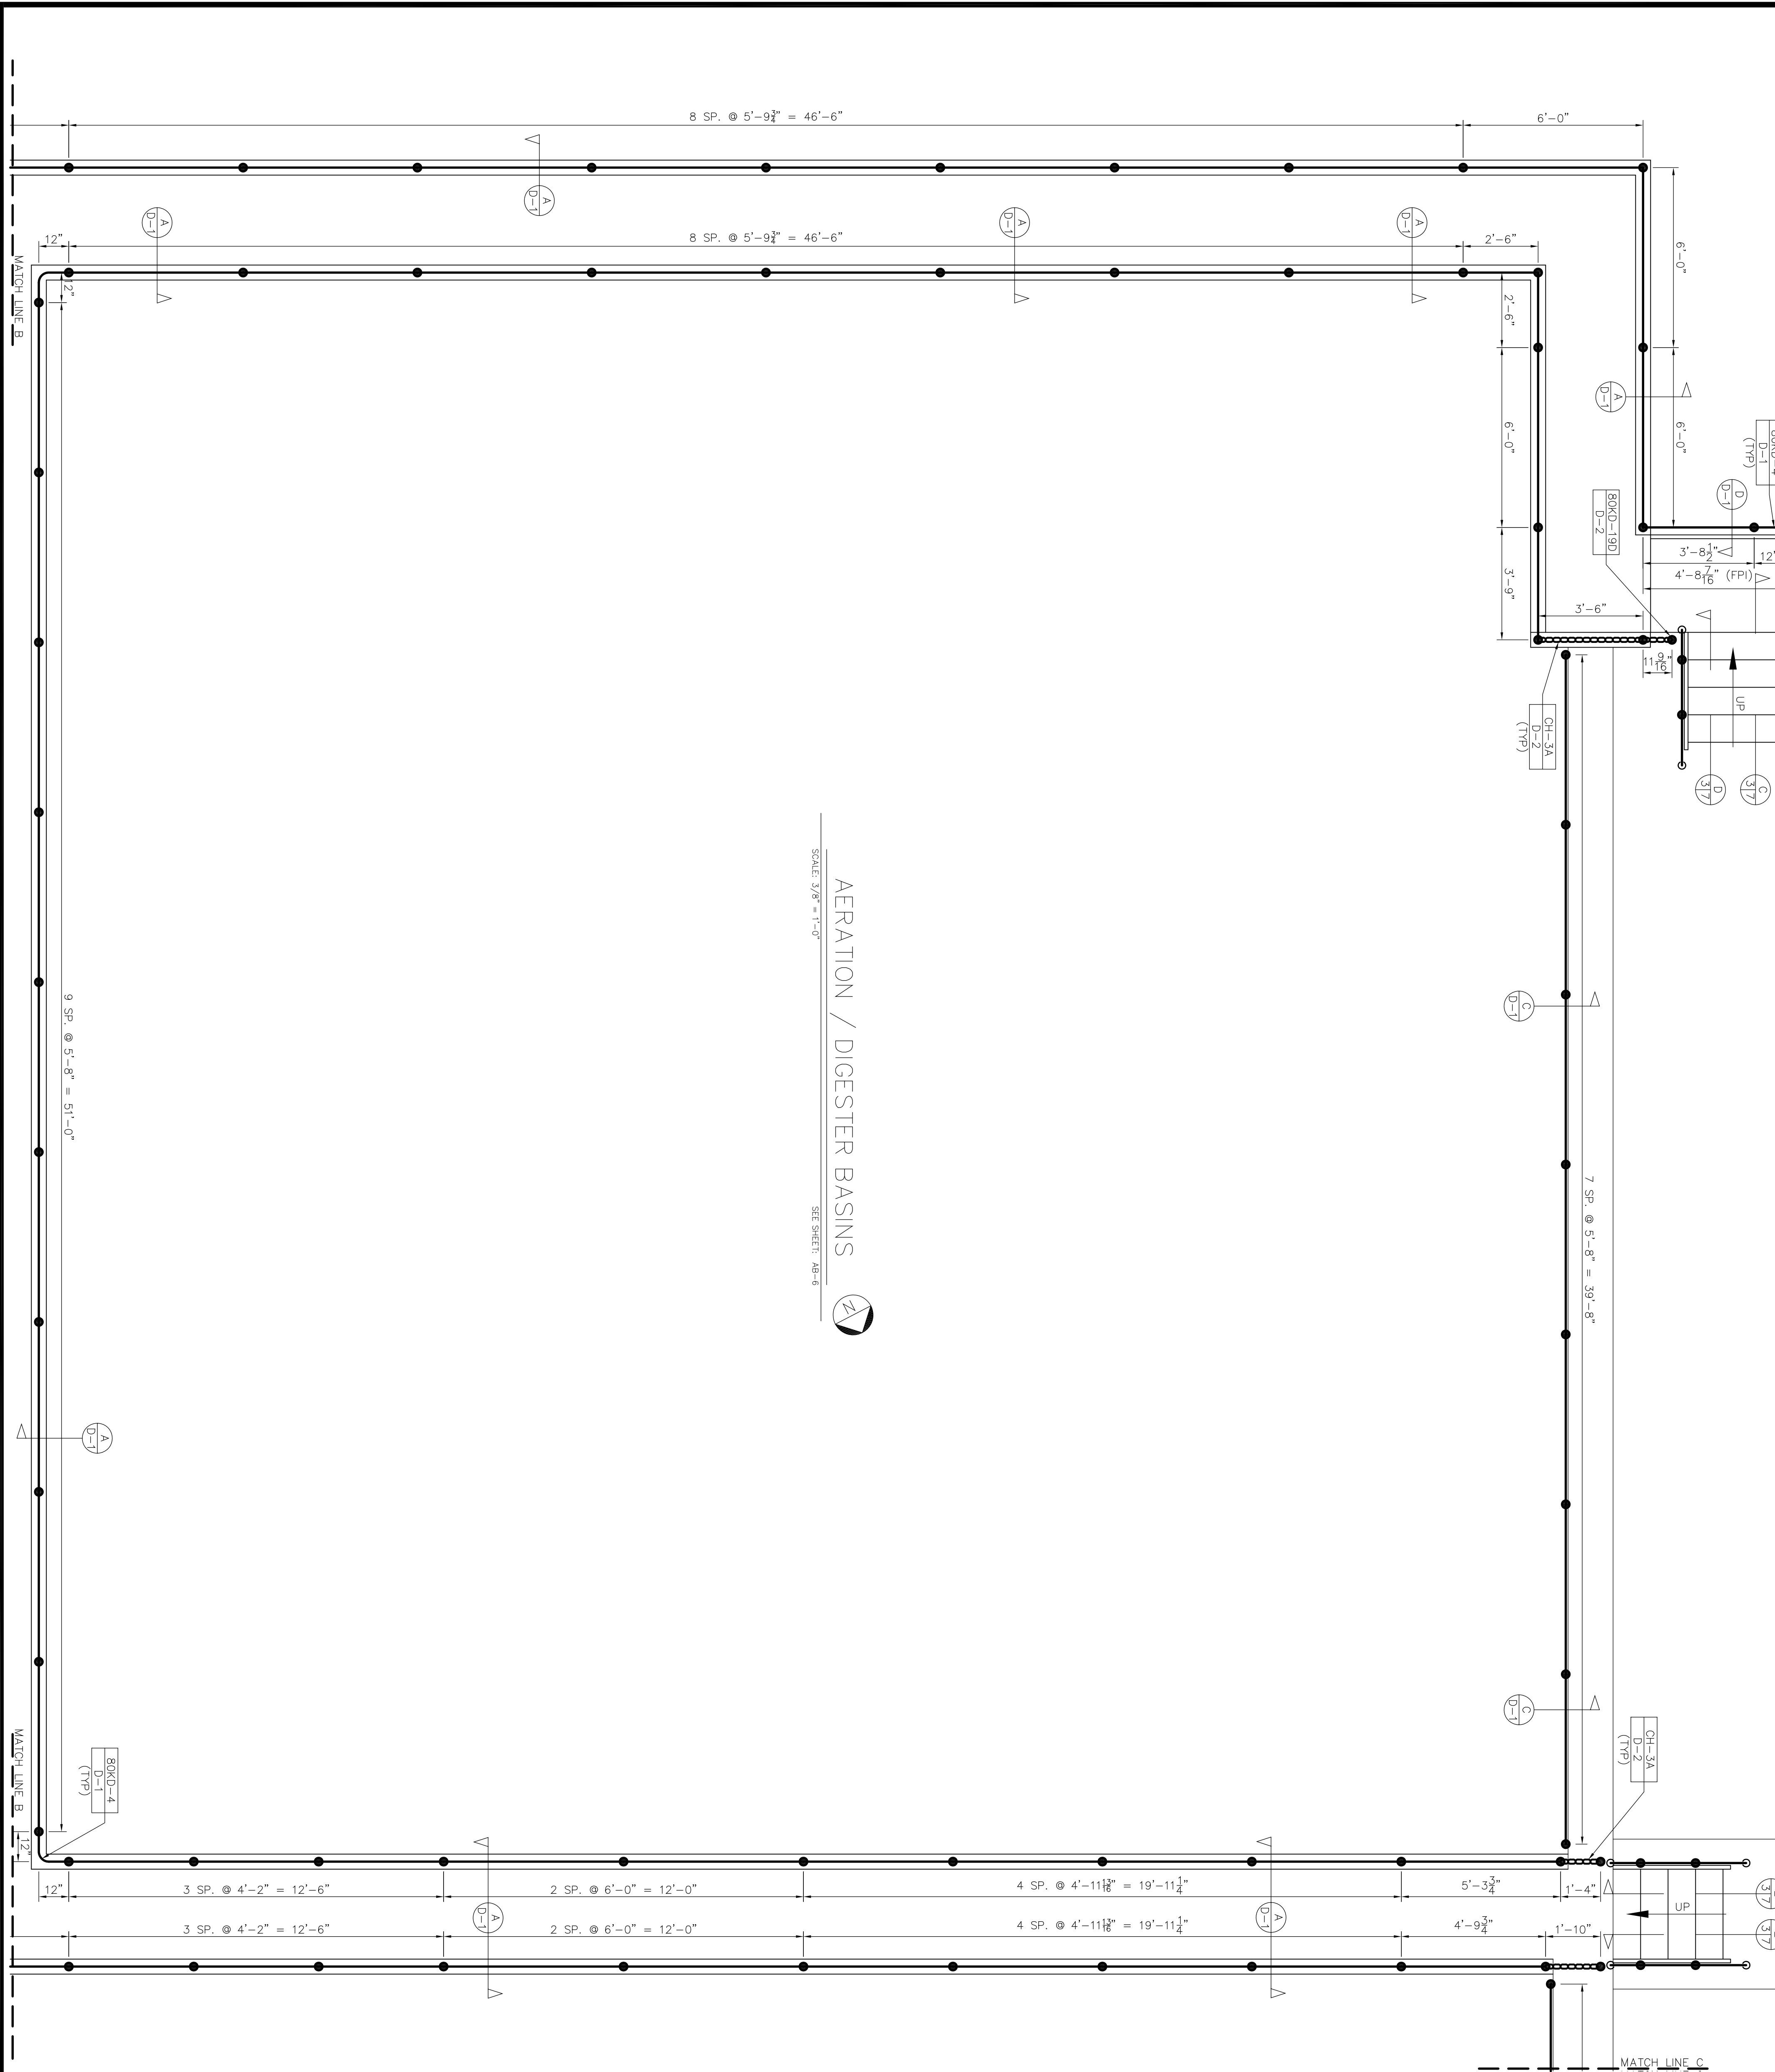

AERATION / DIGESTER BASINS
SCALE: 3/8" = 1'-0"
SHEET: AB-6

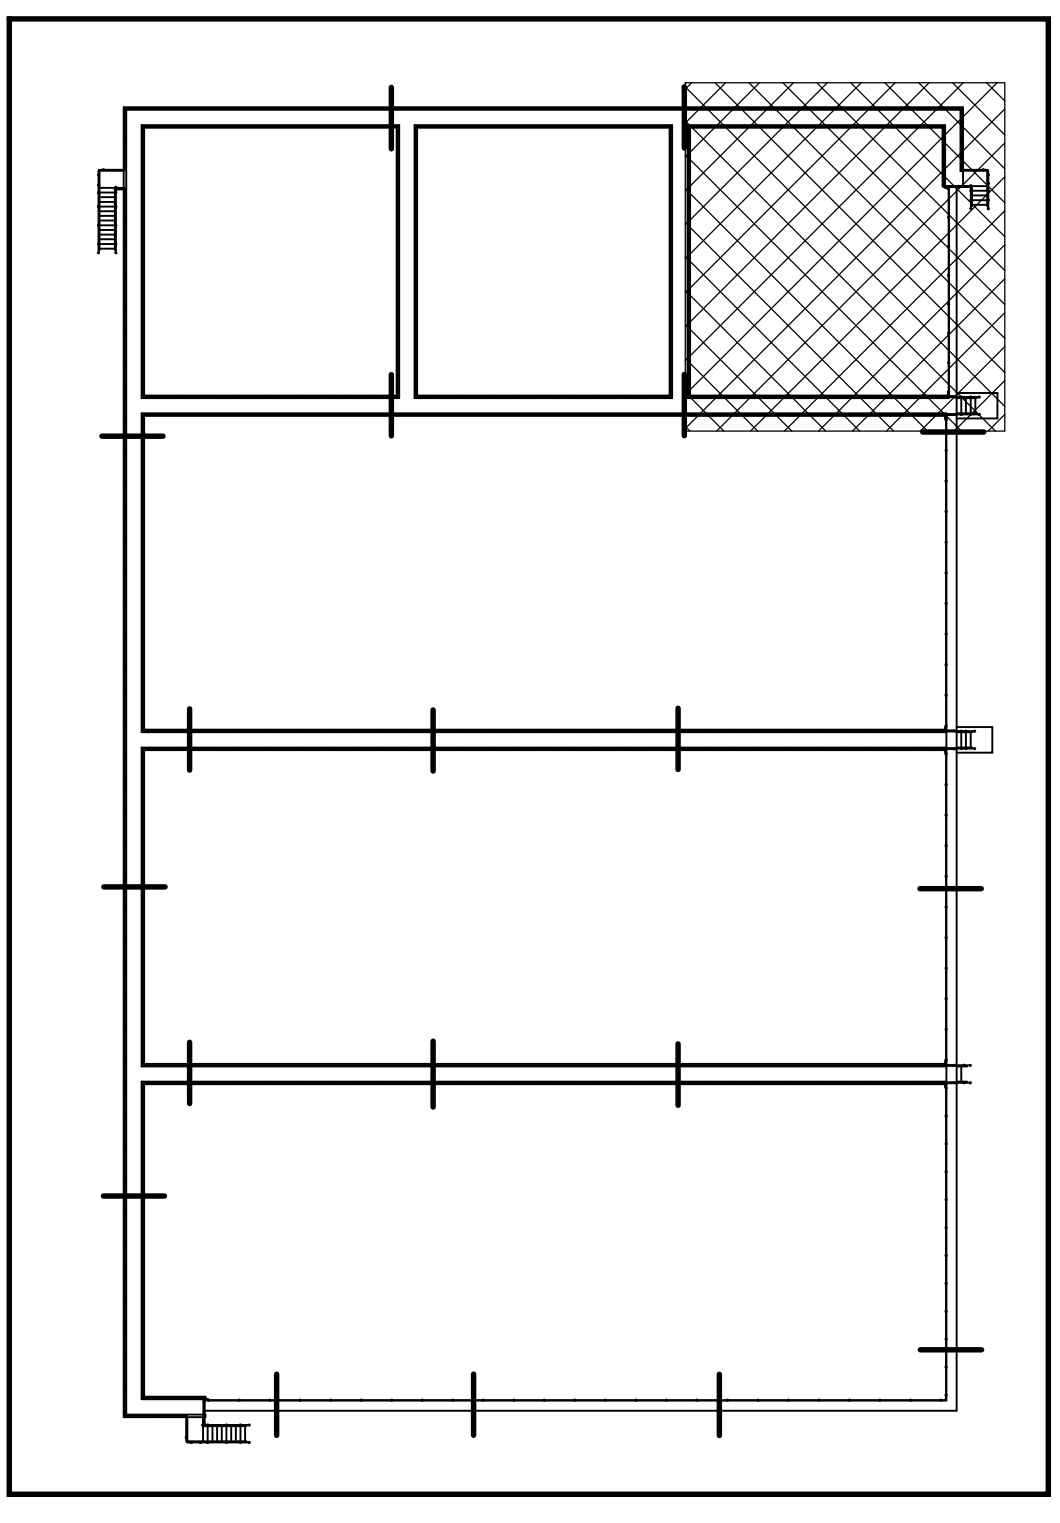


TOTAL POST	76
BASE MT.	53
EMBED	N/A
SIDE MT.	23

ROCKY MOUNTAIN RAILINGS
11839 E 51st AVE DENVER, CO 80239
HAROLD D. THOMPSON W.R.F.
FOUNTAIN, CO.
CUSTOMER: GSM, INC.
DETAILS: AERATION / DIGESTER PT. 3
FNS# M10C22A41
DR: DDB DATE: 11/16/11
REVISION: AS NOTED
FIELD CHECKED BY: OTHERS
CUSTOMER P.O./JOB: 2908-05470-C.O. #1

WEAYER CONSTRUCTION
CONTRACTOR
GSM, INC.
DESIGNER
PHONE (303) 432-0003 FAX (303) 432-2038
NO. PRINTS FOR: _____ DATE: _____
SP: APPROVAL: _____
JOB NO. R2027
DRAWING NO. 3


THESE DRAWINGS ARE THE PROPERTY OF TITLE RAILINGS & REBAR INC. THESE DRAWINGS AND SHALL NOT BE REPRODUCED OR COPIED OR USED AS THE BASIS FOR THE MANUFACTURE OF ANY OTHER DRAWING WITHOUT PERMISSION OF THE ENGINEER/ARCHITECT. ANY AND ALL CONSTRUCTION SHALL BE THE RESPONSIBILITY OF THE ENGINEER/ARCHITECT.

TOTAL POST _____ 112
 BASE MT. _____ 96
 EMBED _____ N/A
 SIDE MT. _____ 16

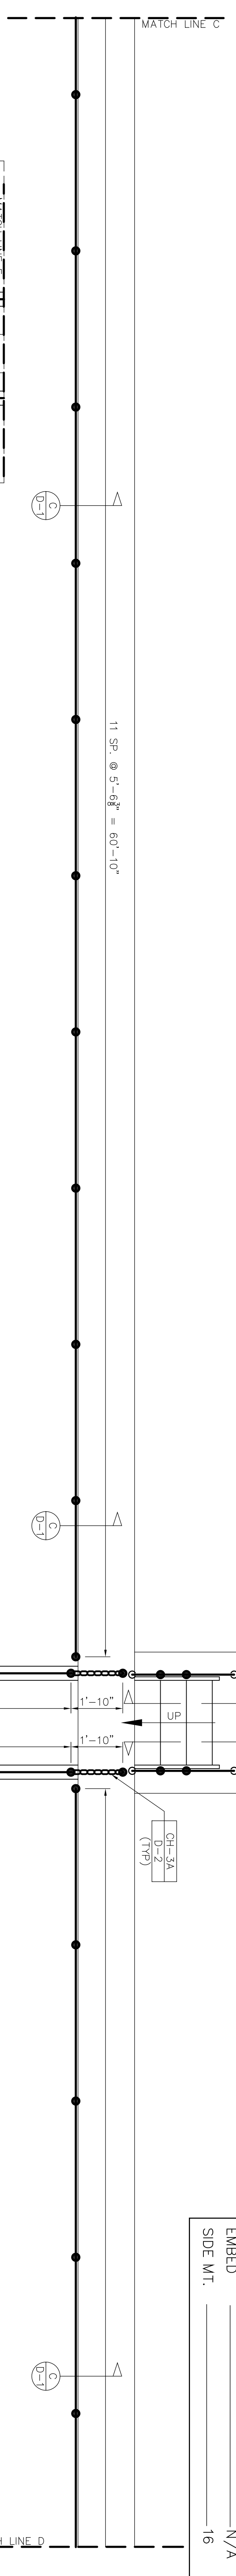


AERATION / DIGESTER BASINS

SCALE: 3/8" = 1'-0" SEE SHEET AB-6

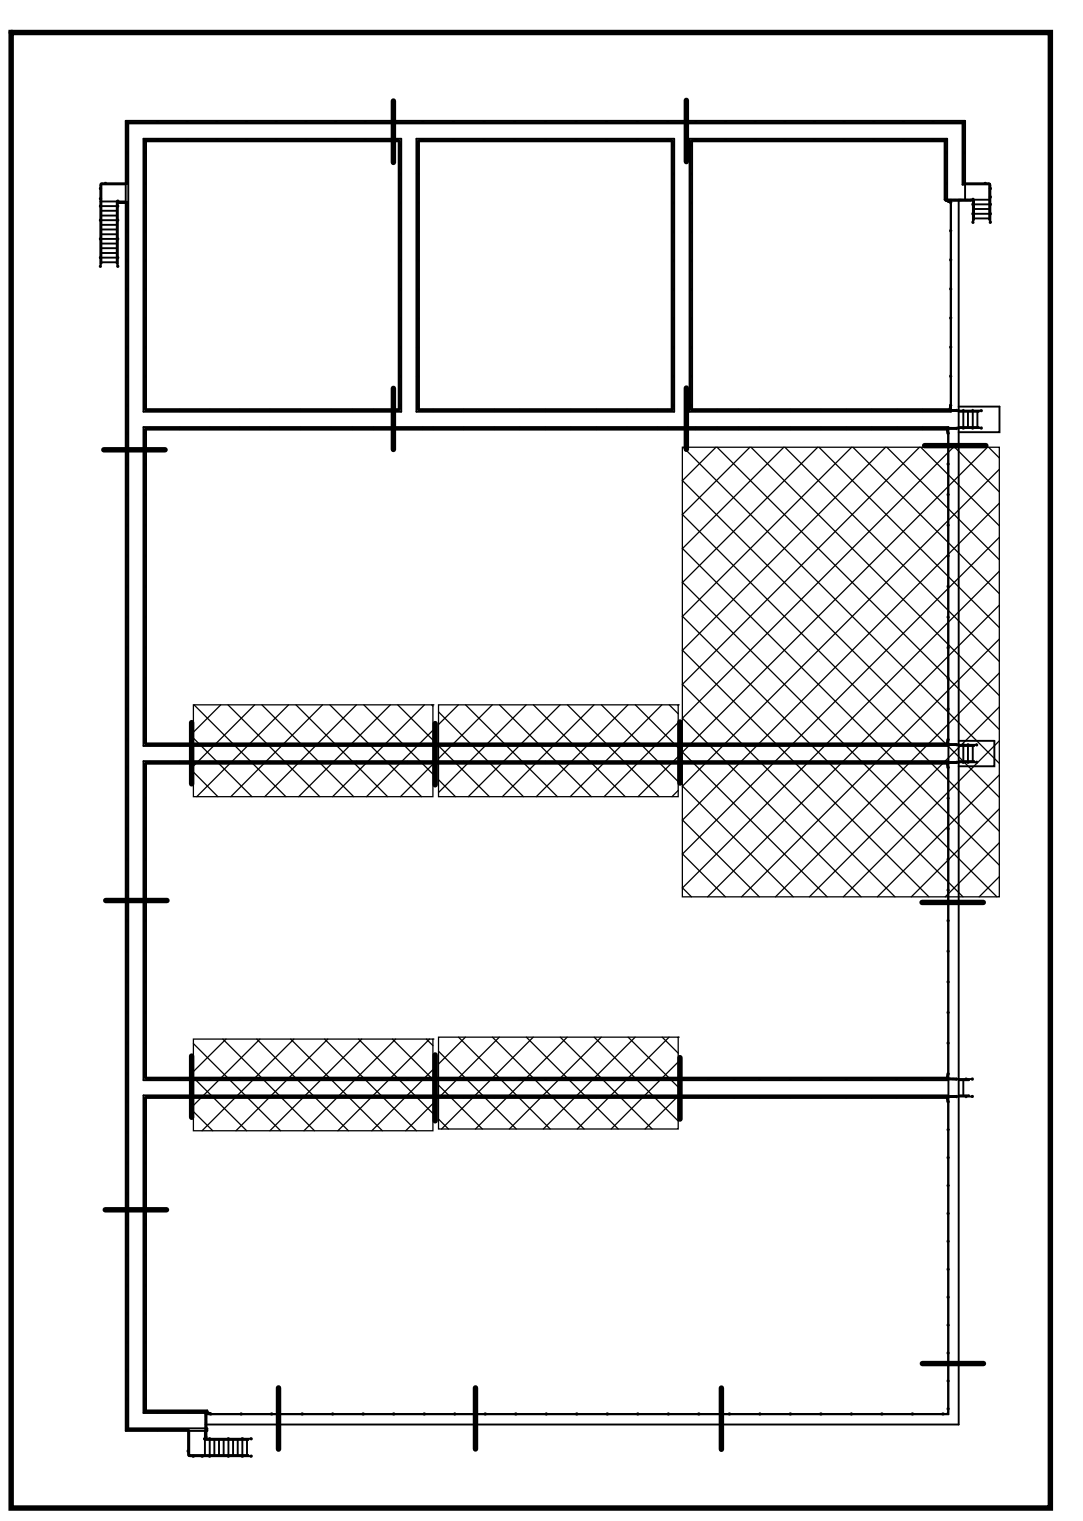


OVERVIEW OF AERATION / DIGESTER BASINS

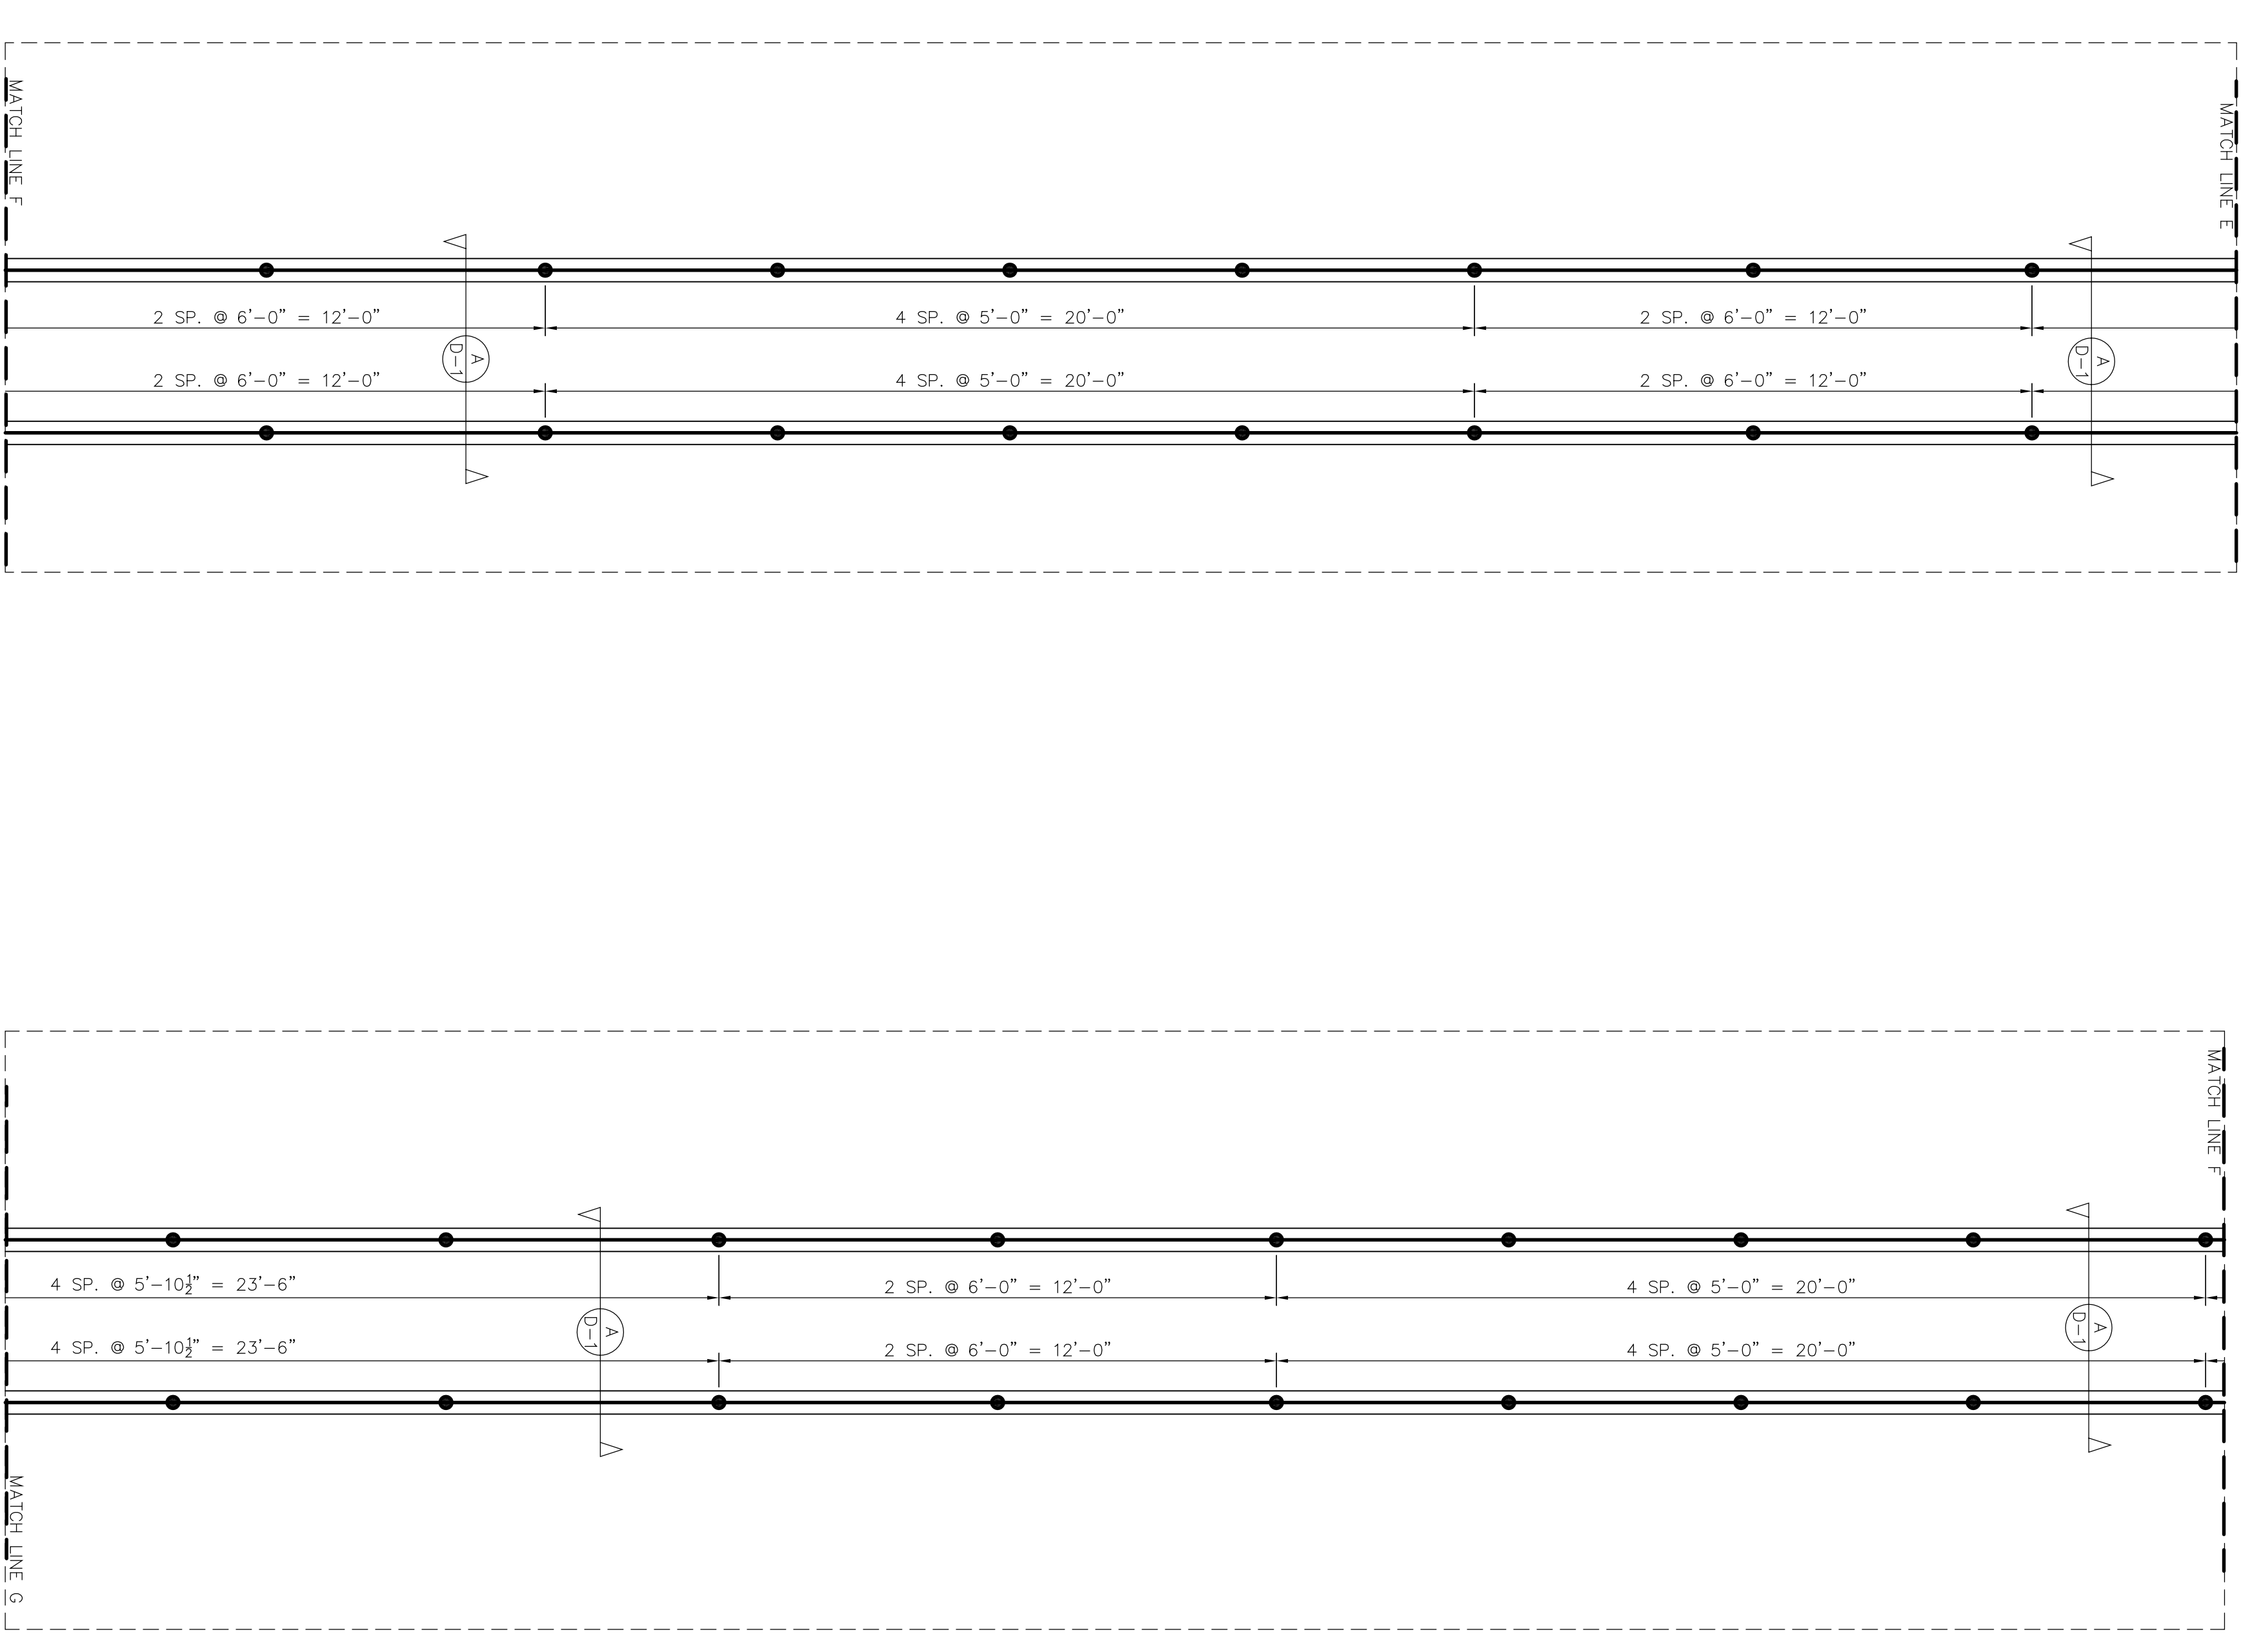

ONE SHOWN : TWO NEEDED
 SCALE : 3/8" = 1'-0"




ONE SHOWN : TWO NEEDED
 SCALE : 3/8" = 1'-0"


 <p>ROCKY MOUNTAIN RAILINGS 11839 E 51st AVE DENVER, CO 80239 HAROLD D. THOMPSON W.R.F. FOUNTAIN, CO. PHONE (303) 432-0003 FAX (303) 432-2038</p>		<p>DESIGNER GSM, INC. CUSTOMER WEAYER CONSTRUCTION</p>	
BY	DATE	NO.	PRINTED FOR
DR. DDB	DATE 11/16/11	DATE	DATE
REVISION	SCALE AS NOTED	SP. APPROVAL	TH-BEH
DETAILS / AERATION / DIGESTER PT. 4	FIELD CHECKED BY OTHERS	CONTRACTOR	JOB NO. R2027
FINISH M10C22A41	CUSTOMER P.O./JOB 2908-05470-C.O. #1	CONTRACTOR	DRAWING NO. 4

REFER TO CONTRACT DWS. DWG. NO.

THESE DRAWINGS ARE THE PROPERTY OF TITLE EXAMINER & ASSOCIATES, INC. THESE DRAWINGS AND SHALL NOT BE REPRODUCED OR COPIED OR USED AS THE BASIS FOR THE MANUFACTURE OF ANY OTHER DRAWING WITHOUT PERMISSION OF THE ENGINEER/ARCHITECT. THE ENGINEER/ARCHITECT DOES NOT ASSUME ANY LIABILITY OR RESPONSIBILITY FOR THE ENGINEER/ARCHITECT'S ACTIONS.

TOTAL POST	61
BASE MT.	24
EMBED	N/A
SIDE MT.	37

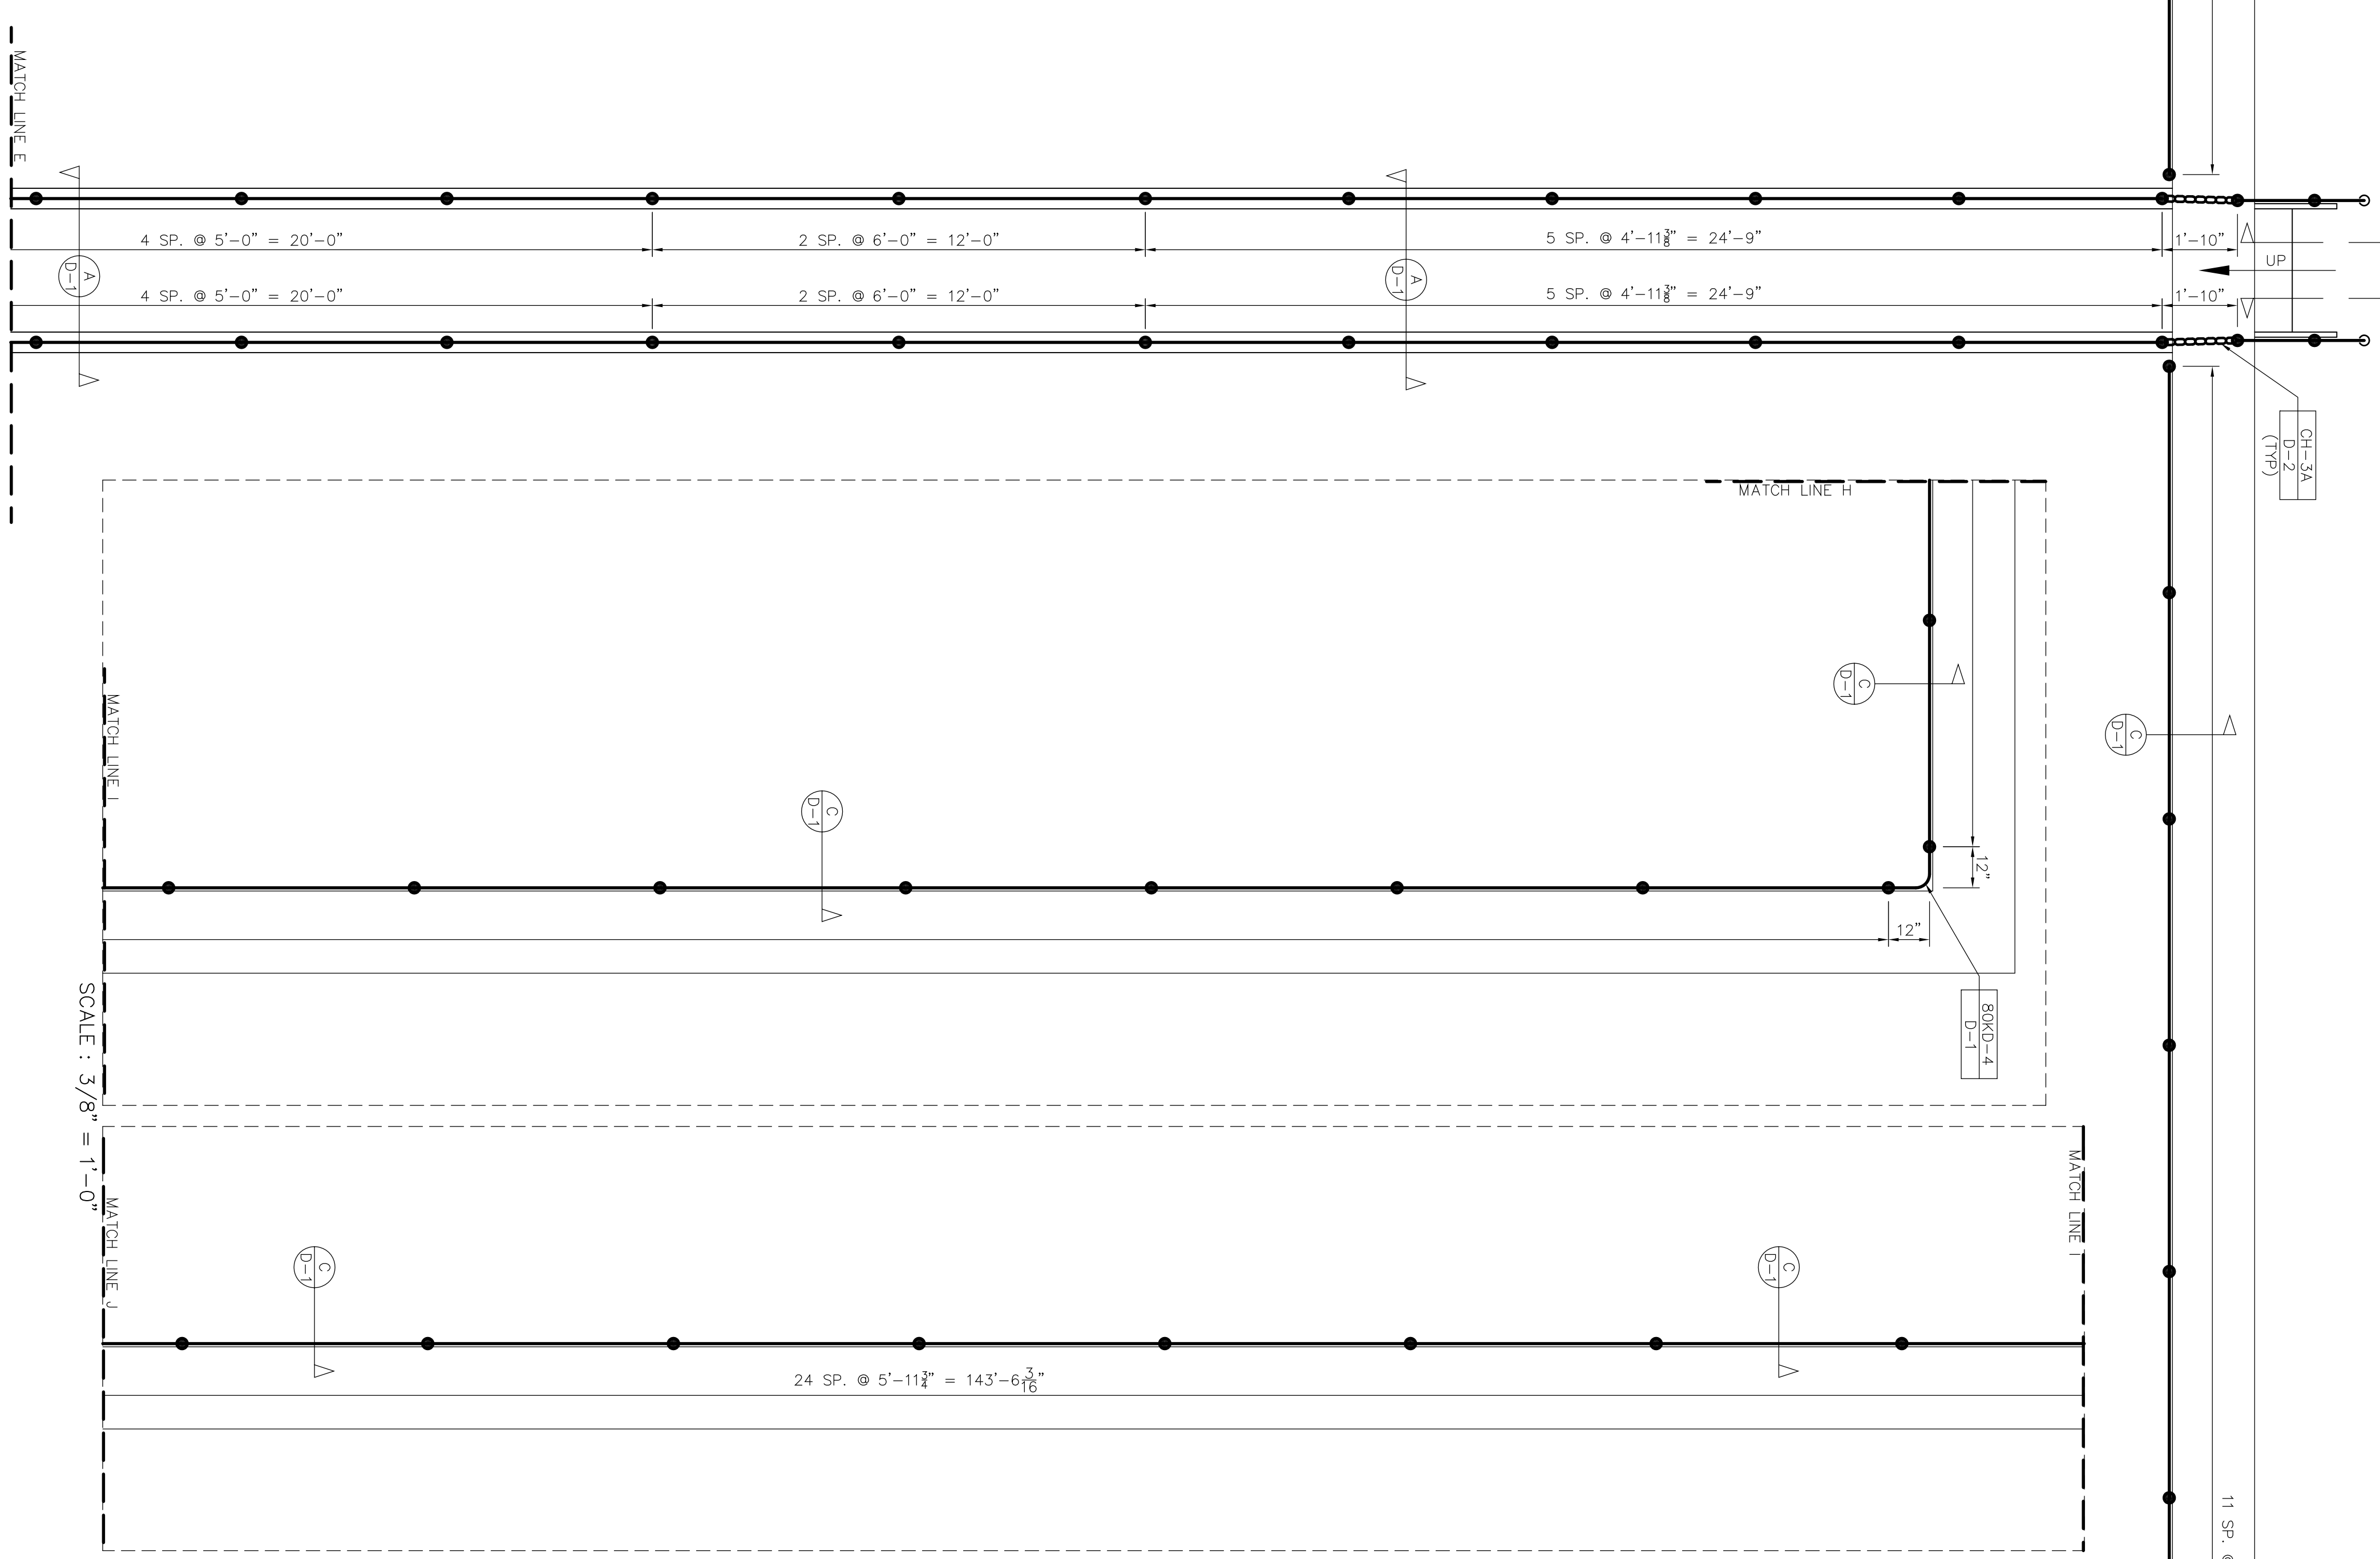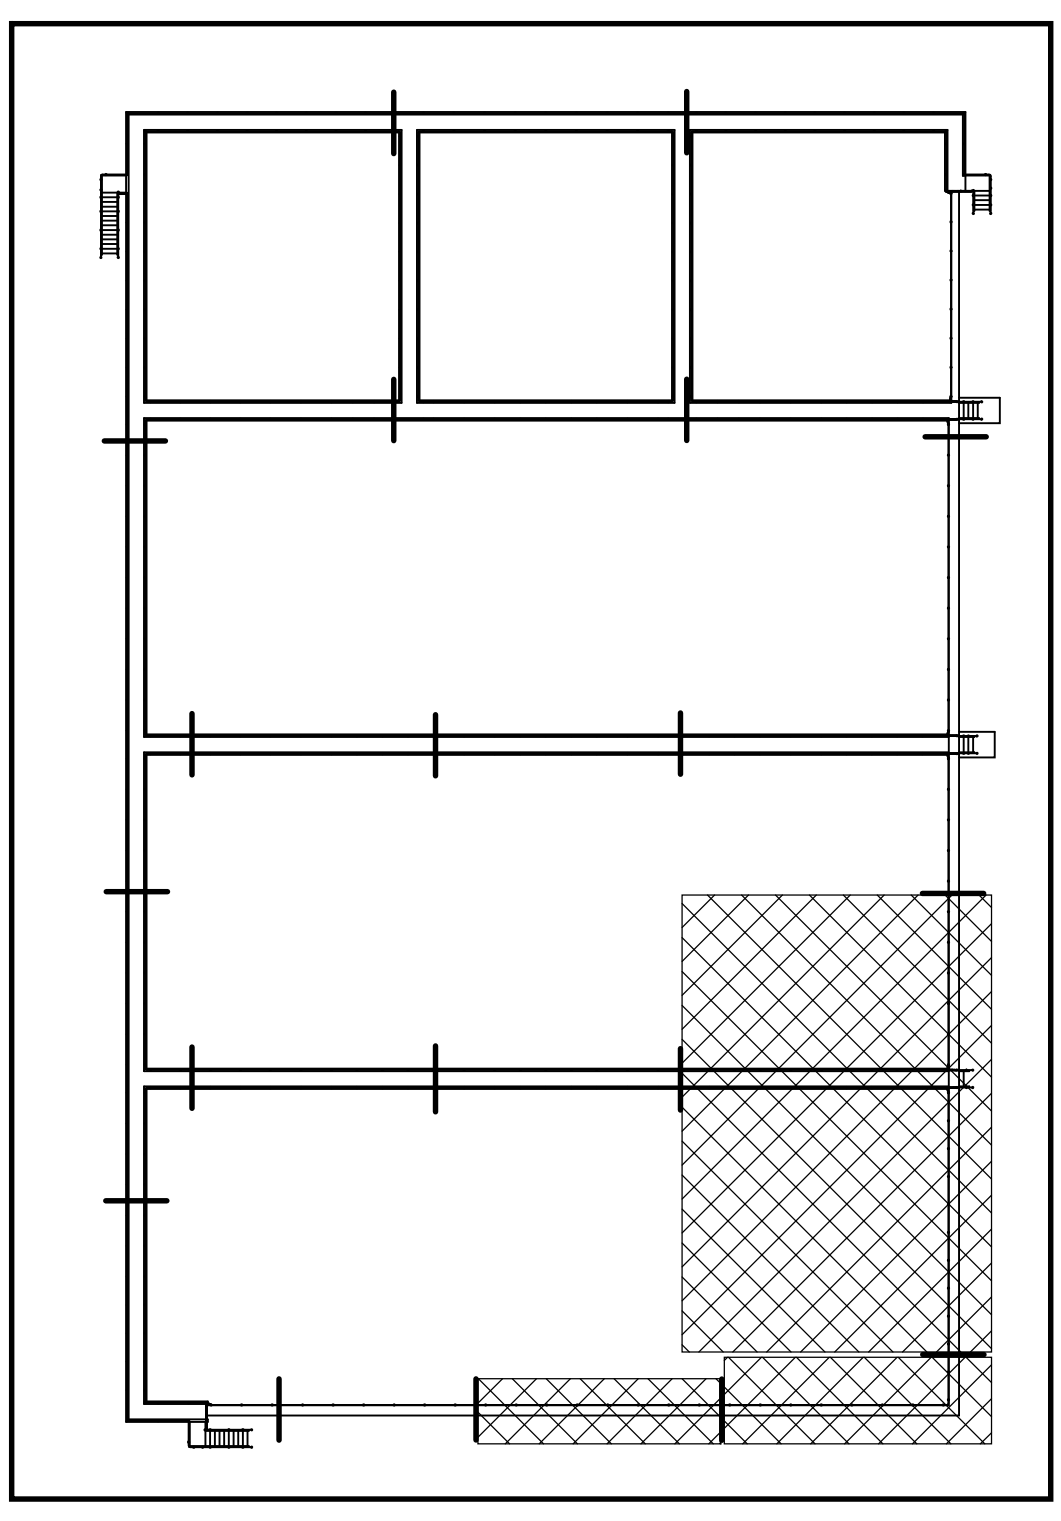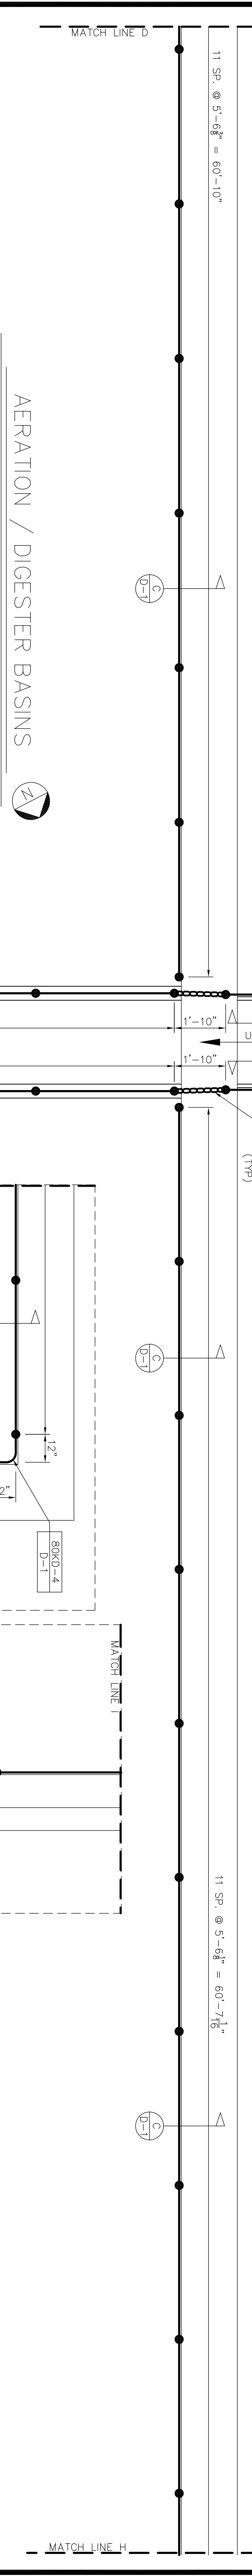



ROCKY MOUNTAIN RAILINGS

11839 E 51st AVE DENVER, CO 80239
 HAROLD D. THOMPSON W.R.F.
 FOUNTAIN, CO.
 PHONE (303) 432-0003 FAX (303) 432-2038

DESIGNER	GSM, INC.	CUSTOMER	WEAYER CONSTRUCTION
DETAILS / AERATION / DIGESTER PT. 5		CONTRACTOR	
TRNSP M10C22A41			
DR DDB	DATE 11/16/11	SCALE AS NOTED	
REVISION		NO.	
FIELD CHECKED BY OTHERS		SP.	APPROVAL
CUSTOMER P.O./JOB	2908-05470-C.O. #1		

JOB NO. R2027

DRAWING NO. 5






DATE

NO.

REFER TO CONTRACT DWG. _____ DWG. NO. _____

THESE DRAWINGS ARE THE PROPERTY OF TITLE EXAMINER & ENGINEERING SERVICES, INC. AND SHALL NOT BE REPRODUCED OR COPIED OR USED AS THE BASIS FOR THE MANUFACTURE OF ANY OTHER DRAWING WITHOUT PERMISSION. THE ENGINEER/ARCHITECT/CONSULTANT ASSUMES NO LIABILITY FOR THE RESPONSIBILITY OF THE ENGINEER/ARCHITECT.

TOTAL POST	99
BASE MT.	90
EMBED	N/A
SIDE MT.	9

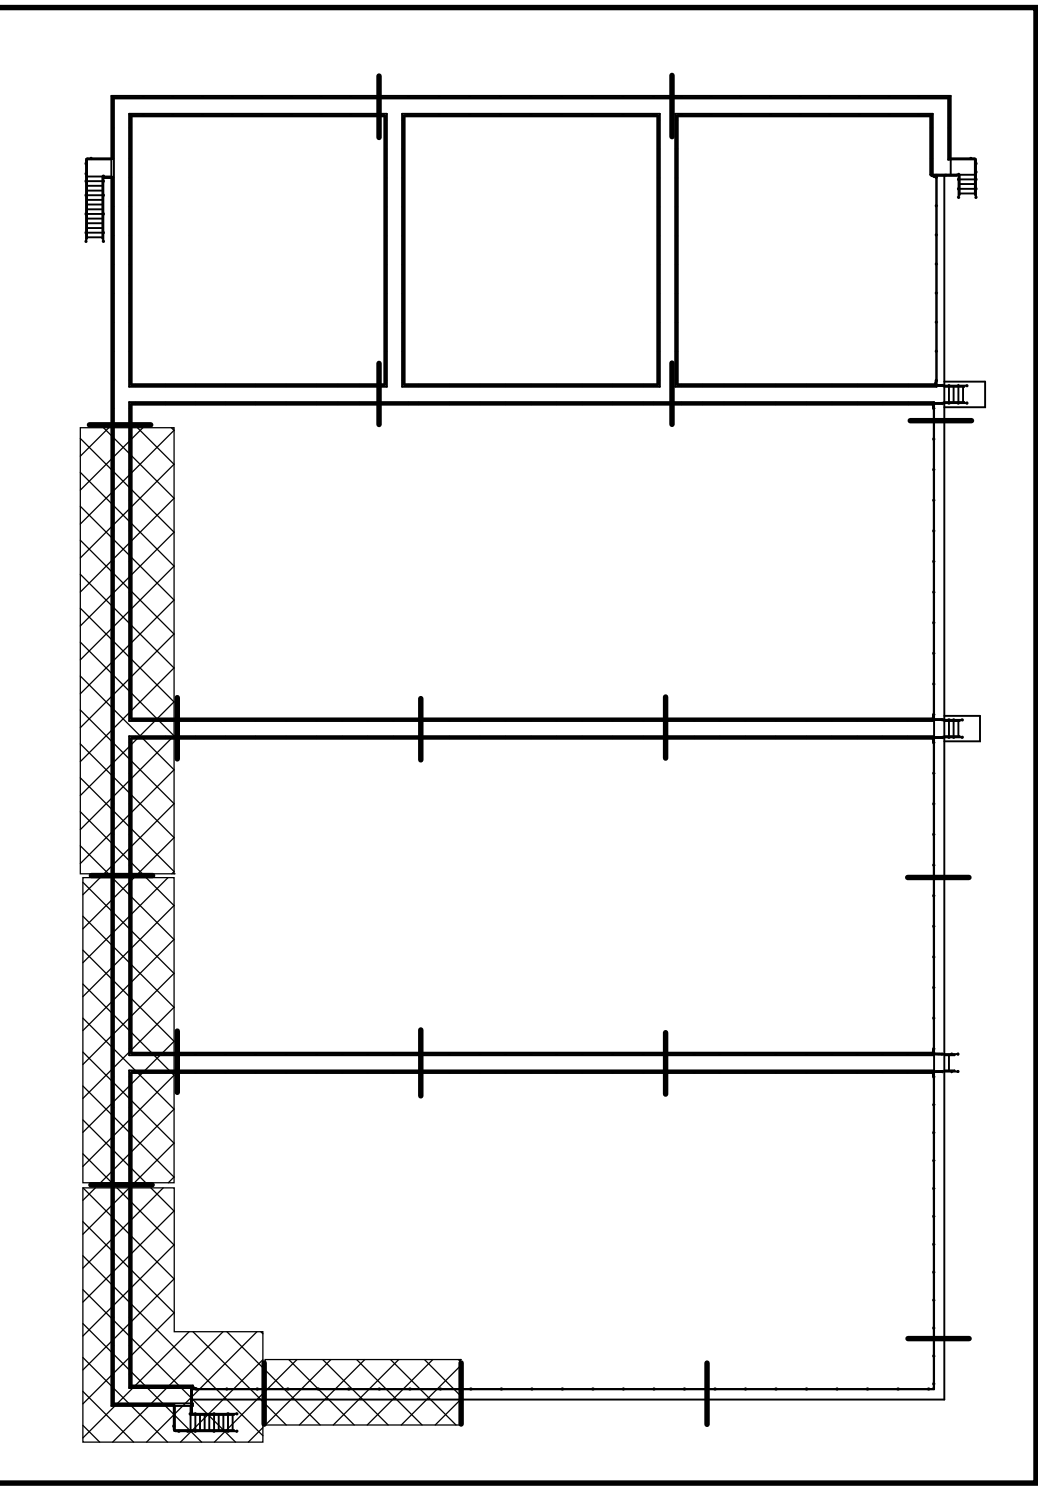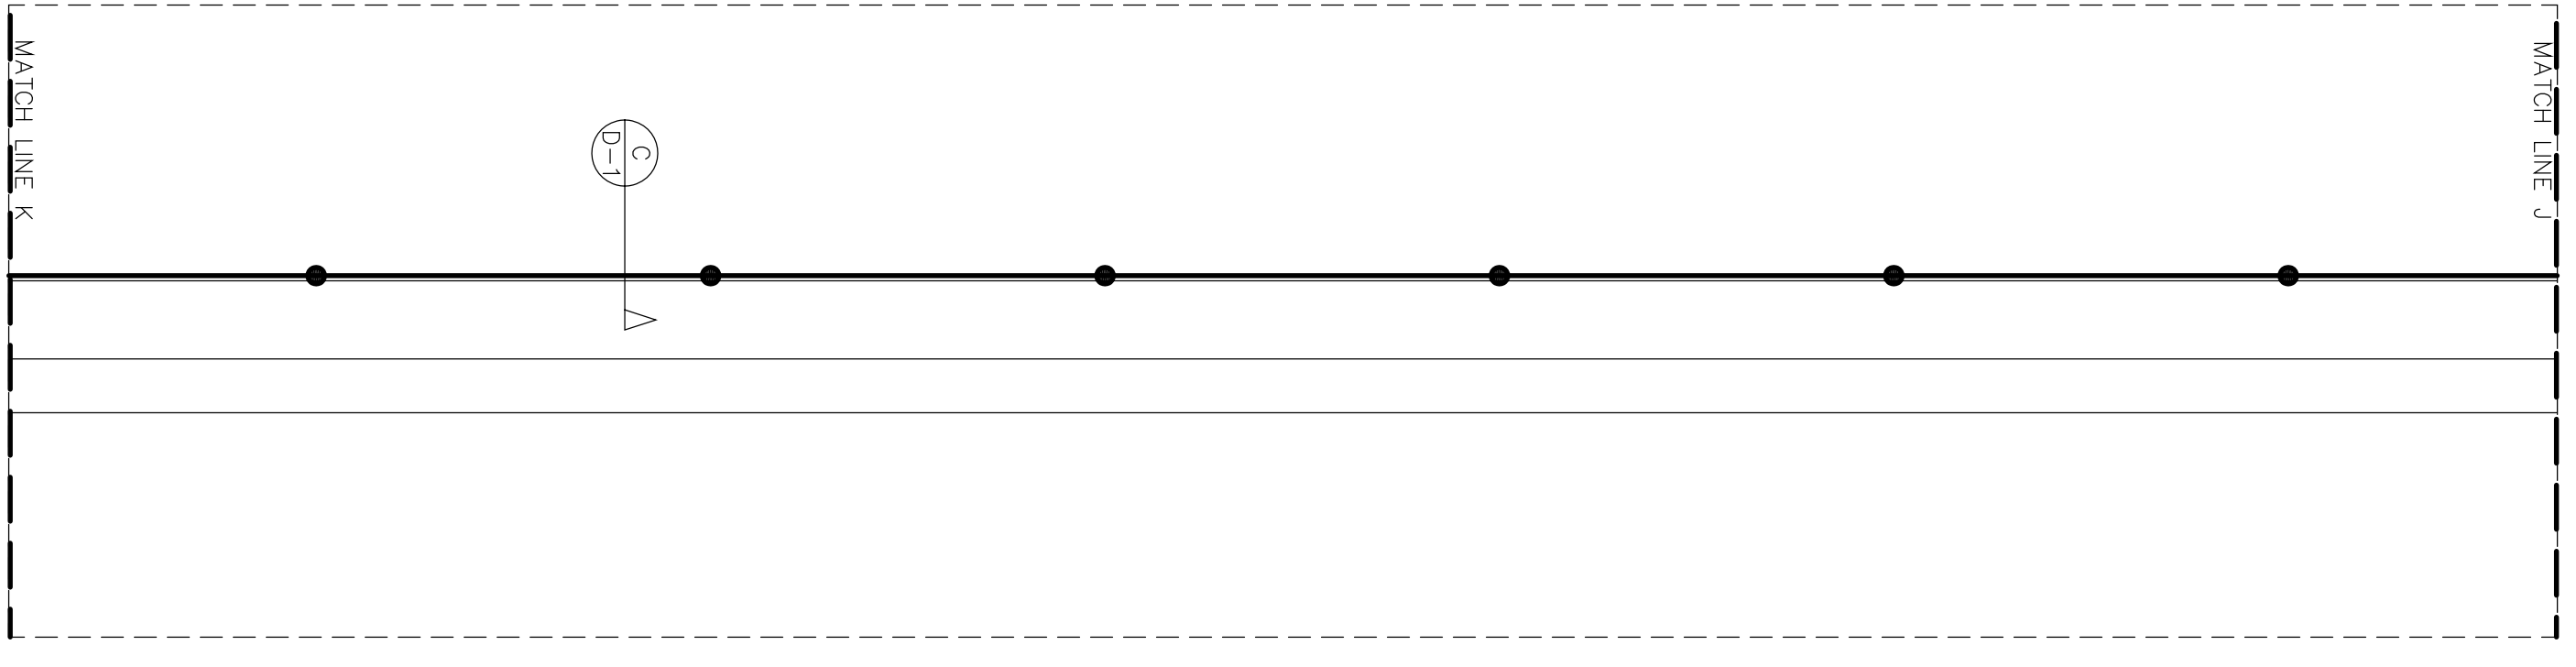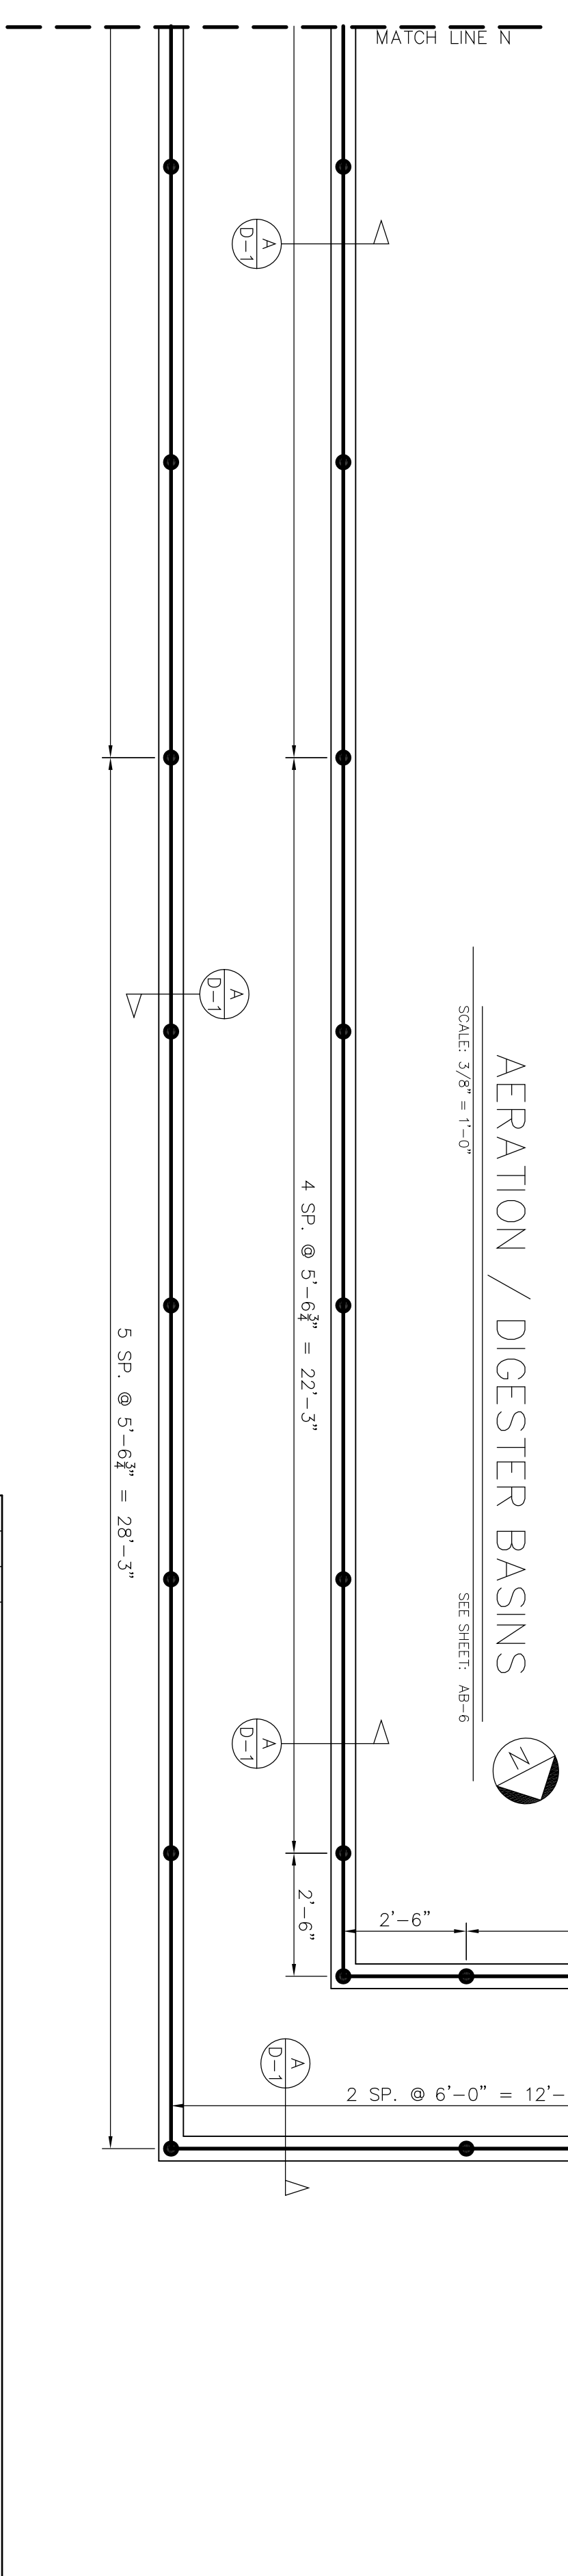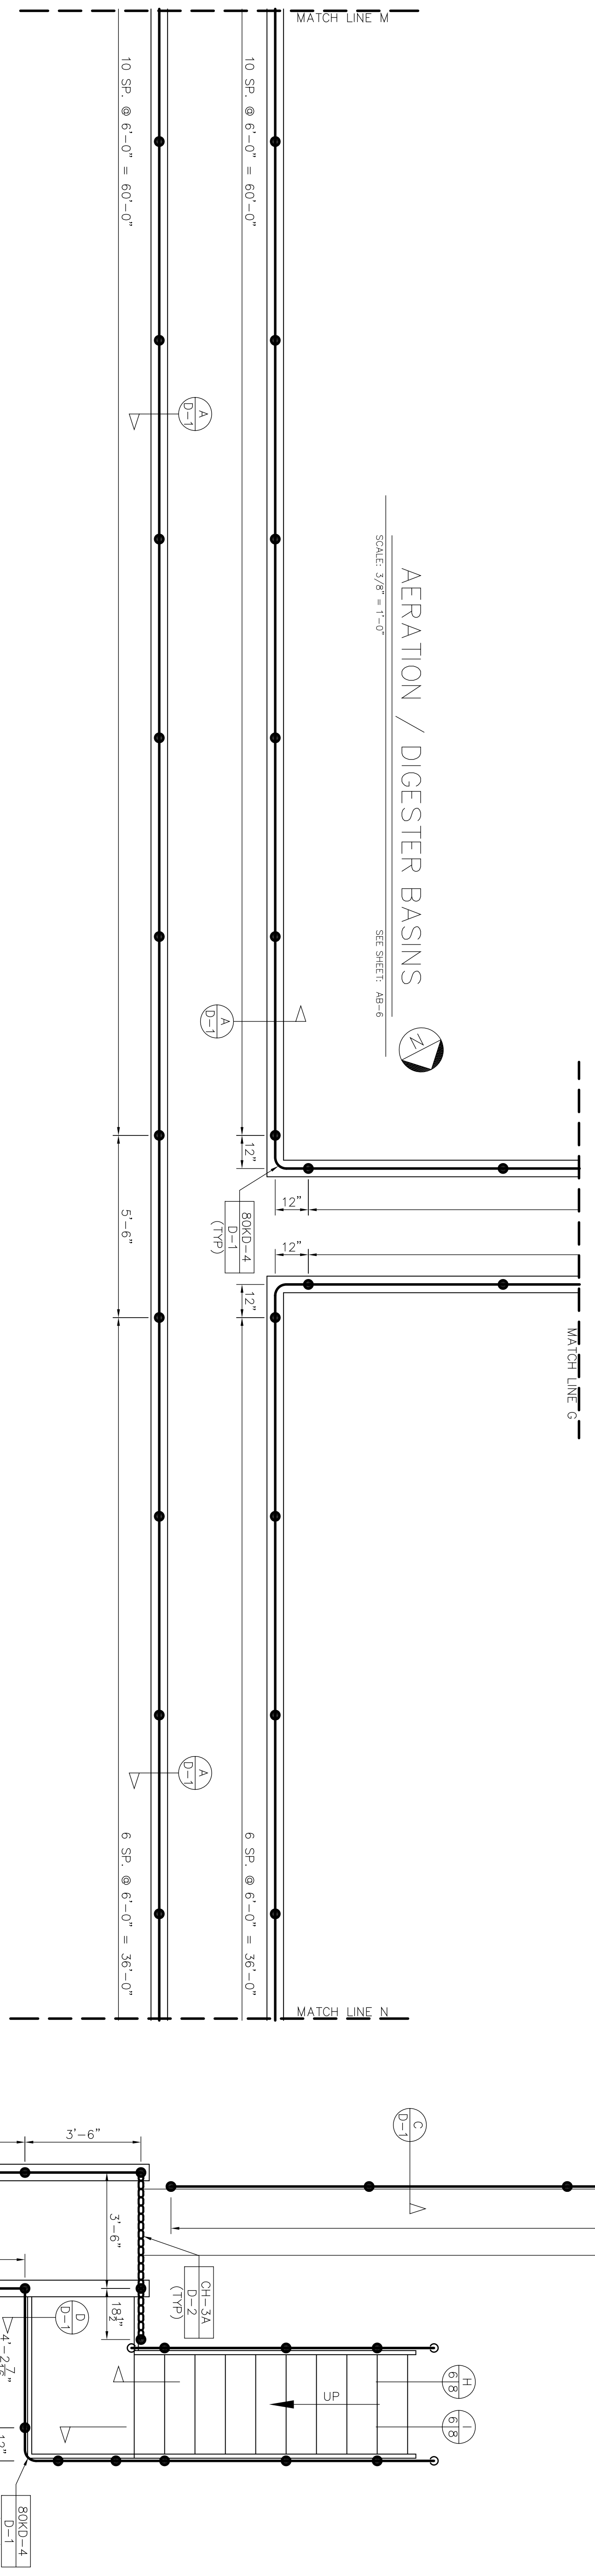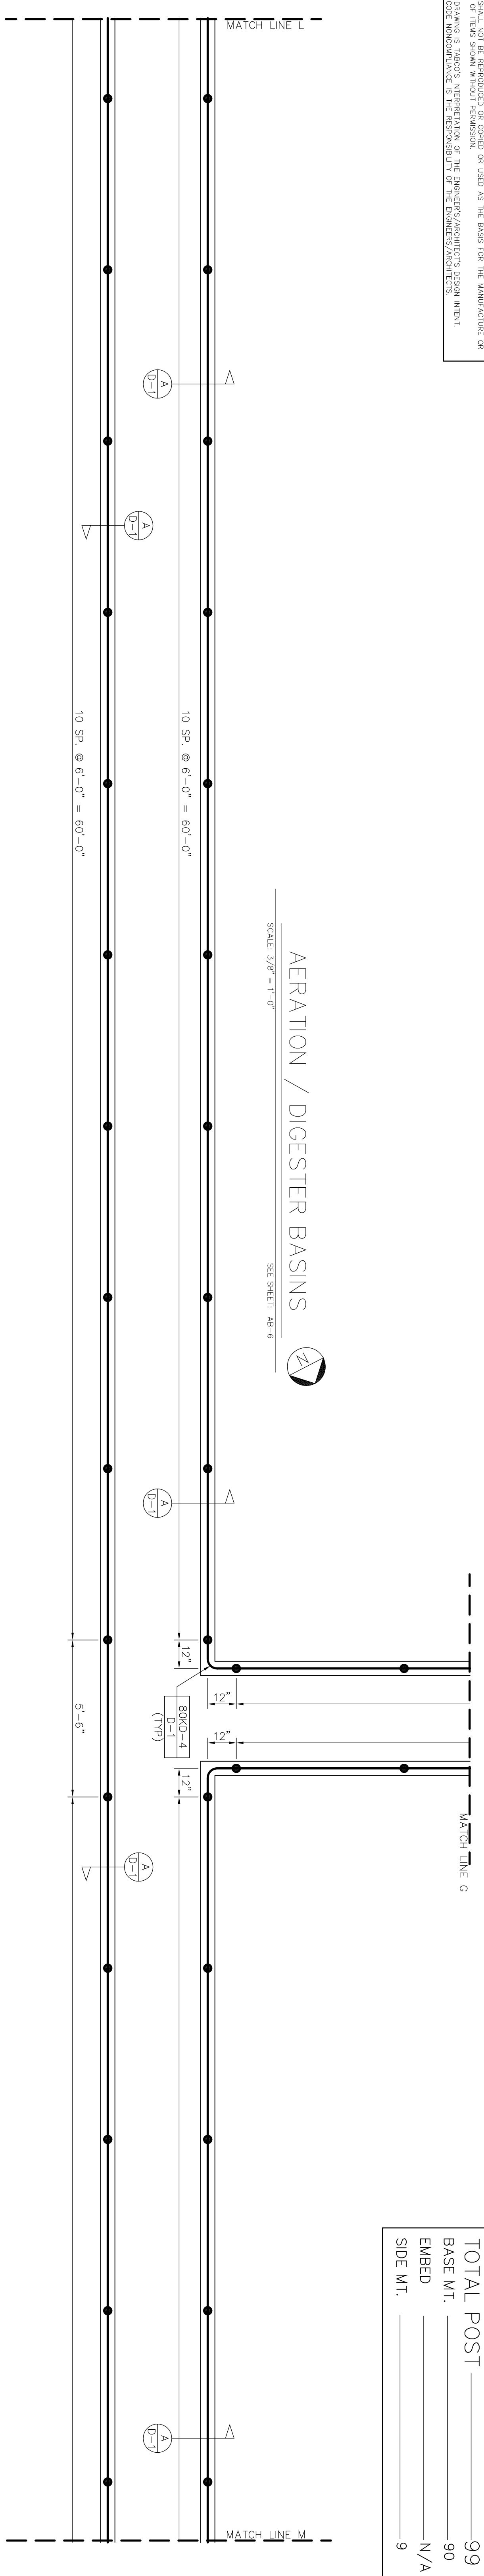

ROCKY MOUNTAIN RAILINGS
11839 E. 51st AVE DENVER, CO 80239
HAROLD D. THOMPSON W.R.F.
FOUNTAIN CO.
CUSTOMER: WEAYER CONSTRUCTION

GSM, INC.
11839 E. 51st AVE DENVER, CO 80239
PHONE: (303) 432-0003 FAX: (303) 432-2038


DATE	BY	REVISION
		1. LTP

NO.	DATE	APPROVAL
1	11/16/11	AS
2		NOTED


JOB NO. R2027
DRAWING NO. 6

REFER TO CONTACT DWG. _____ DWG. NO. _____


THESE DRAWINGS ARE THE PROPERTY OF TITLE ALUMINUM & RESIN INC. THESE DRAWINGS AND SHALL NOT BE REPRODUCED OR COPIED OR USED AS THE BASIS FOR THE MANUFACTURE OF ANY OTHER THING WITHOUT PERMISSION OF THE ENGINEER/ARCHITECT. THE ENGINEER/ARCHITECT DOES NOT ASSUME RESPONSIBILITY FOR THE RESPONSIBILITY OF THE ENGINEER/ARCHITECT.

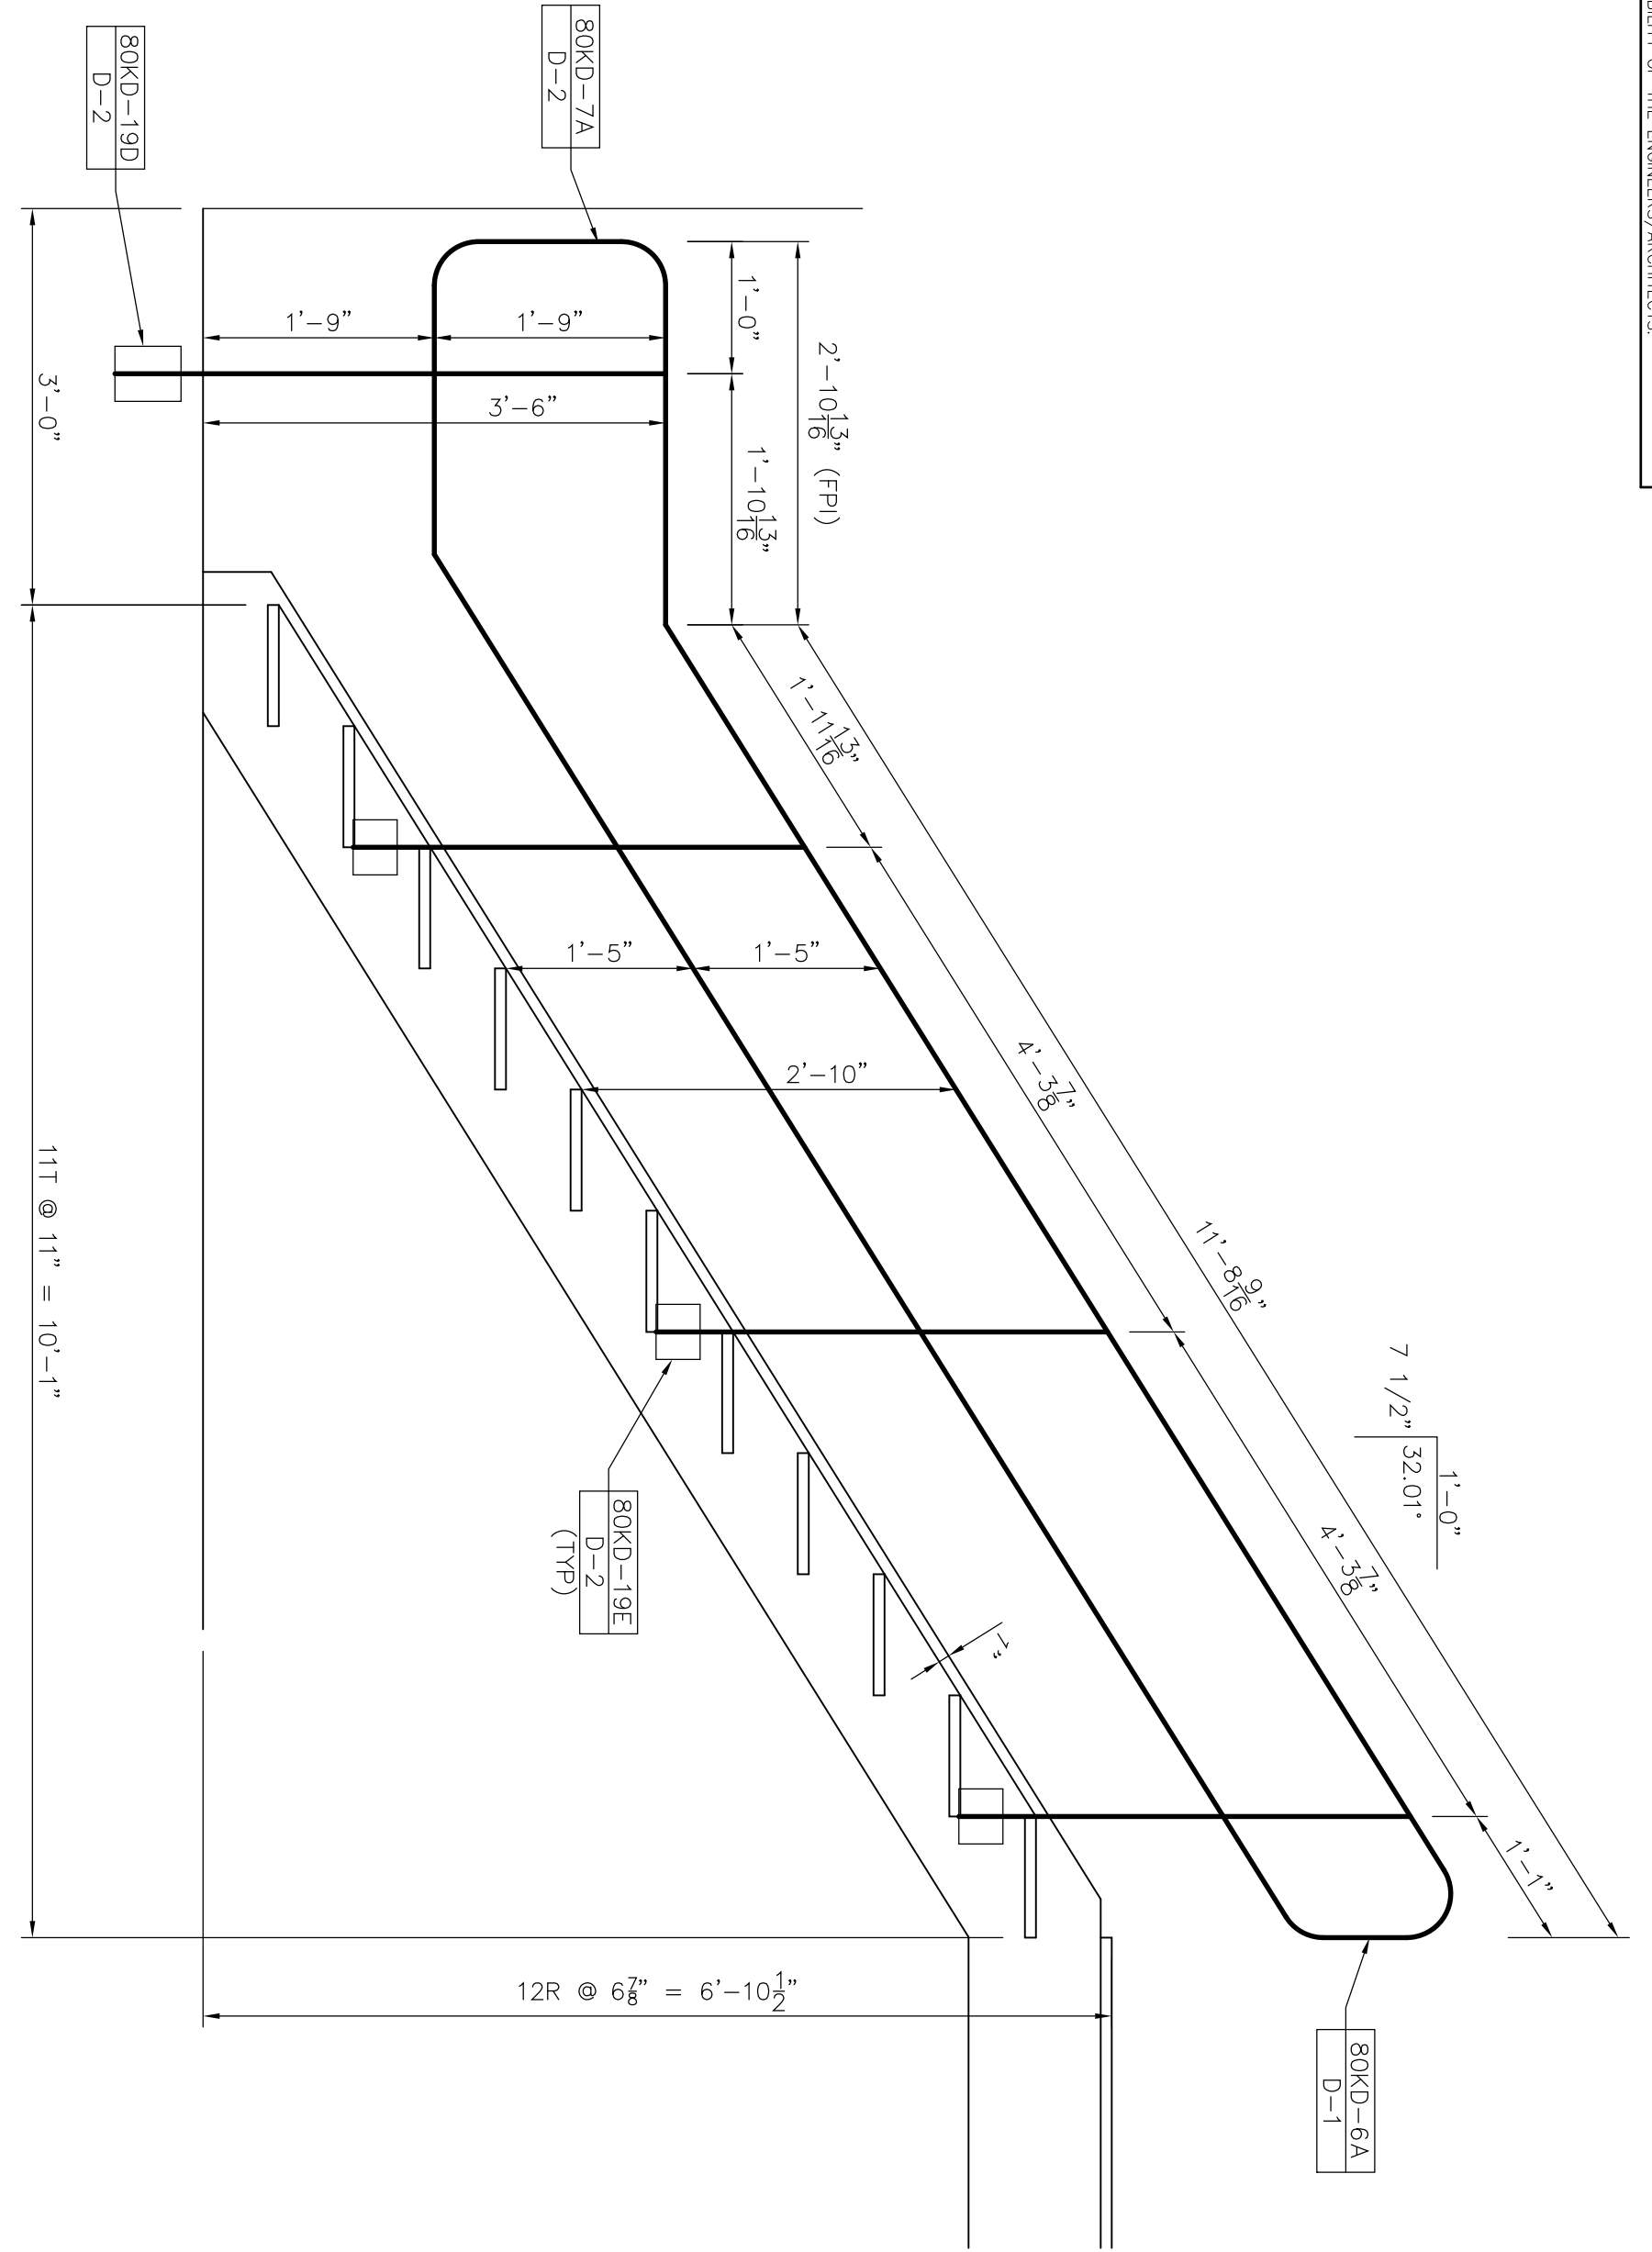


SECTION P
SCALE 3/4" = 1'-0"
9110

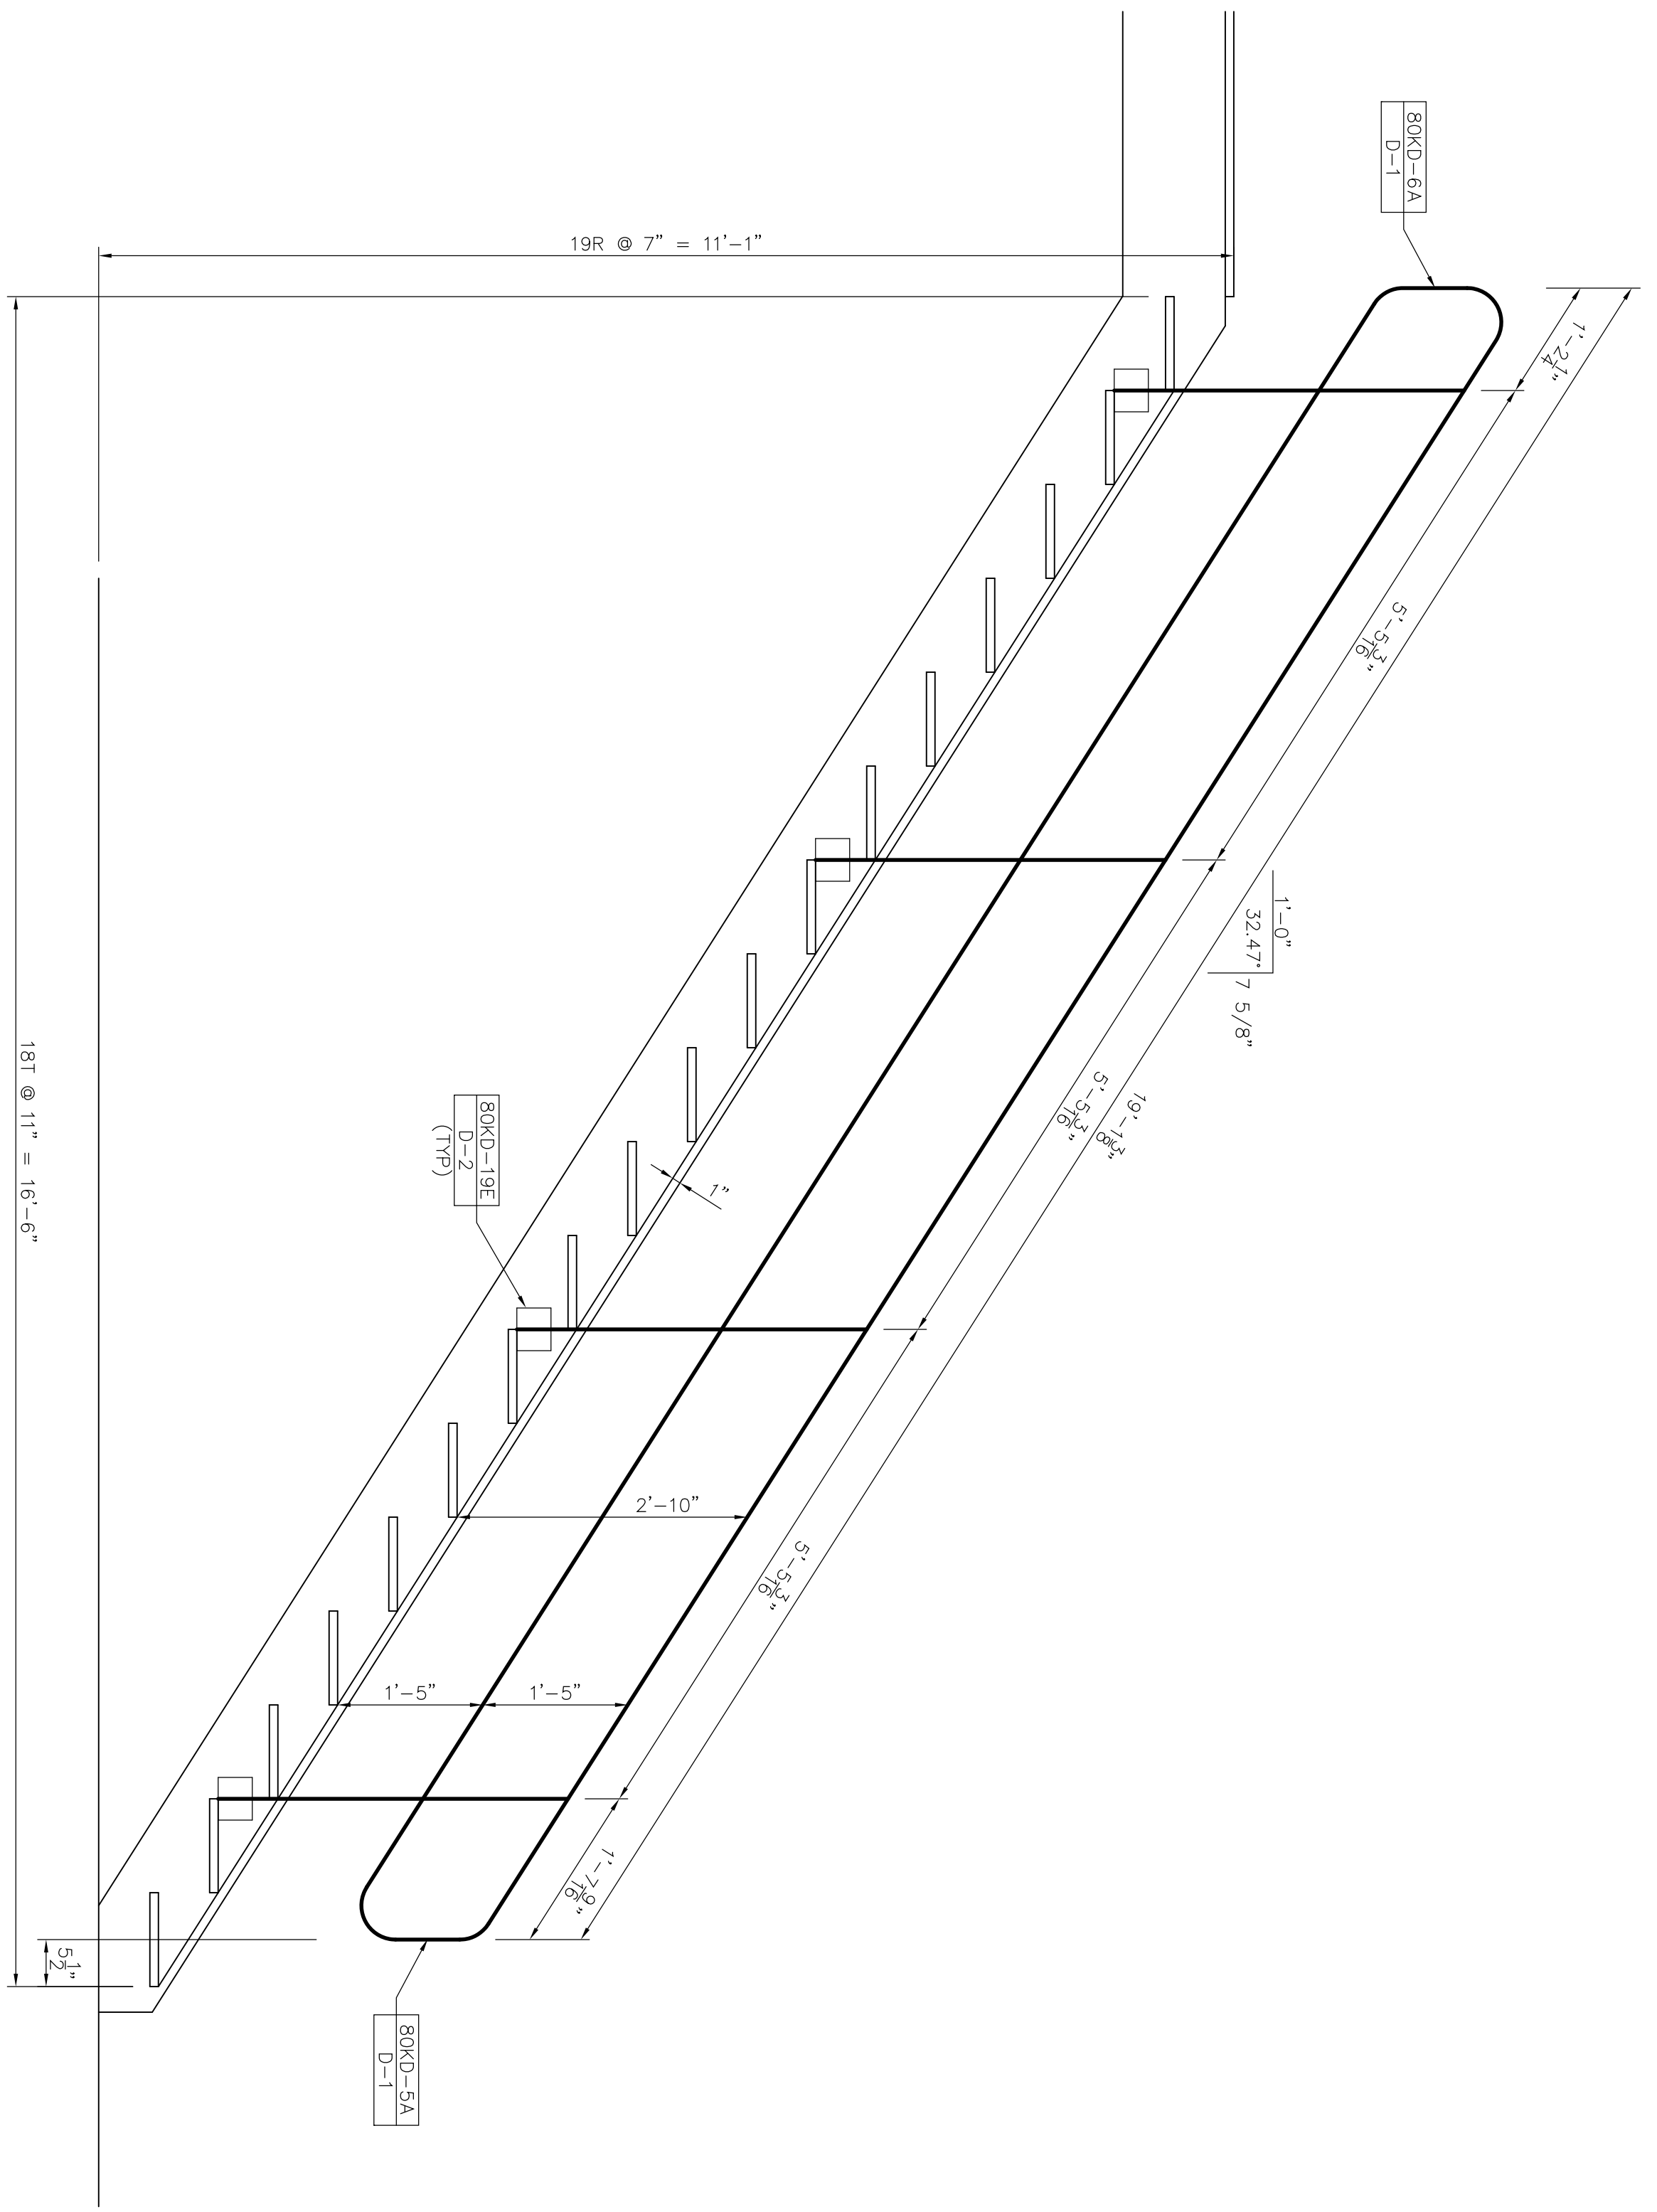

SECTION R
SCALE 3/4" = 1'-0"
9110

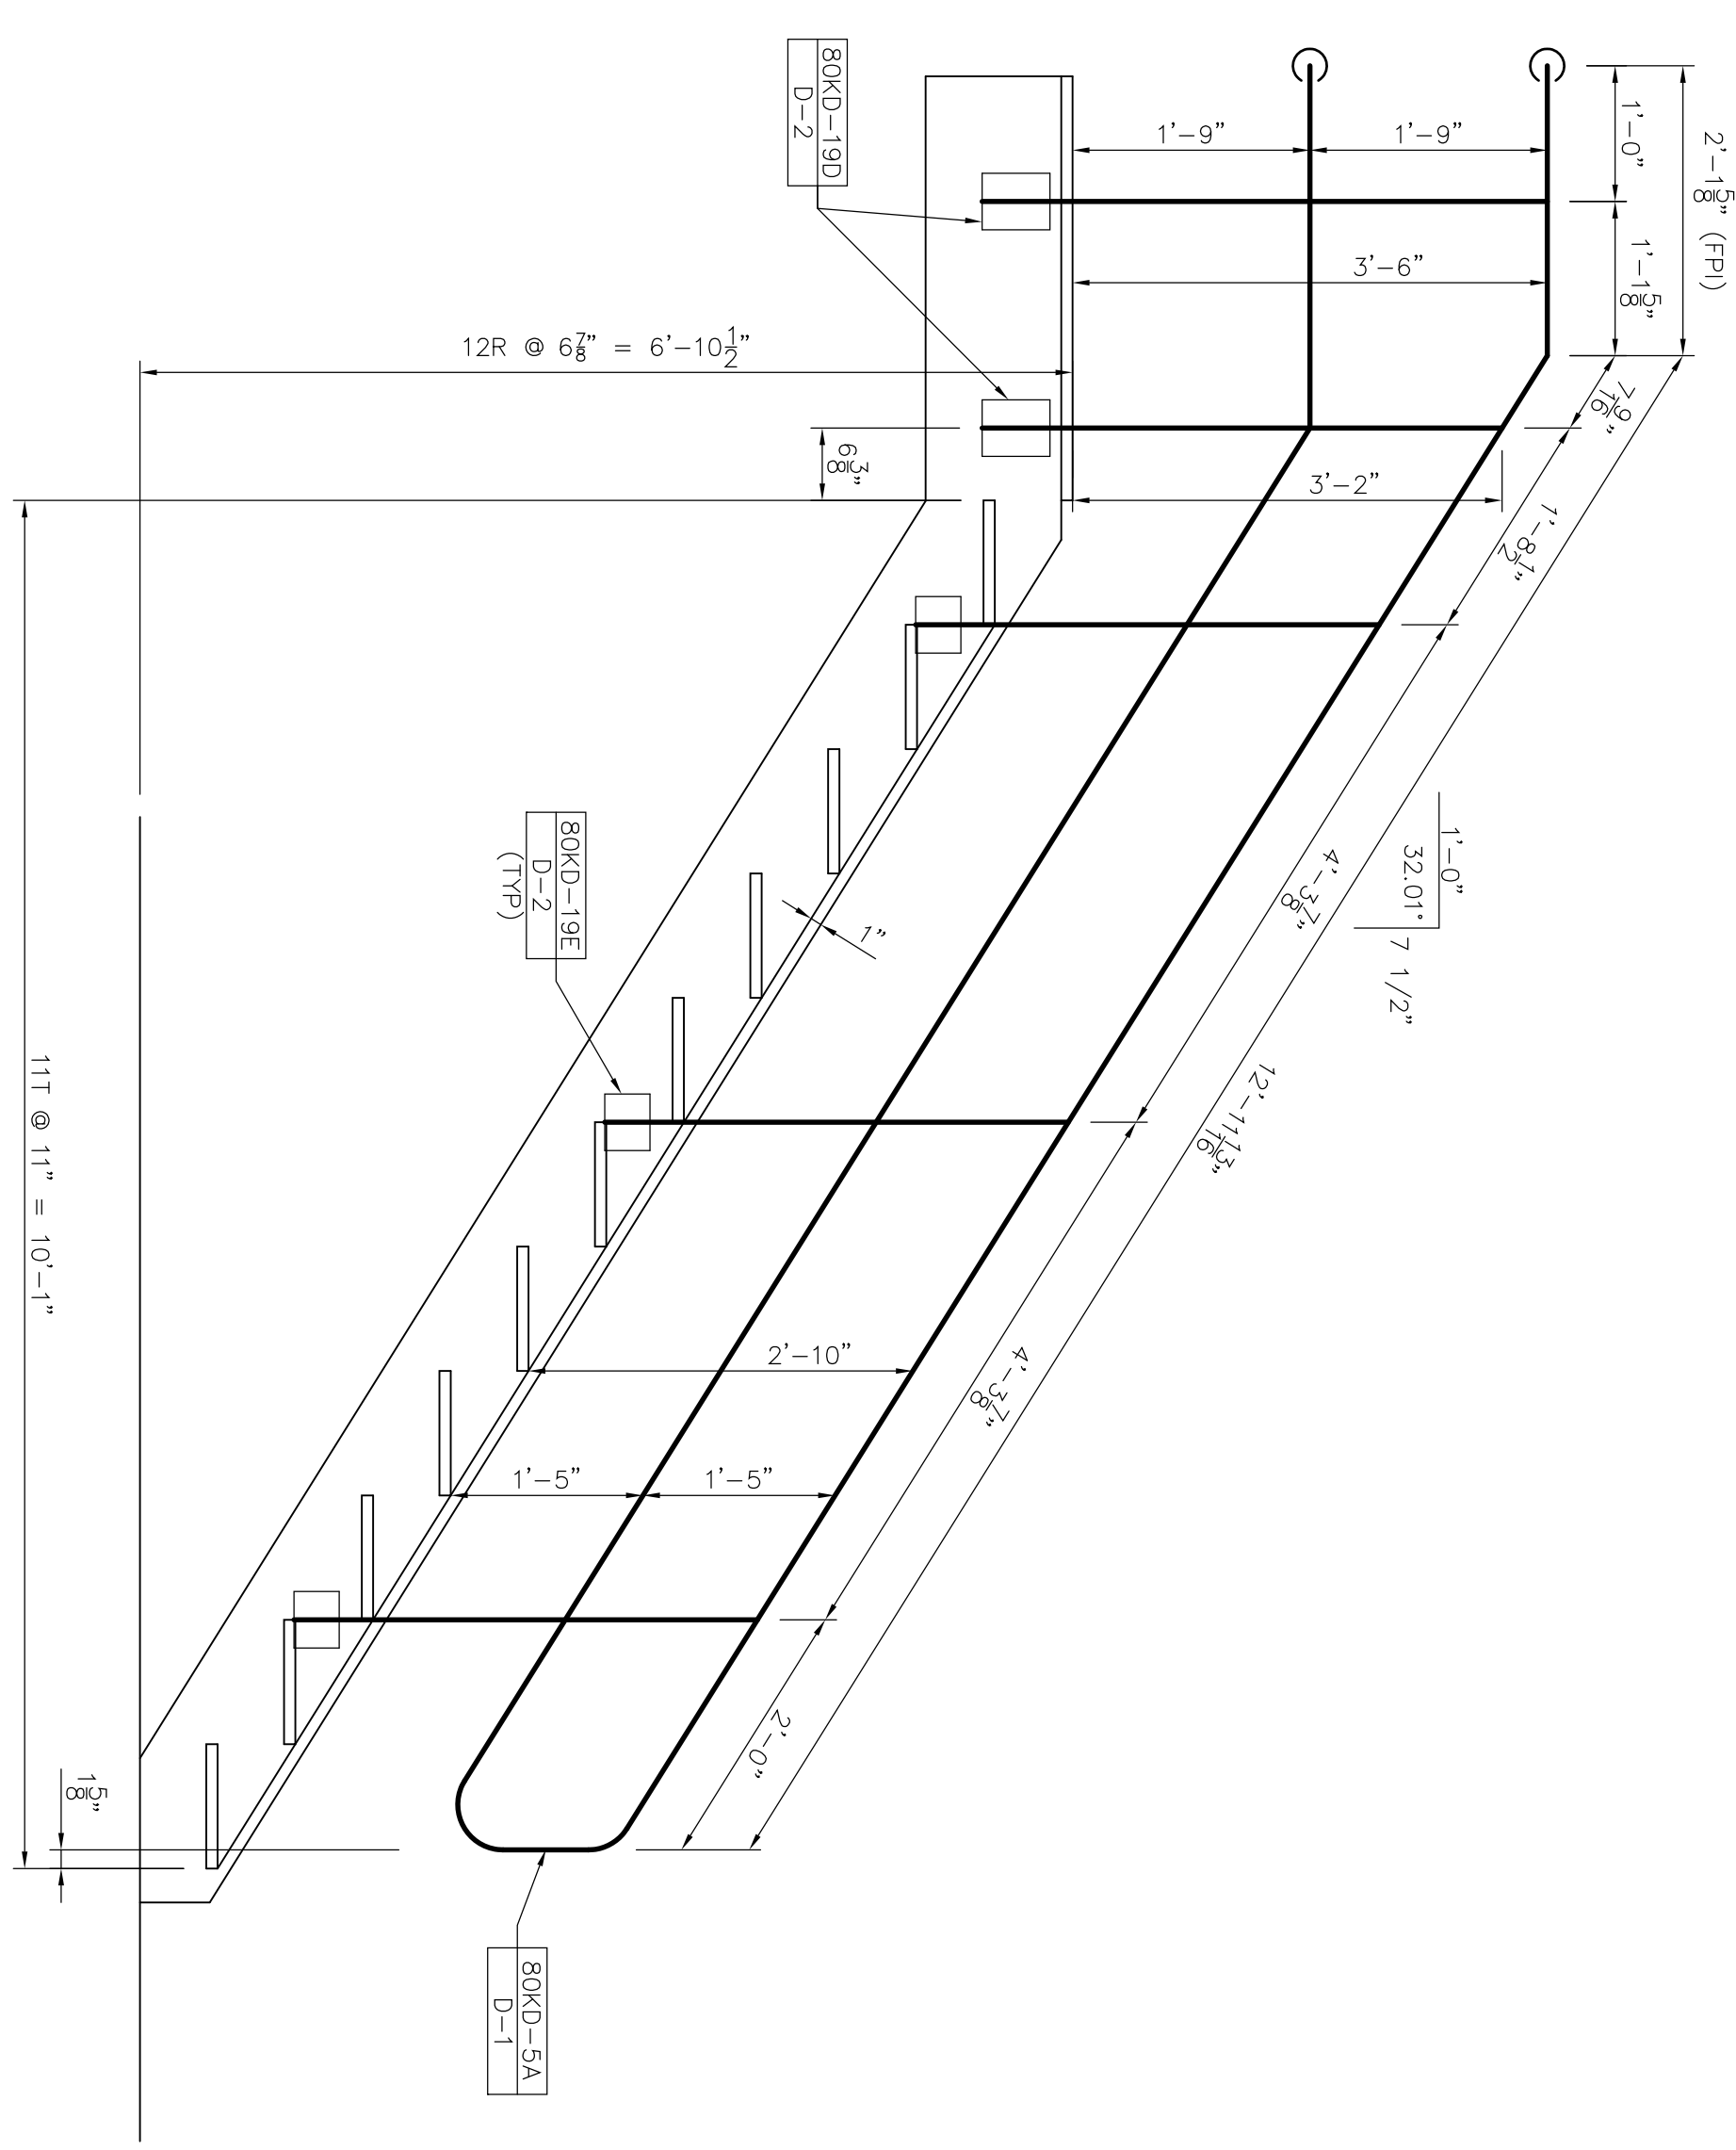

SECTION O
SCALE 3/4" = 1'-0"
9110

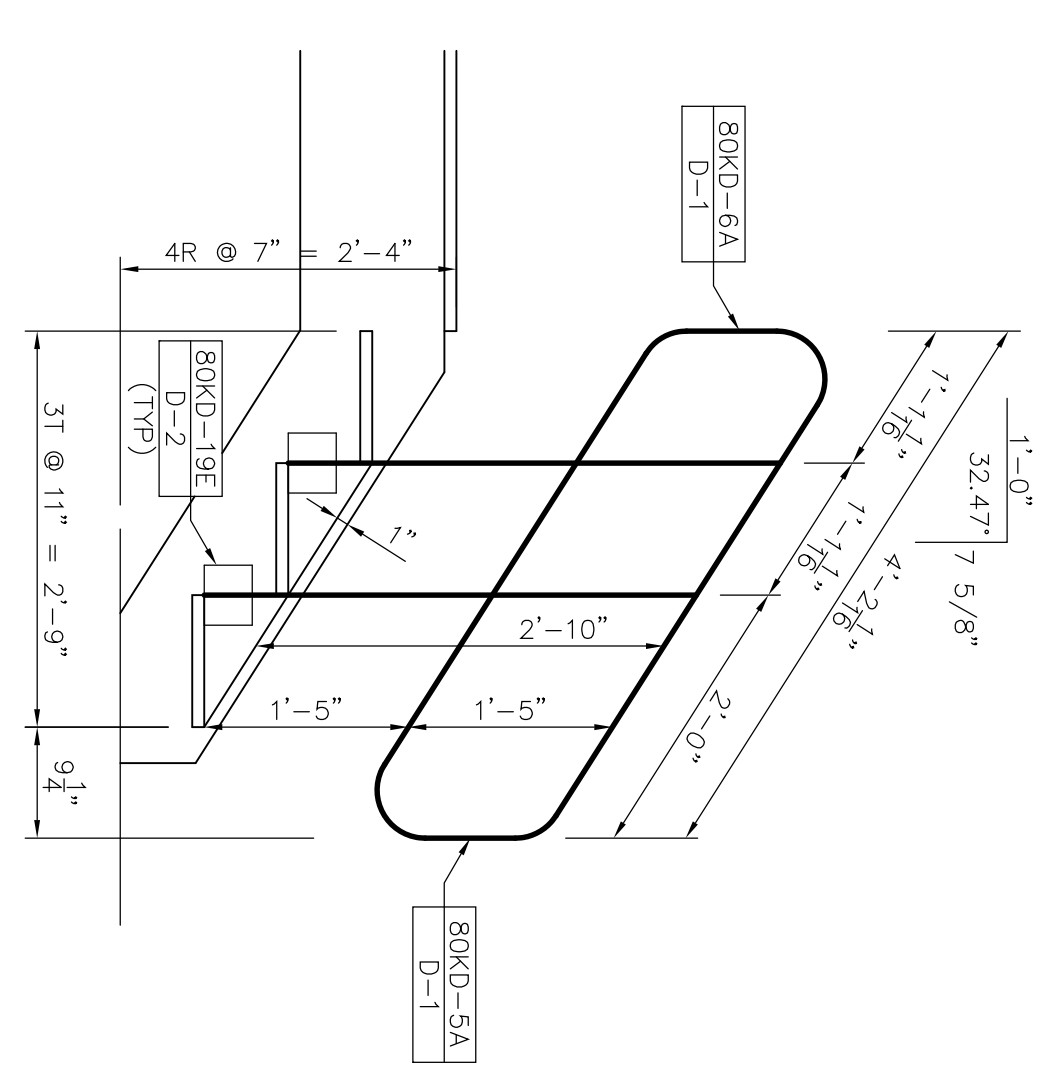

SECTION Q
SCALE 3/4" = 1'-0"
9110

PLEASE PROVIDE APPROVED STRUCTURAL
STEEL DRAWINGS PRIOR TO FABRICATION.



ROCKY MOUNTAIN RAILINGS
11839 E 51st AVE DENVER, CO 80239
HAROLD D. THOMPSON W.R.F.
FOUNTAIN, CO.
PHONE (303) 432-0003 FAX (303) 432-2038

REVISION	DATE	BY	DATE
DR. DDB	11/16/11		
FIELD CHECKED BY OTHERS	NOTED		
CUSTOMER P.O./JOB	2908-05470-C.O. #1		
DESIGNER	GSM, INC.	CUSTOMER	WEAYER CONSTRUCTION
DETAILS	STAIR SECTIONS	CONTRACTOR	
FINISH	M10C22A41		
NO.	PRINTS FOR	DATE	JOB NO.
SP	APPROVAL	TH-BCH	R2027
			DRAWING NO.
			10