



# Weaver

CONSTRUCTION MANAGEMENT

3679 S Huron Street, Suite 404 Englewood, Colorado 80110

Phone: (303) 789-4111 FAX: (303) 789-4310

## SUBMITTAL TRANSMITTAL

April 16, 2012

**Submittal No: 05500-015**

PROJECT: **Harold Thompson Regional WRF**  
Birdsall Rd.  
Fountain, CO 80817  
Job No. 2908

ENGINEER: **GMS, Inc.**  
611 No. Weber St., #300  
Colorado Springs, CO 80903  
719-475-2935 Roger Sams

OWNER: **Lower Fountain Metropolitan  
Sewage Disposal District**  
901 S. Santa Fe Ave.  
Fountain, CO 80817  
719-382-5303 James Heckman

CONTRACTOR: **American Fabricators, Inc**  
10290 E. 106th Ave.  
Brighton, Co 80601  
303-296-6223 Chuck Allen  
amerfab@msn.com

SUBJECT: Tread Plates for UV Utility Chase (SD-09)

SPEC SECTION: 05500 - Metal Fabrications

PREVIOUS SUBMISSION DATES:

DEVIATIONS FROM SPEC: \_\_\_ YES x NO

CONTRACTOR'S STAMP: This submittal has been reviewed by Weaver Construction Management and, unless indicated otherwise, has been found to be in conformance with the intent of the contract documents.

Contractor's Stamp:

Engineer's Stamp:

Date: 4/16/12

Reviewed by: Tyler Ammerman

( ) Reviewed Without Comments

(X) Reviewed With Comments

ENGINEER'S

COMMENTS: \_\_\_\_\_



**Project: HDTWRF Project**

**Location: Fountain, CO**






**Supplier: American Fabricators**

**Date: 4/16/12**

**Submittal for: 05500-015 – Tread plates for UV utility chase**

**Submittal Review Comments:**

- 1) Chase will be field measured for accurate fitment prior to fabrication.**
- 2) Hand holes will be smooth enough so as not to injure operators when removal is necessary.**
- 3) Sections at either end will have HSS at very end to ensure they are supported.**

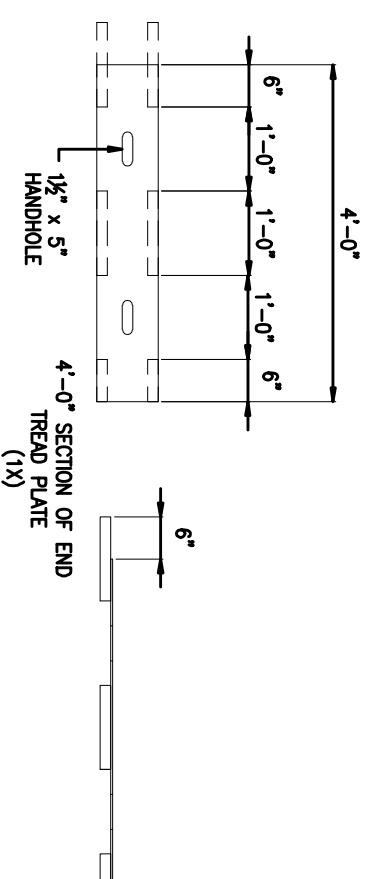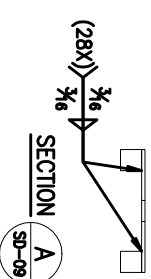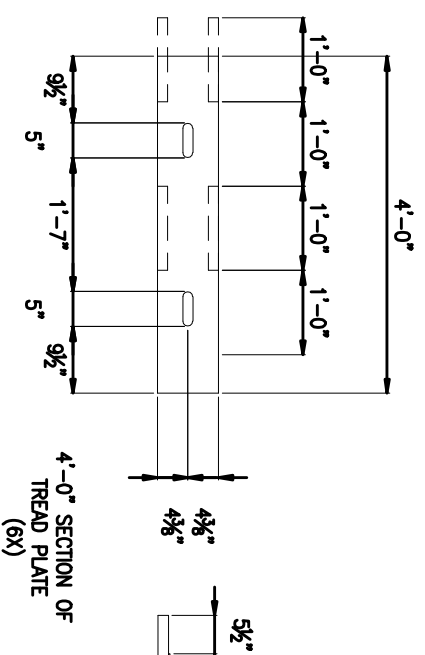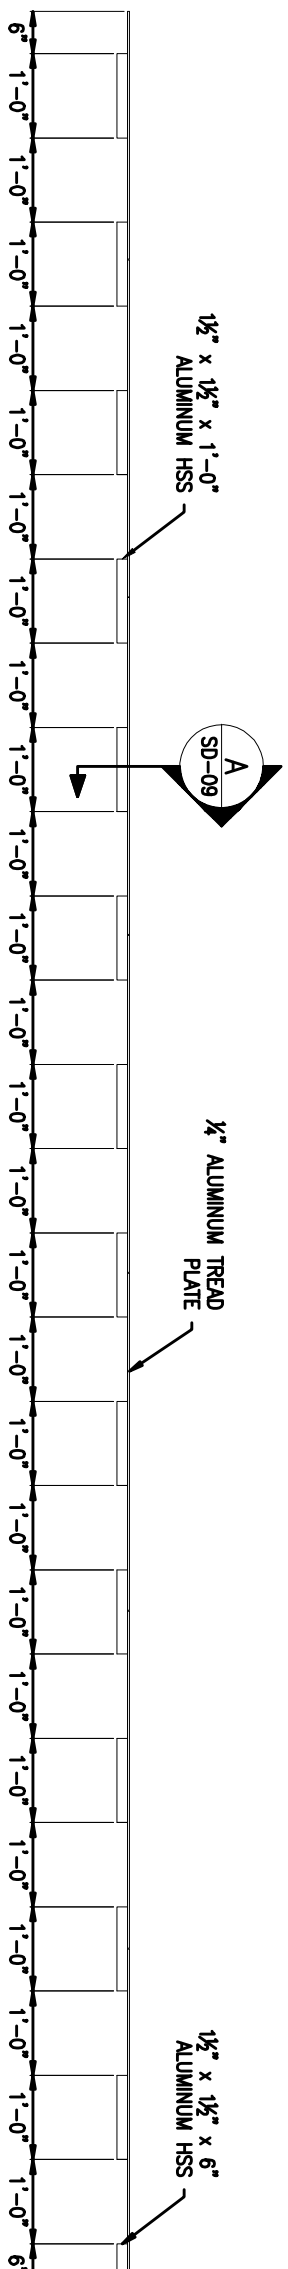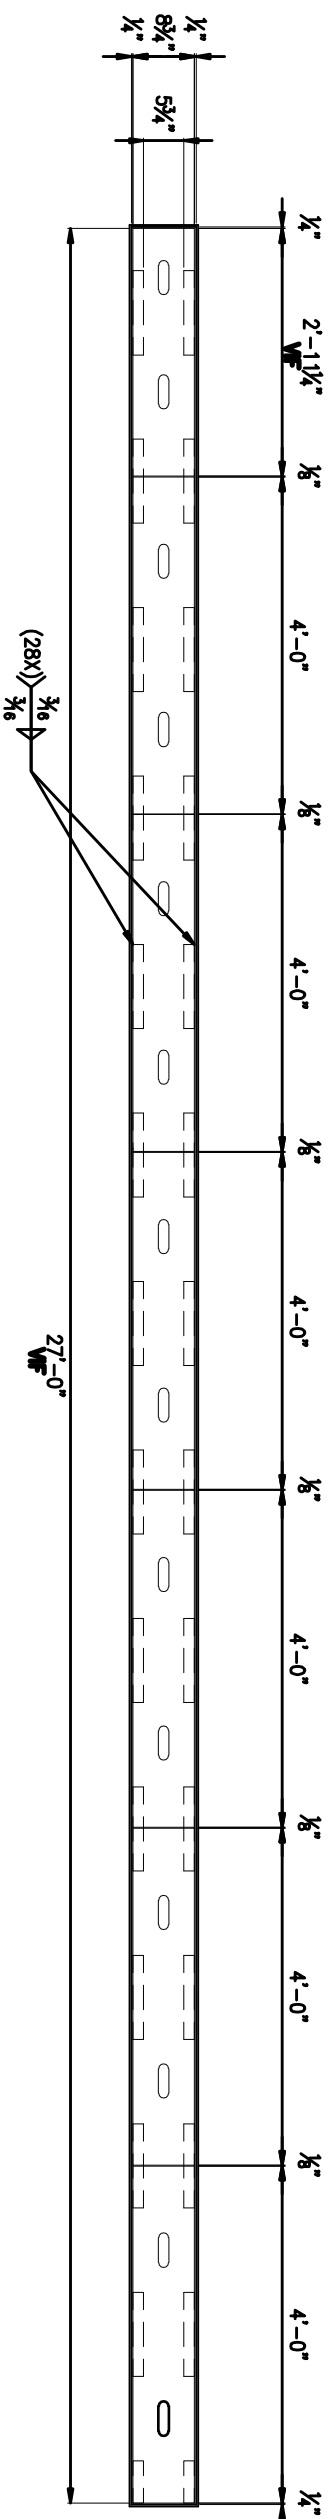

NOTE:

1. **FIELD VERIFICATION IS REQUIRED.**

**1 1/4" Aluminum Tread Plate**

CONTRACTOR:  
**Weaver General Construction Co.**  
 3679 S. Huron St. Suite 404  
 Englewood, CO 80110  
 Ph: (303)769-4111 / Fx: (303)769-4310

FABRICATOR:  
**Anderson Fabricators**  
 1400 E. 140th Ave.  
 Englewood, Colorado 80150  
 Ph: (303)769-4310 / Fx: (303)769-4310

PROJECT: **HD Thompson Charge Order**  
 TITLE: **Tread Plate**

Revision:	DATE:	CHK. BY:	REQ
1. Changed HSS position per email by Tyler A.	04-11-12		
2. Added HSS position per email by Tyler A.	04-12-12		
3. Added section view of 4" Tread Plate			
4. -			
5. -			

DWG BY: **TPP** CHK BY: **REQ**  
 DATE: **APR 06 2012**  
 SHEET NUMBER: **SD - 09**